WELL ID

KOLAR DOC ID

(785) 296-3565 | K.S.A. 82a-1212 | v2022c

WATER WELL RECORD (WWC-5)

OCATION OF WATER WELL						Original Reco	ord Co	rrection	Chang	je in Wel	l Use
Latitude	Longitude			Section	Township	Range	E		1/4	1/4	1/4
Datum	Elevation			County							
WATER WELL OWNER			WELL	WATER USE		NEAREST	NEAREST SOURCE OF POTENTIAL CONTAMINATION				
Name											
			COMP	LETION							
Business				LETION			from well	l:	Directio from we	·II:	
Address			Depth of completed well:ft.				Source				
] -	-	water encountered	:	description	on:			
******					(2) ft.;		Source:				
Well location			(3)	ft.; ((4) dry well		Distance	ı.	Directio from we	n 11.	
at owner's			Static	water level	in well:	ft.	Source	l÷	110111 we	11;	
address			m	easured belo	ow land surface	description	on:				
CONCEDUCTION			on	(mm/dd/y	y):		No no	tantial source	a of contami	ination	
CONSTRUCTION	D 1 1 1			measured above land surface			No potential source of contamination within 100 feet.				
	orehole interval: Borehole diameter:		on (mm/dd/yy):				PERMIT & ID NUMBERS (AS REQUIRED)				
fromtoft.		in.	Estim	ated yield: _	gpm						
fromto ft.		in.	Water	level was:	ft. after	hours	1 -	-	:		
Casing height above land surf	face:	in.			pumping	gpm	KDHE /	EPA Project (Code:		
If casing height is less that			Pump installed? Yes No				Site Name:				
has a variance been appro	T17.					KDHE UIC Class V Form Completed: Yes N					
*variance not required for environmental remed	Water well disinfected? Yes No Date disinfected (mm/dd/yy):				County Permit: Yes No Permit ID:						
Casing type:	lation wens		Date	disinfected (mm/dd/yy):		I				
Blank casing interval:	ft. to	ft.	Aquif	er, if known	:		# of borel	noles:	# of dewate	ring wells:	
Blank casing diameter:			LITHO	LOGIC LOG	i						
Casing joints:			FROI	м то	LITHOLOGY	NTERVALS					
Weight: lbs/											
Wall thickness or gauge n											
Blank casing interval:											
Blank casing diameter:											
Casing joints:											
Weight: lbs/	ft.										
Wall thickness or gauge n	10.:										
Court interval 6 to											
Grout interval: ft. to_											
Grout material: ft. to											
			COMM	IENTS							
Grout material:											
Screen / perforation material:											
Screen / perforation material:			CONT	RACTOR'S	OR LANDOWNER	S CERTIFICATION	N				
Screen / perforation openings								numouset t-	the stated -	vatar 11	
From ft. to					was constructe			•	the stated v		
					ense and was con	=		-			
Slot size unit _ From ft. to					knowledge and b						
					ness name of						
Slot size unit _			Kans	as Water V	Vell Contractor's	License No	u	nder the au	thority of th	ne designa	ated
Gravel pack intervals:	Cmarcel et		perso	on as defin	ed in K.A.R. 28-	30-2(j) and sign	ed and certi	fied by the e	electronic si	gnature o	f the
Gravel pack not used:		in	^		on at its submitt	,					
From ft. to	_				VATER WELL OW	<u> </u>	ne for your red	ords. Fee of 9	5 00 for each	constructe	d well
Gravel pack not used:		in	Jena O	copy to v		EPARTMENT OF	•			constituent	a men
From ft. to	_ tt.			Bureau	of Water, Geology					2-1367	

DENNIS L HANDKE

1820 NW 59th Terrace TOPEKA, KANSAS 66618 785-286-4047 Home

Jess Chapman Larsen & Associates 1311 E. 25th Street, Suite B Lawrence, Kansas, 66046 March 17, 2024

RE: Monitor Well Elevation Survey 2754 U.S. Hwy 75, Lebo, Kansas

Proj. 24-00L Total Truck Stop U3-016-12135

Bench Mark: Square cut on South end of center pump island on south side of the building at the job site.

Elev: 1121.34		North 269	3.00 West	166.43	(from SE Cor. Sec. 3-19-15E)
MW-7	rim	1117.81	North	2673.65	SW1/4,SE1/4,SE1/4,NE1/4
	top pipe	1117.36	West	366.39	Lat= 38.42690 Long = 95.73014
MW-8	rim	1120.91	North	2872.08	SE1/4,SE1/4,SE1/4,NE1/4
	top pipe	1120.53	West	144.24	Lat= 38.42745 Long = 95.72937


Lat & Long derived from Waverly NW 7.5 quad map. WGS84.

Elevation established from existing project. NAVD 88

If you have any questions, please feel free to call me. Thank you for the opportunity to be

Dennis L Handke RL

SURVEY

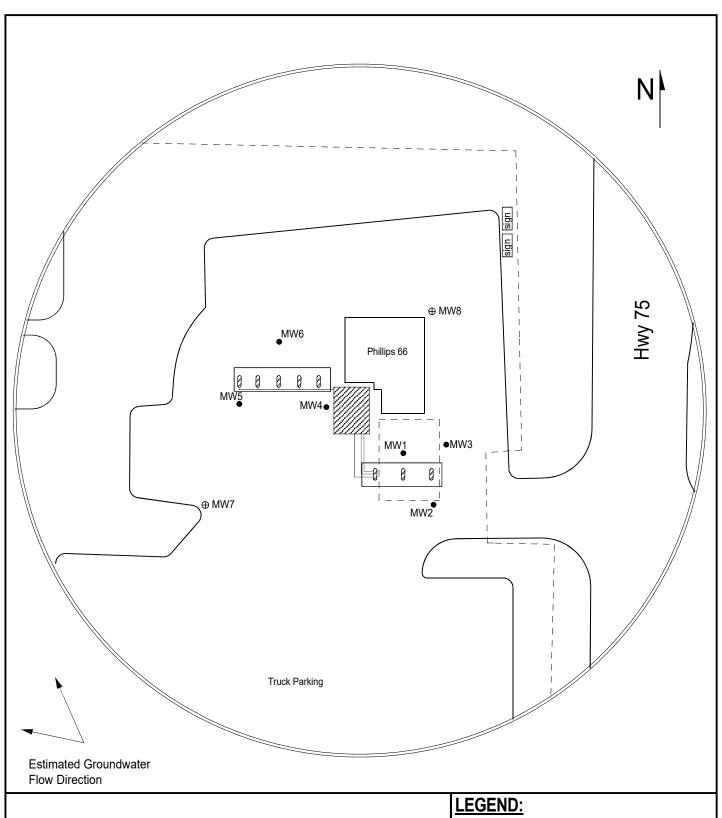



1311 E 25th St. Suite B Lawrence, KS 66046 785-841-8707 office

PROJECT:

Total Truck Stop 2754 U.S Hwy 75, Lebo, KS

KDHE ID: U3-016-12135

Date: 3/6/24

100 ft

- Approximate Location of Active UST Basin, Product Lines & Pump Islands
- ☐☐ Approximate Area of Old Release
 —— Approximate Location of Property Line
- Existing Monitoring Well
- ⊕ New Monitoring Well (Drilled 3/4/24)