

**WATER WELL RECORD (WWC-5)**

KOLAR DOC ID \_\_\_\_\_ WELL ID \_\_\_\_\_  
 Original Record      Correction      Change in Well Use

**LOCATION OF WATER WELL**

Latitude		Longitude		Section		Township		Range		E W	Fraction	¼	¼	¼
Datum		Elevation		County										

**WATER WELL OWNER**

Name	
Business	
Address	
Well location  at owner's address	

**WELL WATER USE**

--

**COMPLETION**

Depth of completed well: _____ ft.
Depth(s) groundwater encountered: (1) _____ ft.; (2) _____ ft.; (3) _____ ft.; (4) dry well
Static water level in well: _____ ft. measured below land surface on (mm/dd/yy): _____ measured above land surface on (mm/dd/yy): _____
Estimated yield: _____ gpm
Water level was: _____ ft. after _____ hours pumping _____ gpm
Pump installed?    Yes    No
Water well disinfected?    Yes    No
Date disinfected (mm/dd/yy): _____
Aquifer, if known:

**NEAREST SOURCE OF POTENTIAL CONTAMINATION**

Source: _____
Distance from well: _____      Direction from well: _____
Source description: _____
Source: _____
Distance from well: _____      Direction from well: _____
Source description: _____
No potential source of contamination within 100 feet.

**CONSTRUCTION**

Borehole interval: from _____ to _____ ft.	Borehole diameter: _____ in.
from _____ to _____ ft.	_____ in.
Casing height above land surface: _____ in.	
If casing height is less than 12 in. has a variance been approved?*    Yes    No	
*variance not required for monitoring or environmental remediation wells	
Casing type: _____	
Blank casing interval: _____ ft. to _____ ft.	
Blank casing diameter: _____ in.	
Casing joints: _____	
Weight: _____ lbs/ft.	
Wall thickness or gauge no.: _____	
Blank casing interval: _____ ft. to _____ ft.	
Blank casing diameter: _____ in.	
Casing joints: _____	
Weight: _____ lbs/ft.	
Wall thickness or gauge no.: _____	
Grout interval: _____ ft. to _____ ft.	
Grout material: _____	
Grout interval: _____ ft. to _____ ft.	
Grout material: _____	
Screen / perforation material: _____	
Screen / perforation openings: _____	
Screen / perforation intervals: From _____ ft. to _____ ft.	
Slot size _____ unit _____	
From _____ ft. to _____ ft.	
Slot size _____ unit _____	
Gravel pack intervals: Gravel pack not used:    Gravel size _____ in	
From _____ ft. to _____ ft.	
Gravel pack not used:    Gravel size _____ in	
From _____ ft. to _____ ft.	

**PERMIT & ID NUMBERS (AS REQUIRED)**

DWR Application No.: _____
KDHE / EPA Project Code: _____
Site Name: _____
KDHE UIC Class V Form Completed:    Yes    No
County Permit:    Yes    No    Permit ID: _____
Lease Name & Well #: _____
# of boreholes: _____    # of dewatering wells: _____

**LITHOLOGIC LOG**

FROM	TO	LITHOLOGY INTERVALS

**COMMENTS**

--

**CONTRACTOR'S OR LANDOWNERS CERTIFICATION**

This water well was    constructed    reconstructed    pursuant to the stated water well contractor's license and was completed on _____. I certify that this record is true to the best of my knowledge and belief. This water well record was completed on _____ under the business name of _____, Kansas Water Well Contractor's License No. _____ under the authority of the designated person as defined in K.A.R. 28-30-2(j) and signed and certified by the electronic signature of the designated person at its submittal: _____.
---

Send one copy to WATER WELL OWNER and retain one for your records. Fee of \$5.00 for each constructed well.

T:\ENV\Fort\_Riley\FTRI\_KRBCA\_Site\_Locations\2023\AGL\_Lines\Mxd\Figure 2.1\_Area Base Map 350 feet.mxd 10/11/2023 12:24:02 PM




**LEGEND**

- AGL-MW-01 MONITORING WELL (7 LOCATIONS)
- AGL-SB22-01 SOIL BORING (12 LOCATIONS)
- AGL-GT22-01 GEOTECHNICAL SOIL BORING (2 LOCATIONS)
- ➔ DIRECTION OF RIVER FLOW
- OVER HEAD POWER LINE
- - - U.G. PRODUCT LINE (3 FEET)
- - - U.G. WATER LINE (3 FEET)
- ▭ BUILDINGS
- ▭ FORMER DISPENSER ISLANDS
- ▭ FORMER UNDERGROUND STORAGE TANK
- - - FORMER UST AREA
- ▭ SITE BOUNDARY
- 350 FEET RADIUS

**ACRONYMS:**  
 U.G. = UNDERGROUND UTILITIES  
 UST = UNDERGROUND STORAGE TANK

**NOTES:**  
 DEPTHS FOR U.G. UTILITIES NOTED IN FEET BELOW GROUND SURFACE.  
 NO BASEMENTS LOCATED WITHIN 350 FEET OF SITE.  
 ALL PROPERTY IN VIEW OWNED BY FEDERAL GOVERNMENT.

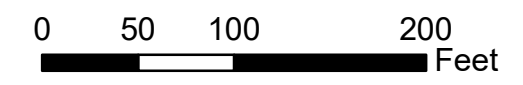

**BLDG. 752, MARSHALL FIELD  
 FT. RILEY  
 U5-031-14288**

**AREA BASE MAP  
 350 FEET**

**FIGURE  
 2.1**