

**WATER WELL RECORD (WWC-5)**

KOLAR DOC ID \_\_\_\_\_ WELL ID \_\_\_\_\_  
 Original Record      Correction      Change in Well Use

**LOCATION OF WATER WELL**

Latitude		Longitude		Section		Township		Range		E W	Fraction		¼		¼		¼
Datum		Elevation		County													

**WATER WELL OWNER**

Name	
Business	
Address	
Well location	
at owner's address	

**WELL WATER USE**

--

**COMPLETION**

Depth of completed well: \_\_\_\_\_ ft.

Depth(s) groundwater encountered:

(1) \_\_\_\_\_ ft.; (2) \_\_\_\_\_ ft.;

(3) \_\_\_\_\_ ft.; (4) dry well

---

Static water level in well: \_\_\_\_\_ ft.

measured below land surface on (mm/dd/yy): \_\_\_\_\_

measured above land surface on (mm/dd/yy): \_\_\_\_\_

---

Estimated yield: \_\_\_\_\_ gpm

Water level was: \_\_\_\_\_ ft. after \_\_\_\_\_ hours pumping \_\_\_\_\_ gpm

Pump installed?    Yes    No

---

Water well disinfected?    Yes    No

Date disinfected (mm/dd/yy): \_\_\_\_\_

---

Aquifer, if known: \_\_\_\_\_

**NEAREST SOURCE OF POTENTIAL CONTAMINATION**

Source: \_\_\_\_\_

Distance from well: \_\_\_\_\_      Direction from well: \_\_\_\_\_

Source description: \_\_\_\_\_

---

Source: \_\_\_\_\_

Distance from well: \_\_\_\_\_      Direction from well: \_\_\_\_\_

Source description: \_\_\_\_\_

---

No potential source of contamination within 100 feet.

**CONSTRUCTION**

Borehole interval: from _____ to _____ ft.	Borehole diameter: _____ in.
from _____ to _____ ft.	_____ in.
Casing height above land surface: _____ in.	
If casing height is less than 12 in. has a variance been approved? *    Yes    No	
*variance not required for monitoring or environmental remediation wells	
Casing type: _____	
Blank casing interval: _____ ft. to _____ ft.	
Blank casing diameter: _____ in.	
Casing joints: _____	
Weight: _____ lbs/ft.	
Wall thickness or gauge no.: _____	
Blank casing interval: _____ ft. to _____ ft.	
Blank casing diameter: _____ in.	
Casing joints: _____	
Weight: _____ lbs/ft.	
Wall thickness or gauge no.: _____	
Grout interval: _____ ft. to _____ ft.	
Grout material: _____	
Grout interval: _____ ft. to _____ ft.	
Grout material: _____	
Screen / perforation material: _____	
Screen / perforation openings: _____	
Screen / perforation intervals:	
From _____ ft. to _____ ft.	
Slot size _____ unit _____	
From _____ ft. to _____ ft.	
Slot size _____ unit _____	
Gravel pack intervals:	
Gravel pack not used:    Gravel size _____ in	
From _____ ft. to _____ ft.	
Gravel pack not used:    Gravel size _____ in	
From _____ ft. to _____ ft.	

**PERMIT & ID NUMBERS (AS REQUIRED)**

DWR Application No.: \_\_\_\_\_

KDHE / EPA Project Code: \_\_\_\_\_

Site Name: \_\_\_\_\_

KDHE UIC Class V Form Completed:    Yes    No

County Permit:    Yes    No    Permit ID: \_\_\_\_\_

Lease Name & Well #: \_\_\_\_\_

# of boreholes: \_\_\_\_\_    # of dewatering wells: \_\_\_\_\_

**LITHOLOGIC LOG**

FROM	TO	LITHOLOGY INTERVALS

**COMMENTS**

--

**CONTRACTOR'S OR LANDOWNERS CERTIFICATION**

This water well was    constructed    reconstructed    pursuant to the stated water well contractor's license and was completed on _____. I certify that this record is true to the best of my knowledge and belief. This water well record was completed on _____ under the business name of _____, Kansas Water Well Contractor's License No. _____ under the authority of the designated person as defined in K.A.R. 28-30-2(j) and signed and certified by the electronic signature of the designated person at its submittal: _____.
---

Send one copy to WATER WELL OWNER and retain one for your records. Fee of \$5.00 for each constructed well.

Form	WWC5.2 - Water Well Record
Doc ID	1774846
Well Owner	Kaw Valley Drainage District
Contractor	Griffin Dewatering, LLC

Casing

From	To	Casing Diameter	Casing Joint	Casing Weigh	Wall Thickness or Gauge Number
0	34	12.75	Splines	49.56	Sch 40
40	47	12.75	Splines	49.56	Sch 40
73	77	12.75	Splines	49.56	Sch 40

Form	WWC5.2 - Water Well Record
Doc ID	1774846
Well Owner	Kaw Valley Drainage District
Contractor	Griffin Dewatering, LLC

#### Lithology

From	To	Lithology Intervals
0	5	fill (man-made material), fine to coarse, clayey, light, brownish, brown, dry, loose, not cemented
5	9	sand, fine, silty, light, brownish, brown, dry, soft, not cemented
9	16	sand, fine, clayey, light, brownish, brown, dry, firm, not cemented
16	20	clay, very fine, sandy, light, brownish, brown, dry, firm, not cemented
20	25	sand, fine, clayey, light, brownish, brown, dry, firm, not cemented
25	30	sand, fine, silty, light, brownish, brown, dry, firm, not cemented
30	34	sand, fine, silty, light, brownish, brown, dry, firm, not cemented
34	46	sand, fine to medium, gravelly, dark, brownish, brown, dry, dense, not cemented
46	48	sand, fine to medium, gravelly, dark, brownish, brown, saturated, dense, not cemented
48	58	sand, fine, clayey, dark, brownish, brown, saturated, dense, not cemented
58	61	sand, coarse, gravelly, dark, brownish, brown, saturated, dense, not cemented

Form	WWC5.2 - Water Well Record
Doc ID	1774846
Well Owner	Kaw Valley Drainage District
Contractor	Griffin Dewatering, LLC

Lithology


From	To	Lithology Intervals
61	69	cobbles, fine to coarse, gravelly, dark, brownish, brown, saturated, dense, not cemented
69	83	sand, fine to coarse, gravelly, dark, brownish, brown, saturated, dense, not cemented
83	86	sand & gravel, fine to coarse, gravelly, dark, brownish, brown, saturated, dense, not cemented

Form	WWC5.2 - Water Well Record
Doc ID	1774846
Well Owner	Kaw Valley Drainage District
Contractor	Griffin Dewatering, LLC

Screen and Gravel

From	To	Slot Size	Slot Size Units	Gravel Pack Used	Gravel Pack From	Gravel Pack To	Gravel Size
34	40	.03	inches	Yes	27	45	.15
47	73	.03	inches	Yes	45	74	.15
77	86	.08	inches	Yes	74	86	.4

**Finished Grade-758**

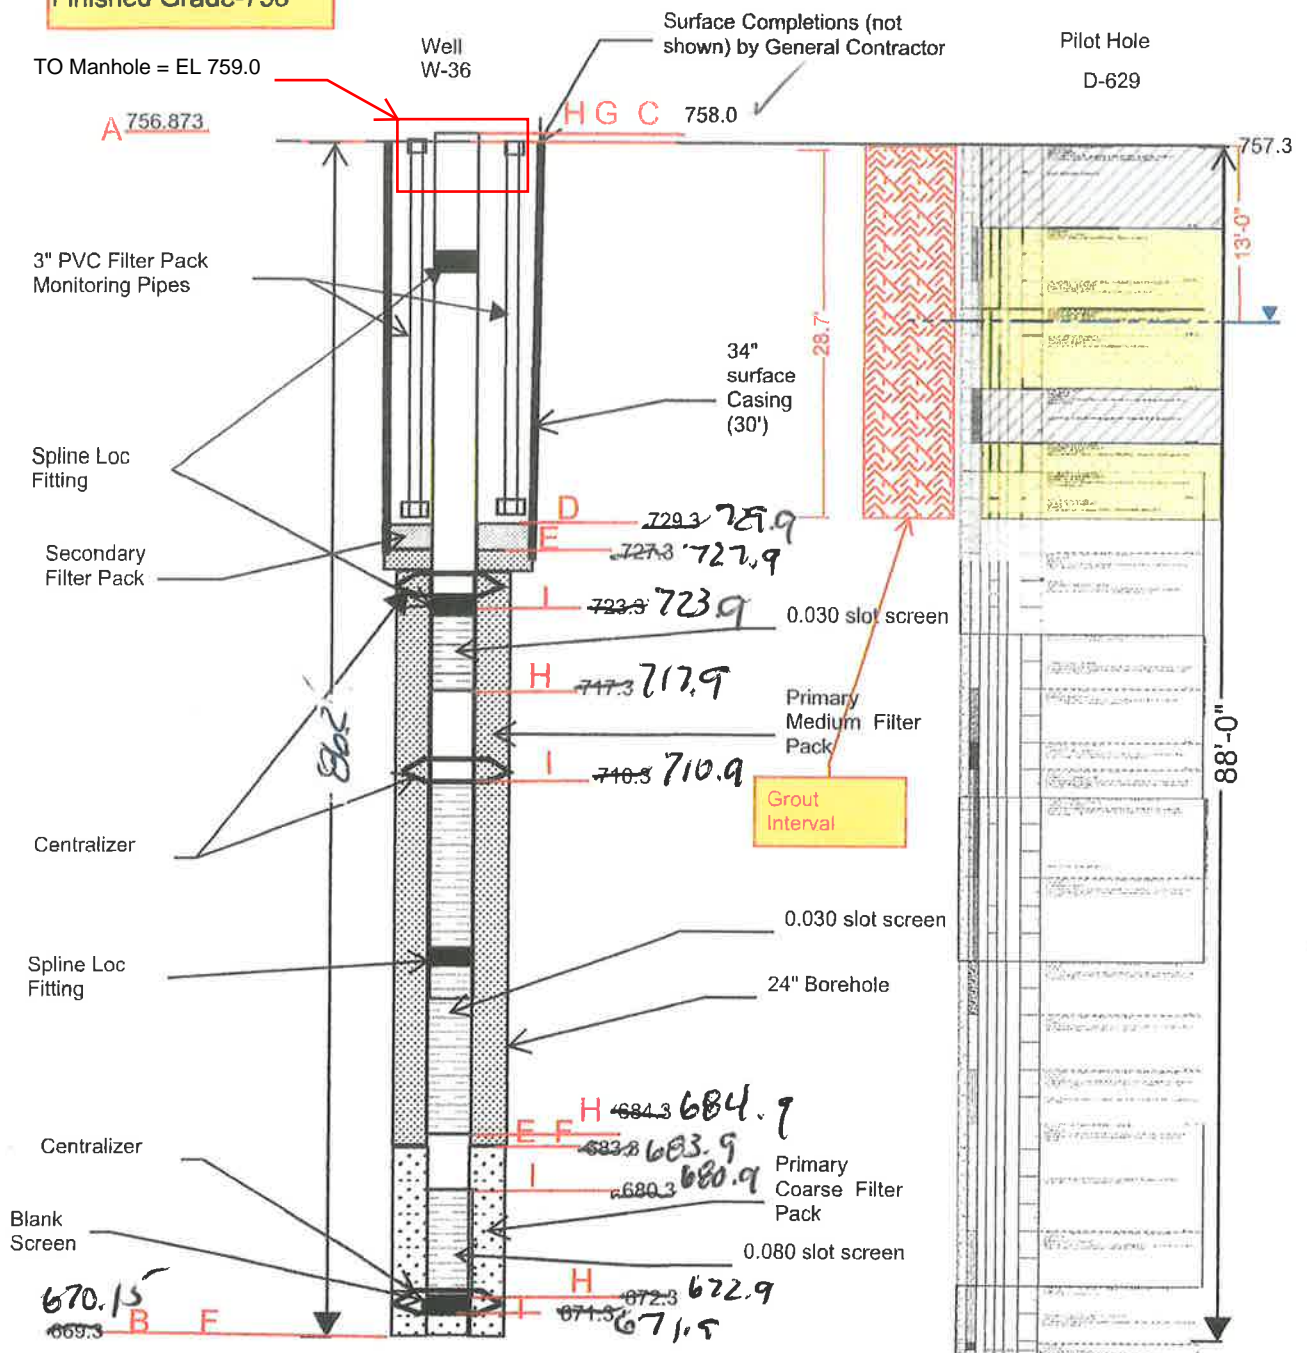


**NOTES:**

1. ALL PIPE IS 12" - 304 STAINLESS STEEL
2. CASING IS SCH. 40
3. SCREEN SLOT IS AS SHOWN
4. DRAWING IS N.T.S.

COUPLINGS WILL BE SPLINE LOC  
ALL CONNECTIONS WELDED AT  
FACTORY

<b>KC Relief Wells ARG Unit W-36</b>	
<b>GRIFFIN</b>	
Drawn By: SAS	Date: 1/26/2023
Figure 36	

**Finished Grade-758**

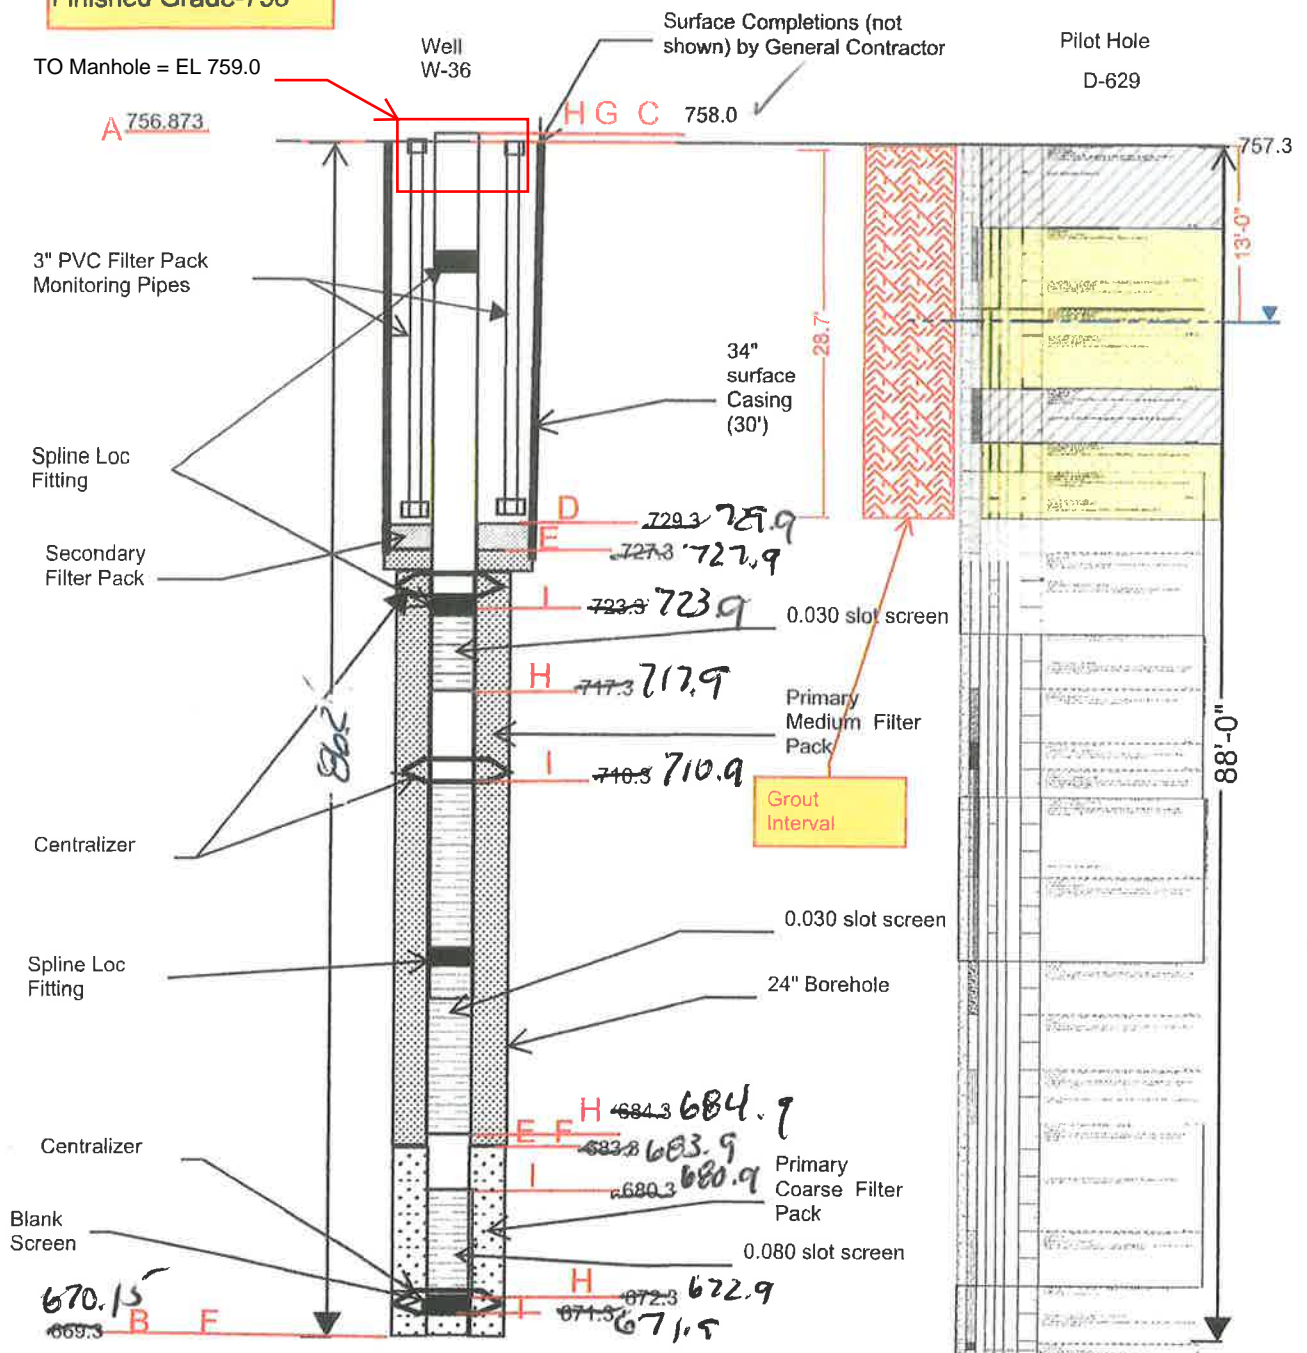

**NOTES:**

- 1. ALL PIPE IS 12" - 304 STAINLESS STEEL
- 2. CASING IS SCH. 40
- 3. SCREEN SLOT IS AS SHOWN
- 4. DRAWING IS N.T.S.

COUPLINGS WILL BE SPLINE LOC  
ALL CONNECTIONS WELDED AT  
FACTORY

<b>KC Relief Wells ARG Unit W-36</b>	
<b>GRIFFIN</b>	Figure 36
Drawn By: SAS	Date: 1/26/2023