


Form	ACO1 - Well Completion
Operator	Magellan Pipeline Company LP
Well Name	MP 212.3 1
Doc ID	1785684

Casing

Purpose Of String	Size Hole Drilled	Size Casing Set	Weight	Setting Depth	Type Of Cement	Number of Sacks Used	Type and Percent Additives
Surface	17	10	1558.48	140	neat	154	0

BILL OF MATERIALS			
ITEM	DESCRIPTION	QTY.	UNITS
1	ANODES, SET OF 20, 2684 CAST IRON 10' CENTERS AT 350', #8 HALAR	1	EACH
2	SC-3 COKE BREEZE	150	50 LB BAGS
3	BENTONITE PLUG	78	50 LB BAGS

DIMENSIONS			
CALLOUT	ITEM	DIMENSIONS	UNITS
Ⓐ	HOLE DIAMETER	10	IN
Ⓑ	HOLE DEPTH	350	FT
Ⓒ	FIRST ANODE FROM BOTTOM	5	FT
Ⓓ	ANODE SPACING	10	FT CTC
Ⓔ	ANODE BACKFILL COLUMN	210	FT
Ⓕ	HOLE PLUG COLUMN	140	FT
Ⓖ	CASING LENGTH	140	FT

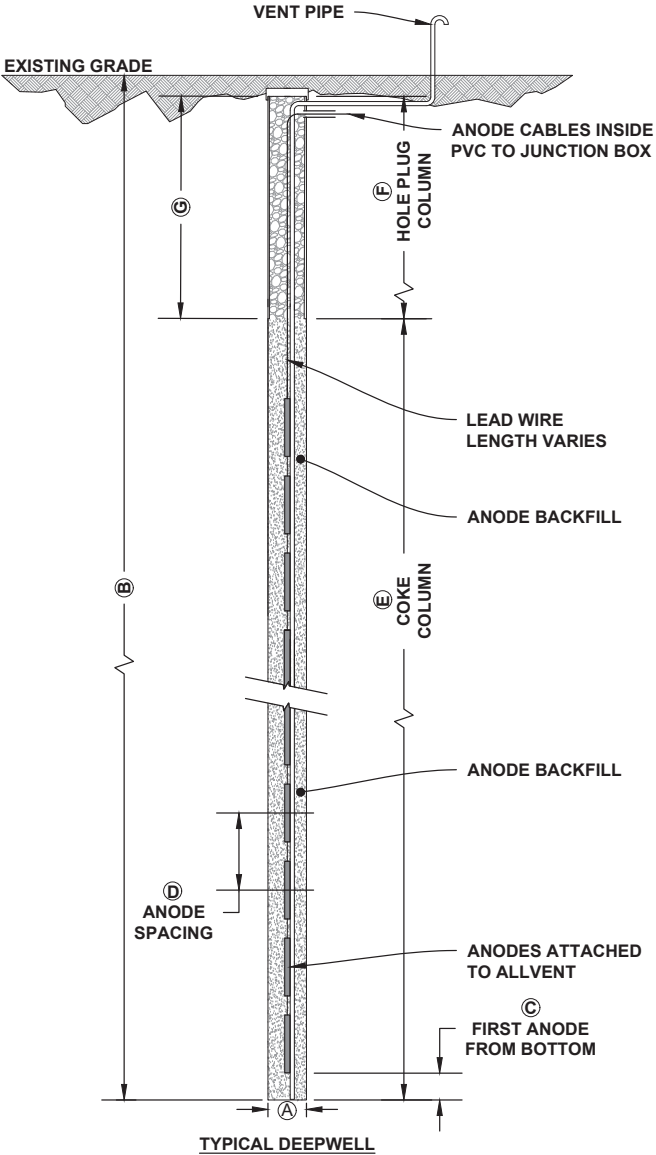

REVISIONS						DEEP GROUND BED LEGEND				Drawn By:	Date:			CATHODIC PROTECTION LAYOUT MP 212.3 DEEP GROUND BED INSTALLATION		
No.	Description	Drawn By:	Date	Chk'd By:	Date		DEEP GROUND BED		POSITIVE CABLE	J. GREENFIELD	2024			LANE	Sheet No.	KS
							ANODE JBOX		NEGATIVE CABLE	Checked By:	Date:	Project No.	2024-0023	Revision:		
							NEG. CONNECTION		PIPELINE ASSETS						R. McCLAIN	2024
							RECTIFIER									