

WATER WELL RECORD (WWC-5)

KOLAR DOC ID _____ WELL ID _____
 Original Record Correction Change in Well Use

LOCATION OF WATER WELL

Latitude		Longitude		Section		Township		Range		E W	Fraction	¼	¼	¼
Datum		Elevation		County										

WATER WELL OWNER

Name	
Business	
Address	
Well location at owner's address	

WELL WATER USE

--

COMPLETION

Depth of completed well: _____ ft.
Depth(s) groundwater encountered: (1) _____ ft.; (2) _____ ft.; (3) _____ ft.; (4) dry well
Static water level in well: _____ ft. measured below land surface on (mm/dd/yy): _____ measured above land surface on (mm/dd/yy): _____
Estimated yield: _____ gpm
Water level was: _____ ft. after _____ hours pumping _____ gpm
Pump installed? Yes No
Water well disinfected? Yes No
Date disinfected (mm/dd/yy): _____
Aquifer, if known:

NEAREST SOURCE OF POTENTIAL CONTAMINATION

Source: _____
Distance from well: _____ Direction from well: _____
Source description: _____
Source: _____
Distance from well: _____ Direction from well: _____
Source description: _____
No potential source of contamination within 100 feet.

CONSTRUCTION

Borehole interval: from _____ to _____ ft.	Borehole diameter: _____ in.
from _____ to _____ ft.	_____ in.
Casing height above land surface: _____ in.	
If casing height is less than 12 in. has a variance been approved?* Yes No	
*variance not required for monitoring or environmental remediation wells	
Casing type: _____	
Blank casing interval: _____ ft. to _____ ft.	
Blank casing diameter: _____ in.	
Casing joints: _____	
Weight: _____ lbs/ft.	
Wall thickness or gauge no.: _____	
Blank casing interval: _____ ft. to _____ ft.	
Blank casing diameter: _____ in.	
Casing joints: _____	
Weight: _____ lbs/ft.	
Wall thickness or gauge no.: _____	
Grout interval: _____ ft. to _____ ft.	
Grout material: _____	
Grout interval: _____ ft. to _____ ft.	
Grout material: _____	
Screen / perforation material: _____	
Screen / perforation openings: _____	
Screen / perforation intervals: From _____ ft. to _____ ft.	
Slot size _____ unit _____	
From _____ ft. to _____ ft.	
Slot size _____ unit _____	
Gravel pack intervals: Gravel pack not used: Gravel size _____ in	
From _____ ft. to _____ ft.	
Gravel pack not used: Gravel size _____ in	
From _____ ft. to _____ ft.	

PERMIT & ID NUMBERS (AS REQUIRED)

DWR Application No.: _____
KDHE / EPA Project Code: _____
Site Name: _____
KDHE UIC Class V Form Completed: Yes No
County Permit: Yes No Permit ID: _____
Lease Name & Well #: _____
of boreholes: _____ # of dewatering wells: _____

LITHOLOGIC LOG

FROM	TO	LITHOLOGY INTERVALS

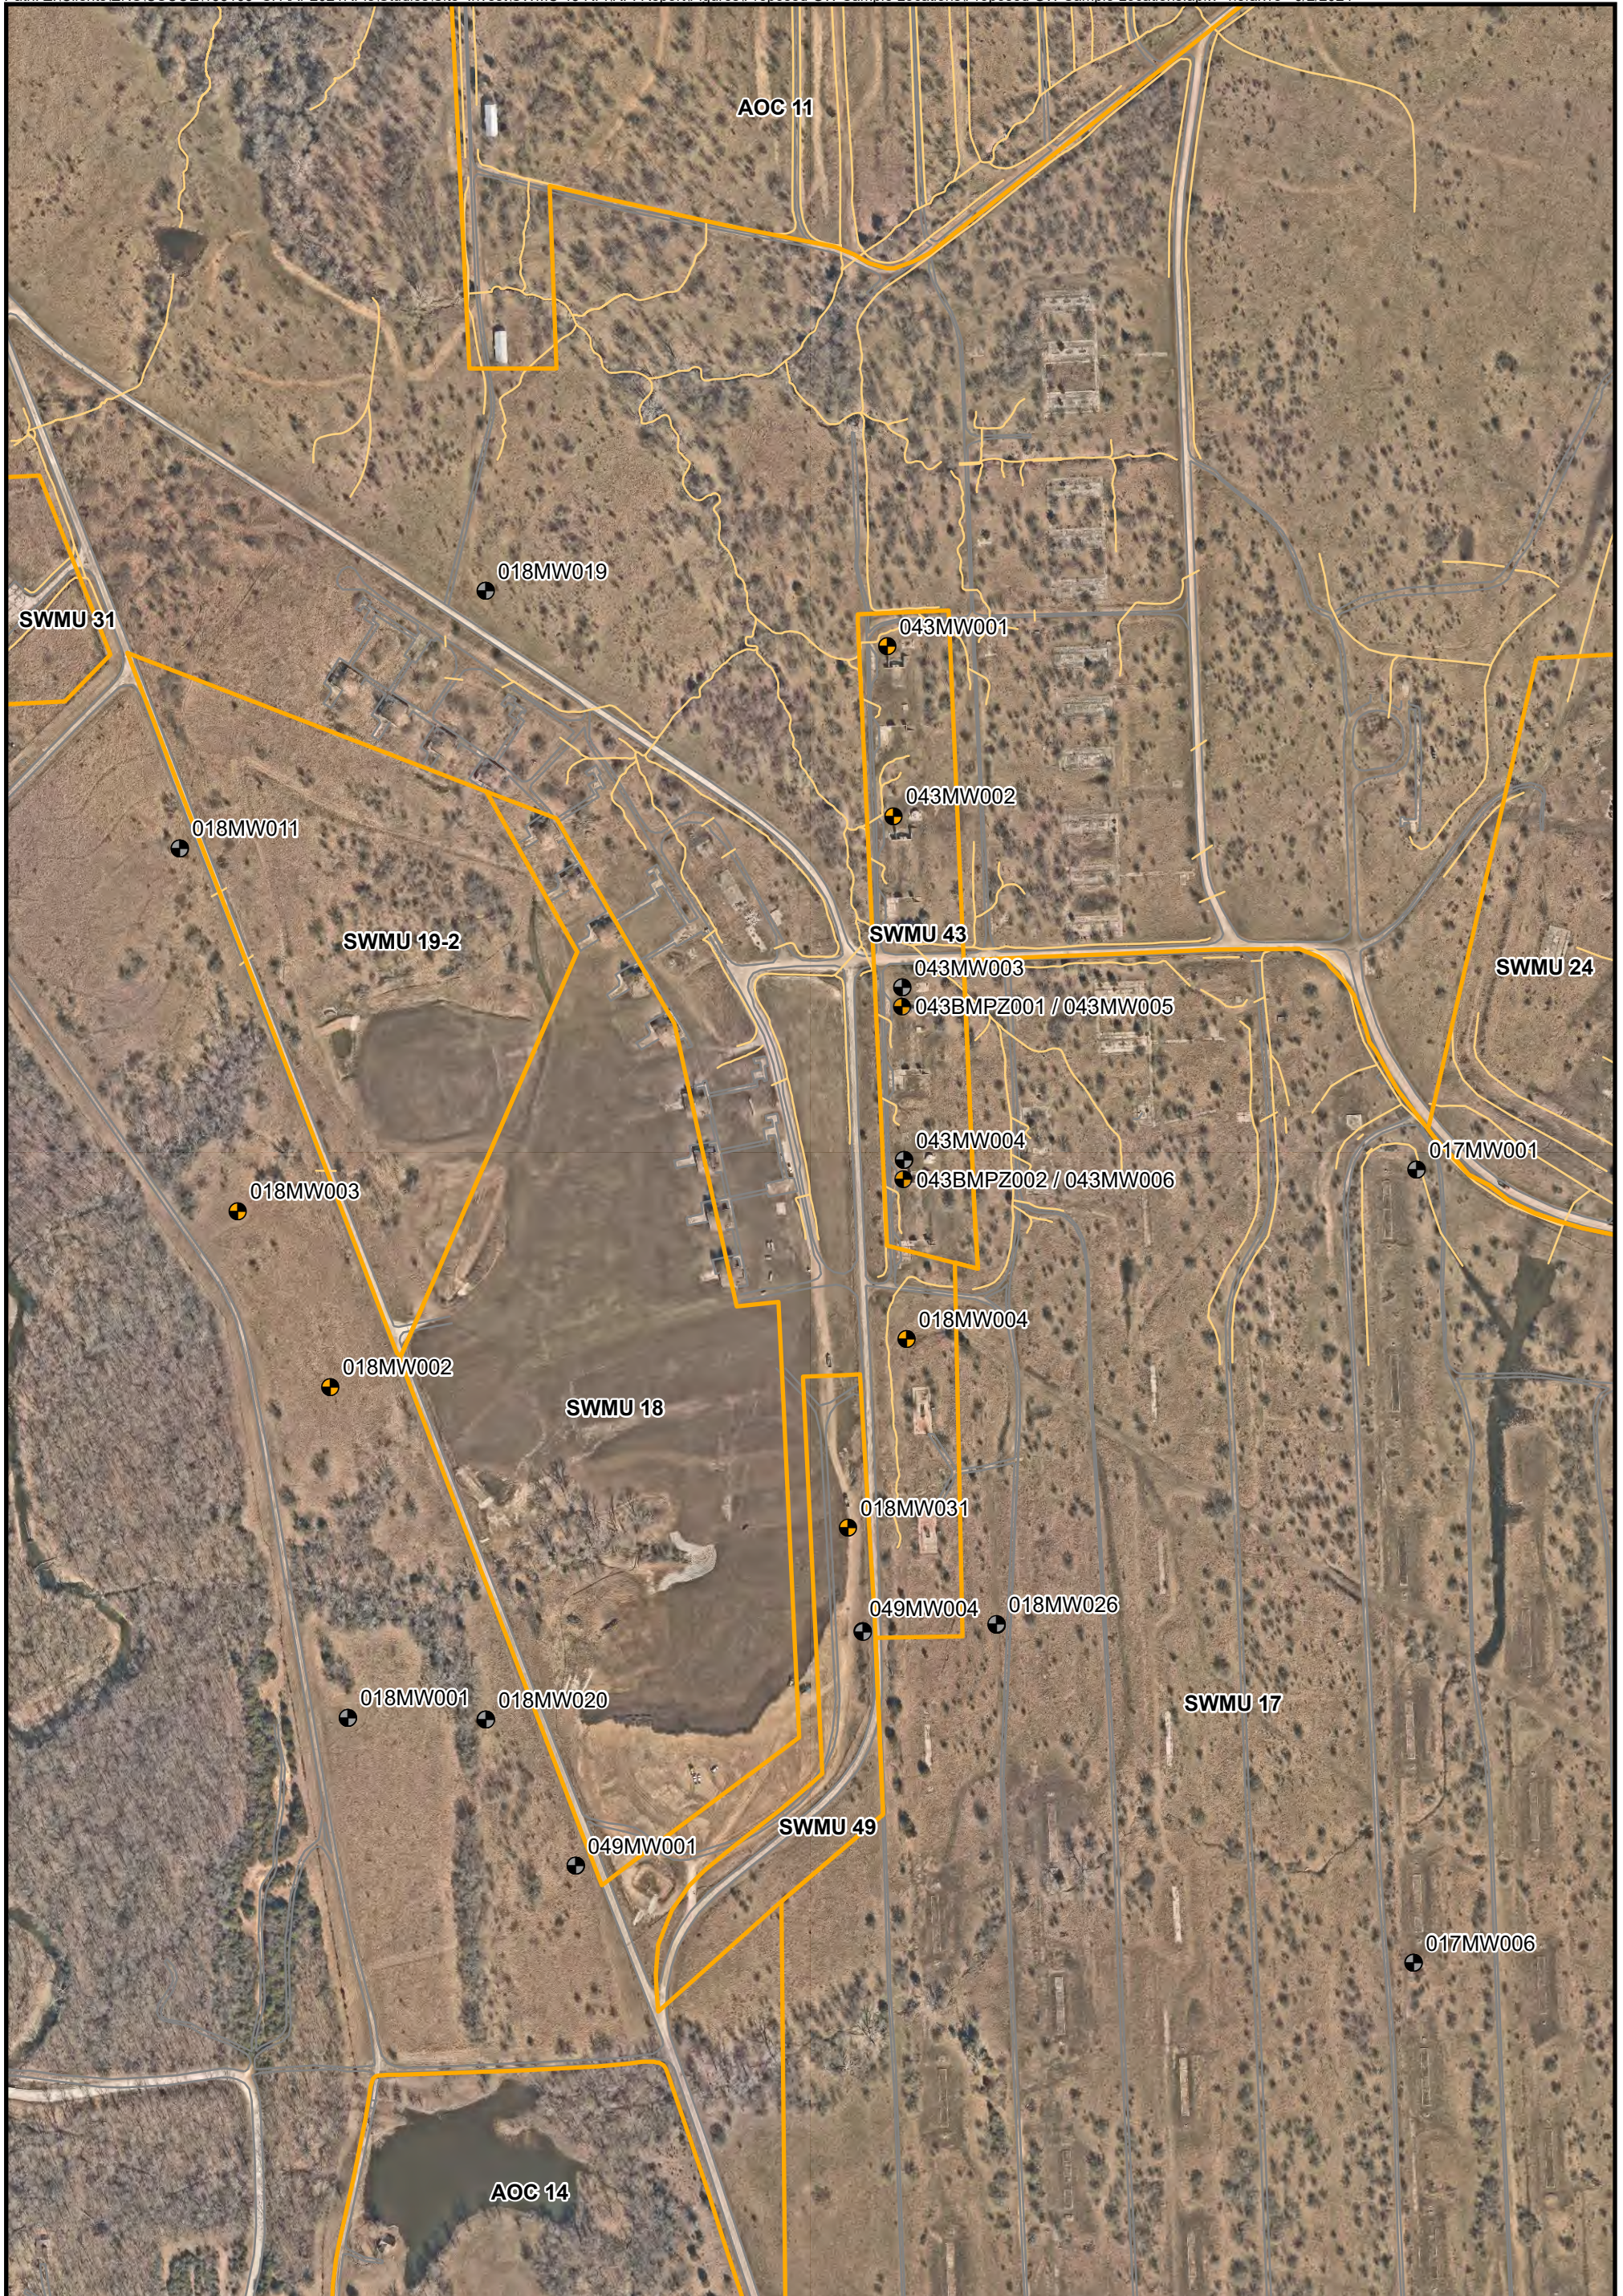
COMMENTS







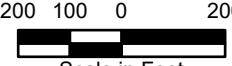

--

CONTRACTOR'S OR LANDOWNERS CERTIFICATION

This water well was constructed reconstructed pursuant to the stated water well contractor's license and was completed on _____. I certify that this record is true to the best of my knowledge and belief. This water well record was completed on _____ under the business name of _____, Kansas Water Well Contractor's License No. _____ under the authority of the designated person as defined in K.A.R. 28-30-2(j) and signed and certified by the electronic signature of the designated person at its submittal: _____.

Send one copy to WATER WELL OWNER and retain one for your records. Fee of \$5.00 for each constructed well.



<p>Legend</p> <ul style="list-style-type: none">  Monitoring Well/ Temporary Piezometer (Overburden) (Sampled during SWMU 43 RFI)  Monitoring Well (Not sampled during SWMU 43 RFI)  SWMU/AOC Boundary  Paved Road  Drainage Ditch 	  <p>Scale in Feet</p>		<p style="text-align: center;">Figure 2-2 Temporary Piezometer and Monitoring Well Location Map</p> <p style="text-align: center;">SWMU 43 RFI/CMS Report Former Sunflower Army Ammunition Plant De Soto, Kansas</p> <p style="text-align: right; font-size: small;">Issued: 6/2/2024</p>
---	---	---	---

HTW DRILLING LOG

HOLE NO.
043MW006

1. COMPANY NAME <i>Borns + McDonnell</i>		2. DRILLING SUBCONTRACTOR <i>RAZER Environmental</i>			SHEET 1 OF 4 SHEETS	
3. PROJECT <i>SFAAP</i>			4. LOCATION <i>SWW 43</i>			
6. NAME OF DRILLER <i>T. Poulter</i>			6. MANUFACTURER'S DESIGNATION OF DRILL <i>Geoprobe 7822 DT.</i>			
7. SIZES AND TYPES OF DRILLING AND SAMPLING EQUIPMENT		<i>7.25-inch HSA</i>		8. HOLE LOCATION		
		<i>2-inch MacroCOTE</i>		9. SURFACE ELEVATION		
				10. DATE STARTED <i>12-6-23</i>		
				11. DATE COMPLETED <i>12-6-23</i>		
12. OVERBURDEN THICKNESS <i>28.0'</i>			16. DEPTH GROUNDWATER ENCOUNTERED <i>17.0 ft BGS</i>			
13. DEPTH DRILLED INTO ROCK <i>NA</i>			16. DEPTH TO WATER AND ELAPSED TIME AFTER DRILLING COMPLETED <i>24.74 ft BTDC</i>			
14. TOTAL DEPTH OF HOLE <i>28.0'</i>			17. OTHER WATER LEVEL MEASUREMENTS (SPECIFY) <i>24.73 ft BTDC 12-12-23</i>			
18. GEOTECHNICAL SAMPLES <i>NA</i>		DISTURBED	UNDISTURBED	19. TOTAL NUMBER OF CORE BOXES <i>NA</i>		
20. SAMPLES FOR CHEMICAL ANALYSIS <i>NA</i>		VOC	METALS	OTHER (SPECIFY)	OTHER (SPECIFY)	
22. DISPOSITION OF HOLE		BACKFILLED	MONITORING WELL	OTHER (SPECIFY) <i>Temp. Piezo</i>	23. SIGNATURE OF INSPECTOR <i>[Signature]</i>	

ELEV. a	DEPTH b	DESCRIPTION OF MATERIALS c	FIELD SCREENING RESULTS d	GEOTECH SAMPLE OR CORE BOX NO. e	ANALYTICAL SAMPLE NO. f	BLOW COUNTS g	REMARKS h
	1	<i>CLAY, with silt, ch, very dark gray (104R 3/1), damp, stiff consistency, high plasticity.</i>	<i>PID</i>	<i>NA</i>	<i>NA</i>	<i>NA</i>	<i>Begin Fishing 1024</i>
	2	<i>trace oxidation reddish brown (54R 4/4)</i>	<i>0.0</i>				<i>45' south of 043MW004</i>
	3	<i>trace fine sand</i>	<i>0.0</i>				<i>Recovery 5/5</i>
	4		<i>0.0</i>				

HTW DRILLING LOG

HOLE NO.
043MW006

PROJECT *SFAAP*

INSPECTOR

SHEET *2*
OF 4 SHEETS

ELEV. a	DEPTH b	DESCRIPTION OF MATERIALS c	FIELD SCREENING RESULTS d	GEOTECH SAMPLE OR CORE BOX NO. e	ANALYTICAL SAMPLE NO. f	BLOW COUNTS g	REMARKS h
	6	CLAY, trace, with silt, CH, Very dark gray (104R 3/1). Damp, stiff consistency. high plasticity. Trace oxidation reddish brown (54R 4/4).	PID 0.0	NA	NA	NA	1027
	7	CLAY, trace sand, CH, gray (104R 6/1) damp, stiff consistency, high plasticity, trace oxidation reddish brown (54R 4/4).	0.0 0.0				Recovery 4/5
	8		0.0				
	9		0.0				
	10						1030
	11		0.0 0.0				Recovery 4.5/5.
	12	SAND, some clay, SM, light gray (W 7), very fine to coarse grained, well sorted. trace oxidation reddish brown (54R 4/4).	0.0				
	13		0.0				

HTW DRILLING LOG

HOLE NO.
043MW006

PROJECT *SFAAP*

INSPECTOR

SHEET *3*
OF *4* SHEETS

ELEV. a	DEPTH b	DESCRIPTION OF MATERIALS c	FIELD SCREENING RESULTS d	GEOTECH SAMPLE OR CORE BOX NO. e	ANALYTICAL SAMPLE NO. f	BLOW COUNTS g	REMARKS h
	15	<i>SAND, SW, light brown (54R 5/10) Very fine to coarse grains, Well sorted.</i>	<i>0.0</i>				<i>1036</i>
	16		<i>0.0</i>				<i>Recovery 5/5</i>
	17		<i>0.0</i>				<i>∇</i>
	18	<i>Wet, very fine sand to silt</i>	<i>0.0</i>				
	19	<i>Light gray (N7)</i>					
	20						<i>1040</i>
	21						<i>Recover 4/5</i>
	22						

HTW DRILLING LOG

HOLE NO.
043MW006

PROJECT **SFAAP**

INSPECTOR

SHEET **4**
OF **4** SHEETS

ELEV. a	DEPTH b	DESCRIPTION OF MATERIALS c	FIELD SCREENING RESULTS d	GEOTECH SAMPLE OR CORE BOX NO. e	ANALYTICAL SAMPLE NO. f	BLOW COUNTS g	REMARKS h
	24	SAND, Sw, light gray (N7), moist, fine to coarse grain, well sorted.	RED	NA	NA	NA	Recovery 4/5
	25						
	26						Recovery 3/3
	27						
	28	CLAY, yellowish brown (104R S/G) CH, wet, very soft consistency high plasticity.					
		Refused @ 28.0'					