## KOLAR Document ID: 1784455

# WATER WELL RECORD (WWC-5)

KOLAR DOC ID \_\_\_\_\_ WELL ID \_\_\_\_\_

## LOCATION OF WATER WELL

Latit	de	Longitude	Section	Township	Range	E W	Fraction	1⁄4	1	/4	1⁄4
Datu	n	Elevation	County								

## WATER WELL OWNER

Name	
Business	
Address	
Well location	
at owner's address	

#### WELL WATER USE

WELL INFORMATION		
Depth of well:	ft.	
Dry well		
Static water level in well:		ft.
measured below land surface on (mm/dd/yy):		
measured above land surface on (mm/dd/yy):		

**GROUT & PLUGGING MATERIALS** 

PERMIT & ID NUMBERS (AS REQUIRED)
DWR Application No.:
KDHE / EPA Project Code:
Site Name:
KDHE UIC Class V Form Completed: Yes No
County Permit: Yes No Permit ID:
Lease Name & Well #:
# of boreholes: # of dewatering wells:

## CASING

## Type of blank casing used: \_\_\_\_\_\_ Casing type details: \_\_\_\_\_\_ Blank casing diameter: \_\_\_\_\_\_ inches Was casing removed? Yes No Top of casing is currently \_\_\_\_\_\_ feet \_\_\_\_\_\_ ground Reason required if top of casing is now less than 5 feet below ground surface for a hand dug well or less than 3 feet below ground surface for all other types of wells.


Grout or Plugging interval (ft.)		Material	Description			
From	From To					

## COMMENTS

## CONTRACTOR'S OR LANDOWNERS CERTIFICATION

This water well was plugged pursuant to the stated water well contractor's license and was completed on	I certify that this
record is true to the best of my knowledge and belief. This water well record was completed on	under the business name of
, Kansas Water Well Contractor's License No.	under the
authority of the designated person as defined in K.A.R. 28-30-2(j) and signed and certified by the electronic sig	nature of the designated
person at its submittal	

Send one copy to WATER WELL OWNER and retain one for your records.

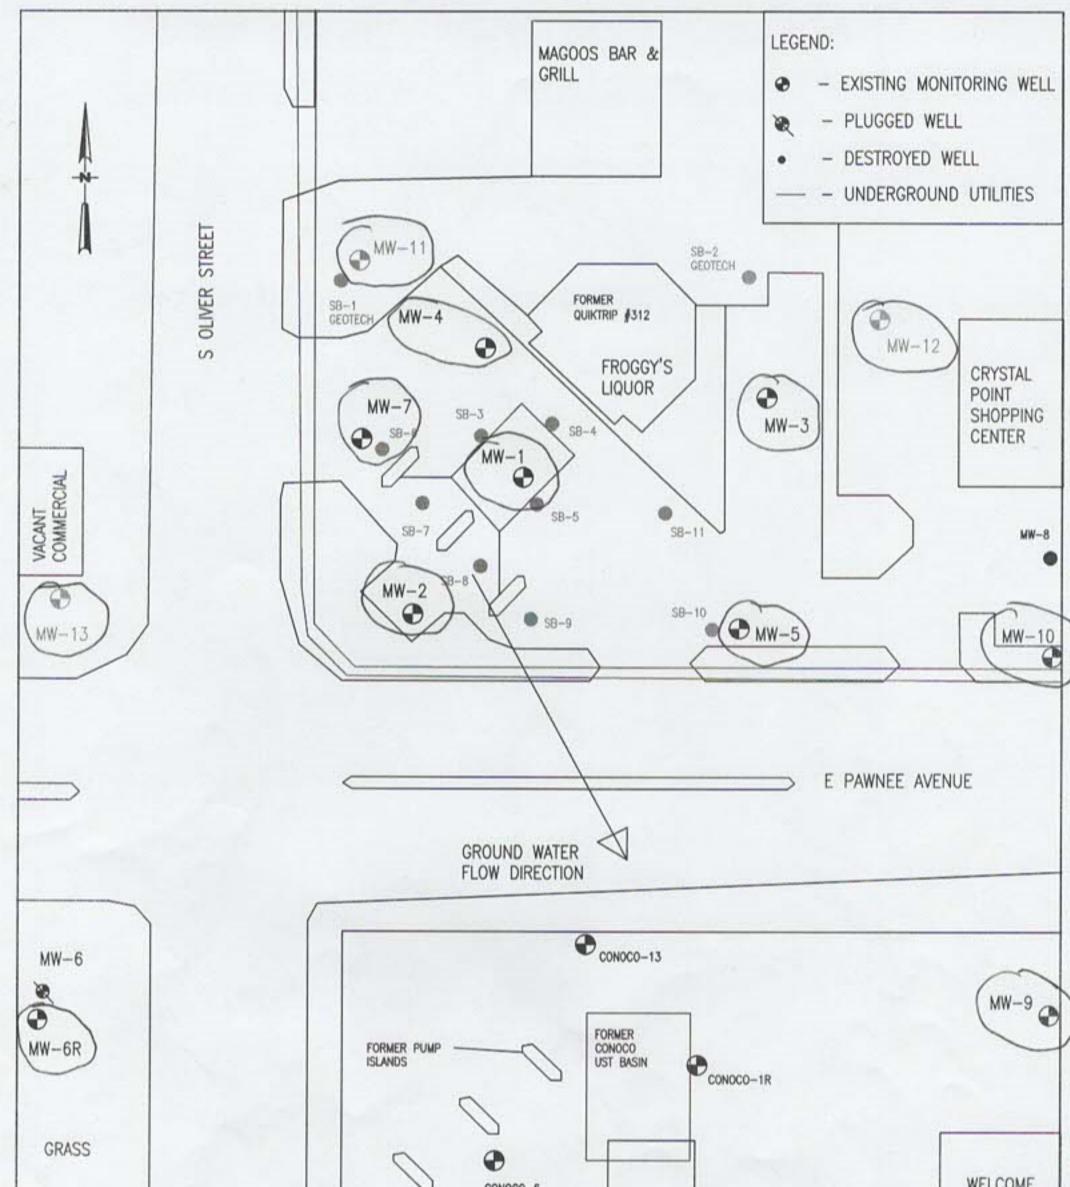

0 50 APPROXIMATE SCALE (FEET)		CONOCO-6	SELECT MOTORS	CHURCH
PROJ.# 17102733 SCALE: AS SHOWN	PAGE#		FIGURE 2 SITE MAP QUIK TRIP #312	
FILE NO. 2733-F2 DATE: 08/31/22 APF	DESIGNED BY:	BE K / Terranext	U2-287-10558 2336 S OLIVER WICHITA, KANSAS	