

**WATER WELL RECORD (WWC-5)**

KOLAR DOC ID \_\_\_\_\_ WELL ID \_\_\_\_\_  
 Original Record      Correction      Change in Well Use

**LOCATION OF WATER WELL**

Latitude		Longitude		Section		Township		Range		E W	Fraction		¼		¼		¼
Datum		Elevation		County													

**WATER WELL OWNER**

Name	
Business	
Address	
Well location	
at owner's address	

**WELL WATER USE**

--

**COMPLETION**

Depth of completed well: _____ ft.
Depth(s) groundwater encountered:
(1) _____ ft.; (2) _____ ft.;
(3) _____ ft.; (4) dry well
Static water level in well: _____ ft.
measured below land surface
on (mm/dd/yy): _____
measured above land surface
on (mm/dd/yy): _____
Estimated yield: _____ gpm
Water level was: _____ ft. after _____ hours
pumping _____ gpm
Pump installed? Yes No
Water well disinfected? Yes No
Date disinfected (mm/dd/yy): _____
Aquifer, if known:

**NEAREST SOURCE OF POTENTIAL CONTAMINATION**

Source: _____
Distance from well: _____ Direction from well: _____
Source description: _____
Source: _____
Distance from well: _____ Direction from well: _____
Source description: _____
No potential source of contamination within 100 feet.

**CONSTRUCTION**

Borehole interval:	Borehole diameter:
from _____ to _____ ft.	_____ in.
from _____ to _____ ft.	_____ in.
Casing height above land surface: _____ in.	
If casing height is less than 12 in. has a variance been approved?* Yes No	
*variance not required for monitoring or environmental remediation wells	
Casing type: _____	
Blank casing interval: _____ ft. to _____ ft.	
Blank casing diameter: _____ in.	
Casing joints: _____	
Weight: _____ lbs/ft.	
Wall thickness or gauge no.: _____	
Blank casing interval: _____ ft. to _____ ft.	
Blank casing diameter: _____ in.	
Casing joints: _____	
Weight: _____ lbs/ft.	
Wall thickness or gauge no.: _____	
Grout interval: _____ ft. to _____ ft.	
Grout material: _____	
Grout interval: _____ ft. to _____ ft.	
Grout material: _____	
Screen / perforation material: _____	
Screen / perforation openings: _____	
Screen / perforation intervals:	
From _____ ft. to _____ ft.	
Slot size _____ unit _____	
From _____ ft. to _____ ft.	
Slot size _____ unit _____	
Gravel pack intervals:	
Gravel pack not used: Gravel size _____ in	
From _____ ft. to _____ ft.	
Gravel pack not used: Gravel size _____ in	
From _____ ft. to _____ ft.	

**PERMIT & ID NUMBERS (AS REQUIRED)**

DWR Application No.: _____
KDHE / EPA Project Code: _____
Site Name: _____
KDHE UIC Class V Form Completed: Yes No
County Permit: Yes No Permit ID: _____
Lease Name & Well #: _____
# of boreholes: _____ # of dewatering wells: _____

**LITHOLOGIC LOG**

FROM	TO	LITHOLOGY INTERVALS

**COMMENTS**

--

**CONTRACTOR'S OR LANDOWNERS CERTIFICATION**

This water well was constructed reconstructed pursuant to the stated water well contractor's license and was completed on _____. I certify that this record is true to the best of my knowledge and belief. This water well record was completed on _____ under the business name of _____, Kansas Water Well Contractor's License No. _____ under the authority of the designated person as defined in K.A.R. 28-30-2(j) and signed and certified by the electronic signature of the designated person at its submittal: _____.	
--	--

Send one copy to WATER WELL OWNER and retain one for your records. Fee of \$5.00 for each constructed well.

Form	WWC5.2 - Water Well Record
Doc ID	1793238
Well Owner	Kaw Valley Drainage District
Contractor	Griffin Dewatering, LLC

Casing

From	To	Casing Diameter	Casing Joint	Casing Weigh	Wall Thickness or Gauge Number
0	33.2	12.75	Splines	49.56	Sch 40
37.8	44.1	12.75	Splines	49.56	Sch 40
68.2	72.3	12.75	Splines	48.56	Sch 40

Form	WWC5.2 - Water Well Record
Doc ID	1793238
Well Owner	Kaw Valley Drainage District
Contractor	Griffin Dewatering, LLC

### Lithology

From	To	Lithology Intervals
0	3	clay, very fine, silty, light, brownish, brown, dry, soft, not cemented
3	11.5	sand, fine, clayey, light, brownish, brown, dry, loose, not cemented
11.5	15	clay, very fine, silty, light, brownish, brown, dry, firm, not cemented
15	18	sand, fine to medium, clayey, dark, brownish, brown, dry, firm, not cemented
18	26	sand, medium, clayey, dark, brownish, blue, dry, firm, not cemented
26	29	sand, fine to medium, clayey, dark, brownish, brown, dry, hard, not cemented
29	35	sand, fine to coarse, gravelly, dark, brownish, brown, dry, hard, not cemented
35	37.5	sand, fine, dark, brownish, brown, dry, firm, not cemented
37.5	39	sand, fine to coarse, dark, brownish, brown, dry, hard, not cemented
39	40	sand, fine to coarse, dark, brownish, brown, dry, hard, not cemented

Form	WWC5.2 - Water Well Record
Doc ID	1793238
Well Owner	Kaw Valley Drainage District
Contractor	Griffin Dewatering, LLC

#### Lithology

From	To	Lithology Intervals
40	51	sand, fine to medium, light, brownish, blue, wet, hard, not cemented
51	52	clay, very fine, very dark, brownish, brown, saturated, stiff, not cemented
52	59	sand & gravel, medium to coarse, clayey, dark, brownish, brown, saturated, dense, not cemented
59	66	cobbles, medium, sandy, dark, brownish, brown, saturated, dense, not cemented
66	81	cobbles, medium, gravelly, dark, brownish, brown, saturated, dense, not cemented

Form	WWC5.2 - Water Well Record
Doc ID	1793238
Well Owner	Kaw Valley Drainage District
Contractor	Griffin Dewatering, LLC

Screen and Gravel

From	To	Slot Size	Slot Size Units	Gravel Pack Used	Gravel Pack From	Gravel Pack To	Gravel Size
33.2	37.8	.03	inches	Yes	26.4	45	.15
44.1	68.2	.03	inches	Yes	45	69.4	.15
72.3	80.1	.08	inches	Yes	69.4	80.1	.40



Hilshire Brands KC / Tyson

Speaker Rd

39.09475479968, -94.67570966720 W-28

Sam's Club Distribution

Pomp's Tire Service

Pilot Travel Center

QuikTrip

McDonald's

Levee Rd

Kansas River

635

32

32

Google Earth

Image Landsat / Copernicus

1000 ft






Finished Grade-770.35

Surface Completions (not shown) by General Contractor

*Final*

Pilot Hole  
D-619

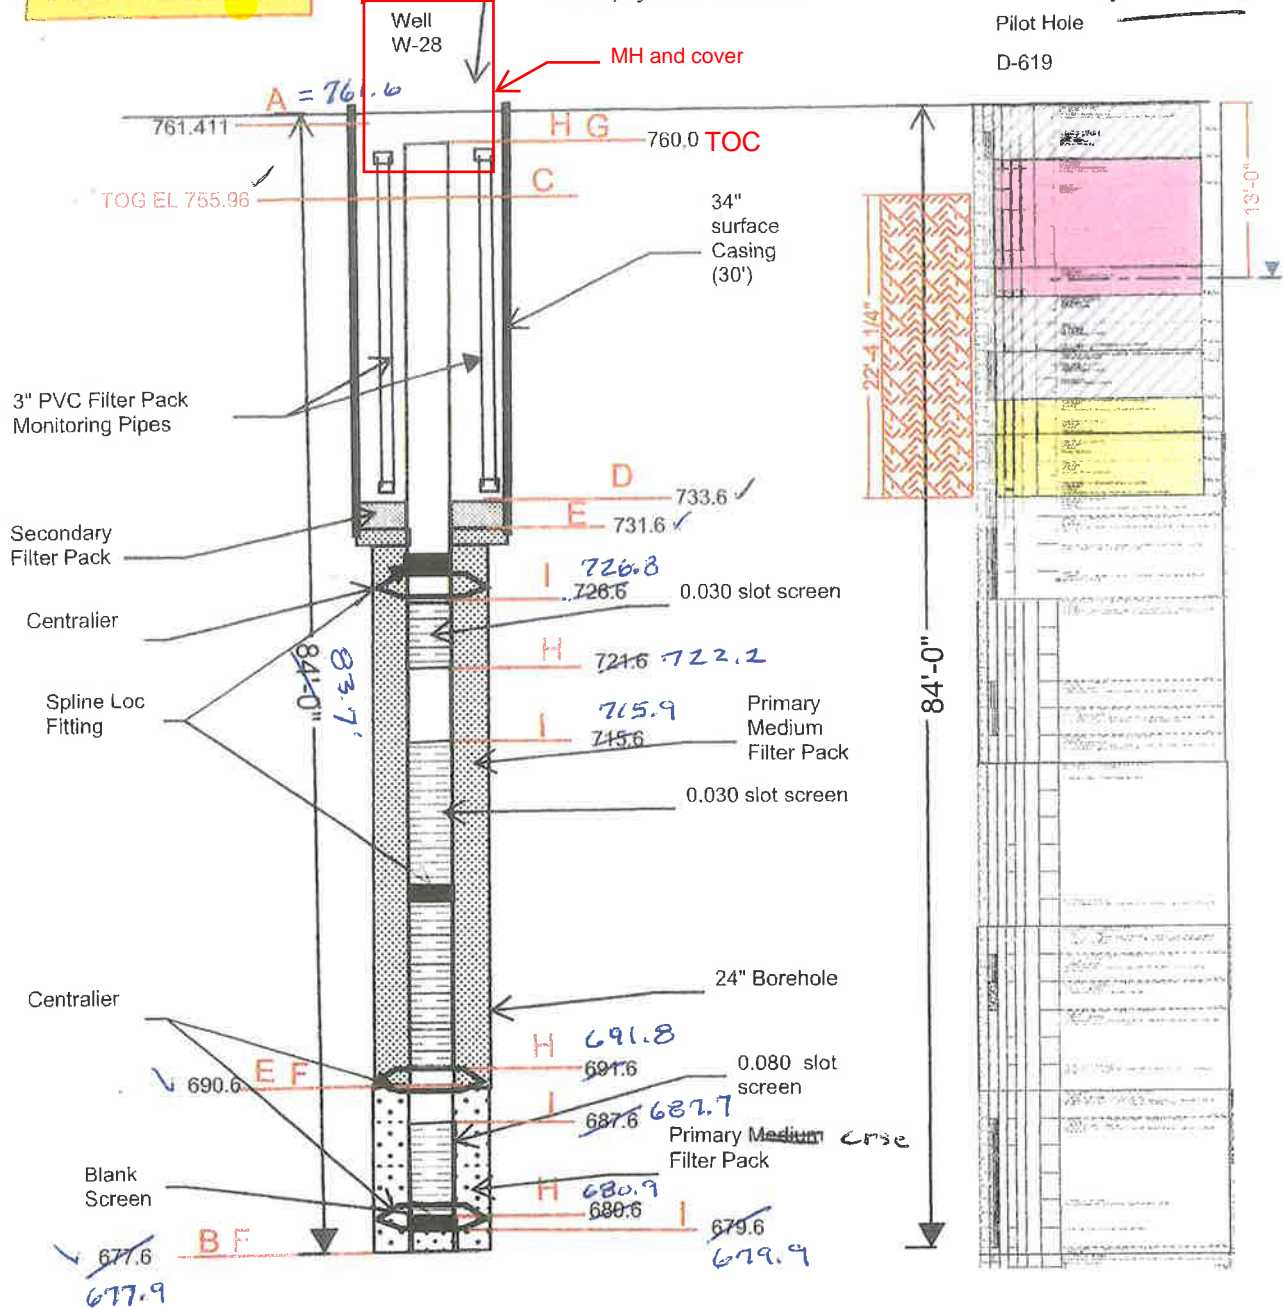

NOTES:

- 1. ALL PIPE IS 12" - 304 STAINLESS STEEL
- 2. CASING IS SCH. 40
- 3. SCREEN SLOT IS AS SHOWN
- 4. DRAWING IS N.T.S.

COUPLINGS WILL BE SPLINE LOC  
ALL CONNECTIONS WELDED AT  
FACTORY

<b>KC Relief Wells</b>		Figure 28 Rev 1
<b>ARG Unit</b>		
W-28		
<b>YGRIFFIN</b>		
Drawn By: SAS	Date: 12/22/2022	

