WELL ID

KOLAR DOC ID\_

## **WATER WELL RECORD** (WWC-5)


Latitude	Longitude	Section	on	Township	Range	E W		1/4	1/4	1/4	
Datum	Elevation	Coun	ty			,,					
VATER WELL OWNER		WELL WATE	R USE			PERMIT &	ID NUMBERS	S (AS REQUI	RED)		
Name						DWR Ap	plication No.:				
Business	WELL INFOR	WELL INFORMATION				KDHE / EPA Project Code:  Site Name:  KDHE UIC Class V Form Completed: Yes No County Permit: Yes No Permit ID:  Lease Name & Well #:					
Address		Depth of well:ft.									
			Dry well Static water level in well: ft.								
Well location	measure	measured below land surface on (mm/dd/yy):									
at owner's address	measure	measured above land surface on (mm/dd/yy):				# of boreholes: # of dewatering wells:					
ASING		GROUT & PI	LUGGING MA	ATERIALS							
Type of blank casing used:		Grout or	Grout or Plugging								
Casing type details:		interv	interval (ft.)			Description					
Blank casing diameter:	inches	From	То								
Was casing removed?	Yes No										
Top of casing is currentl	yfeet										
	ground										
	f casing is now less than 5 ce for a hand dug well or										
Č	ound surface for all other										
types of wells.		COMMENTS	;								
CONTRACTOR'S OR LAI	NDOWNERS CERTIFICAT										
	lugged pursuant to the s		contractor's	license and was	completed	l on _	I c	ertify that	this		
•	est of my knowledge an				-			•			
	•			=							
authority of the design	nated person as defined	in K.A.R. 28-30-	2(j) and sig	ned and certified	d by the el	ectronic sig	nature of the	designated	l		
person at its submitta	ıl										

Send one copy to WATER WELL OWNER and retain one for your records.



## Figure 1-Johns' Sludge Pond Site Map



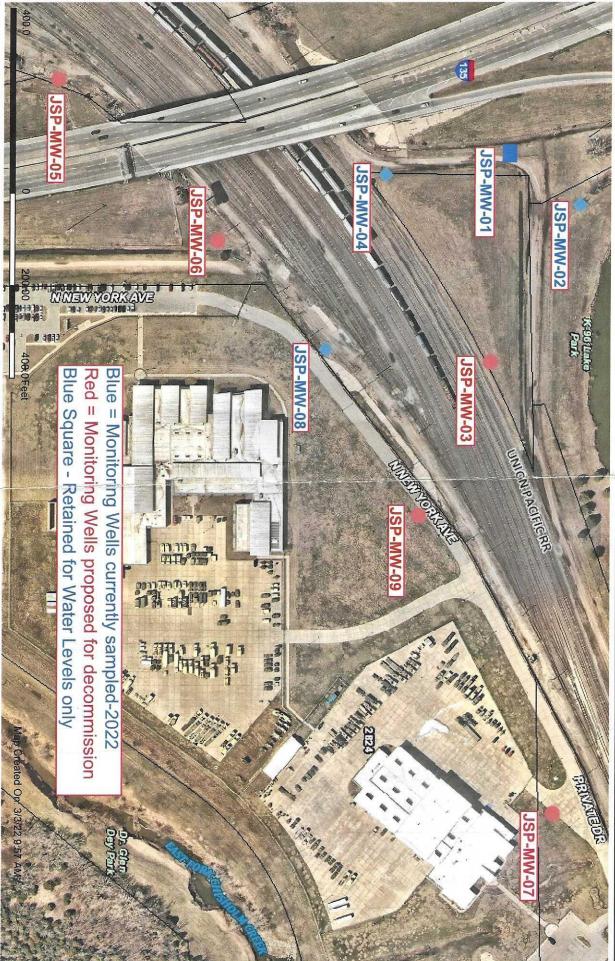

This information is not an official record, and cannot be used as such. The user should rely only upon official records available from the custodian of records in the appropriate City and/or County department. Some data provided here and used for the preparation of these maps has been obtained from public records not created or maintained by the City of Wichita.



