# WATER WELL RECORD (WWC-5)

Plugged

KOLAR DOC ID 1798589 WELL ID RW-11 OBS

## LOCATION OF WATER WELL

| | | | | | | | | | | | |
|---|---|---|---|---|---|---|---|---|---|---|---|
| Latitude | 39.127 | Longitude | -94.607 | Section | 2 | Township | 11 | Range | 25 ✓E ☐W | Fraction | SW ¼ NE ¼ NW ¼ |
| Datum | WGS84 | Elevation | 745 | County | Wyandotte | | | | | | |

## WATER WELL OWNER

| | |
|---|---|
| Name | |
| Business | Phillips 66 Company |
| Address | 422 S. Keeler Ave.<br>Bartlesville OK 74003 |
| Well location<br>☐ at owner's address | 2029 Fairfax Trafficway<br>Kansas City<br>Kansas, 66115 |

## WELL WATER USE

Environmental Remediation / Monitoring Mc

## WELL INFORMATION

Depth of well: 28 ft.

☐ Dry well

Static water level in well: 25.28 ft.

✓ measured below land surface on (mm/dd/yy): 08/05/2024

☐ measured above land surface on (mm/dd/yy):

## PERMIT & ID NUMBERS (AS REQUIRED)

DWR Application No.:

KDHE / EPA Project Code: C410500044

Site Name: Phillips Former KC Refinery

KDHE UIC Class V Form Completed: ☐ Yes ☐ No

County Permit: ☐ Yes ☐ No Permit ID:

Lease Name & Well #:

# of boreholes: # of dewatering wells:

## CASING

Type of blank casing used: ThermalPlastic

Casing type details:

Blank casing diameter: 2 inches

Was casing removed? ☐ Yes ☐ No

Top of casing is currently 3 feet Below ground

Reason required if top of casing is now less than 5 feet below ground surface for a hand dug well or less than 3 feet below ground surface for all other types of wells.

## GROUT & PLUGGING MATERIALS

| Grout or Plugging interval (ft.) | | Material | Description |
|---|---|---|---|
| From | To | | |
| 0 | 28 | bentonite | |
| | | | |
| | | | |
| | | | |
| | | | |
| | | | |

## COMMENTS

## CONTRACTOR'S OR LANDOWNERS CERTIFICATION

This water well was plugged pursuant to the stated water well contractor's license and was completed on 08/05/2024. I certify that this record is true to the best of my knowledge and belief. This water well record was completed on 10/12/2024 under the business name of Plains Environmental Services, Inc. - #1039, Kansas Water Well Contractor's License No. 1039 under the authority of the designated person as defined in K.A.R. 28-30-2(j) and signed and certified by the electronic signature of the designated person at its submittal Jason Auernheimer.

Send one copy to WATER WELL OWNER and retain one for your records.

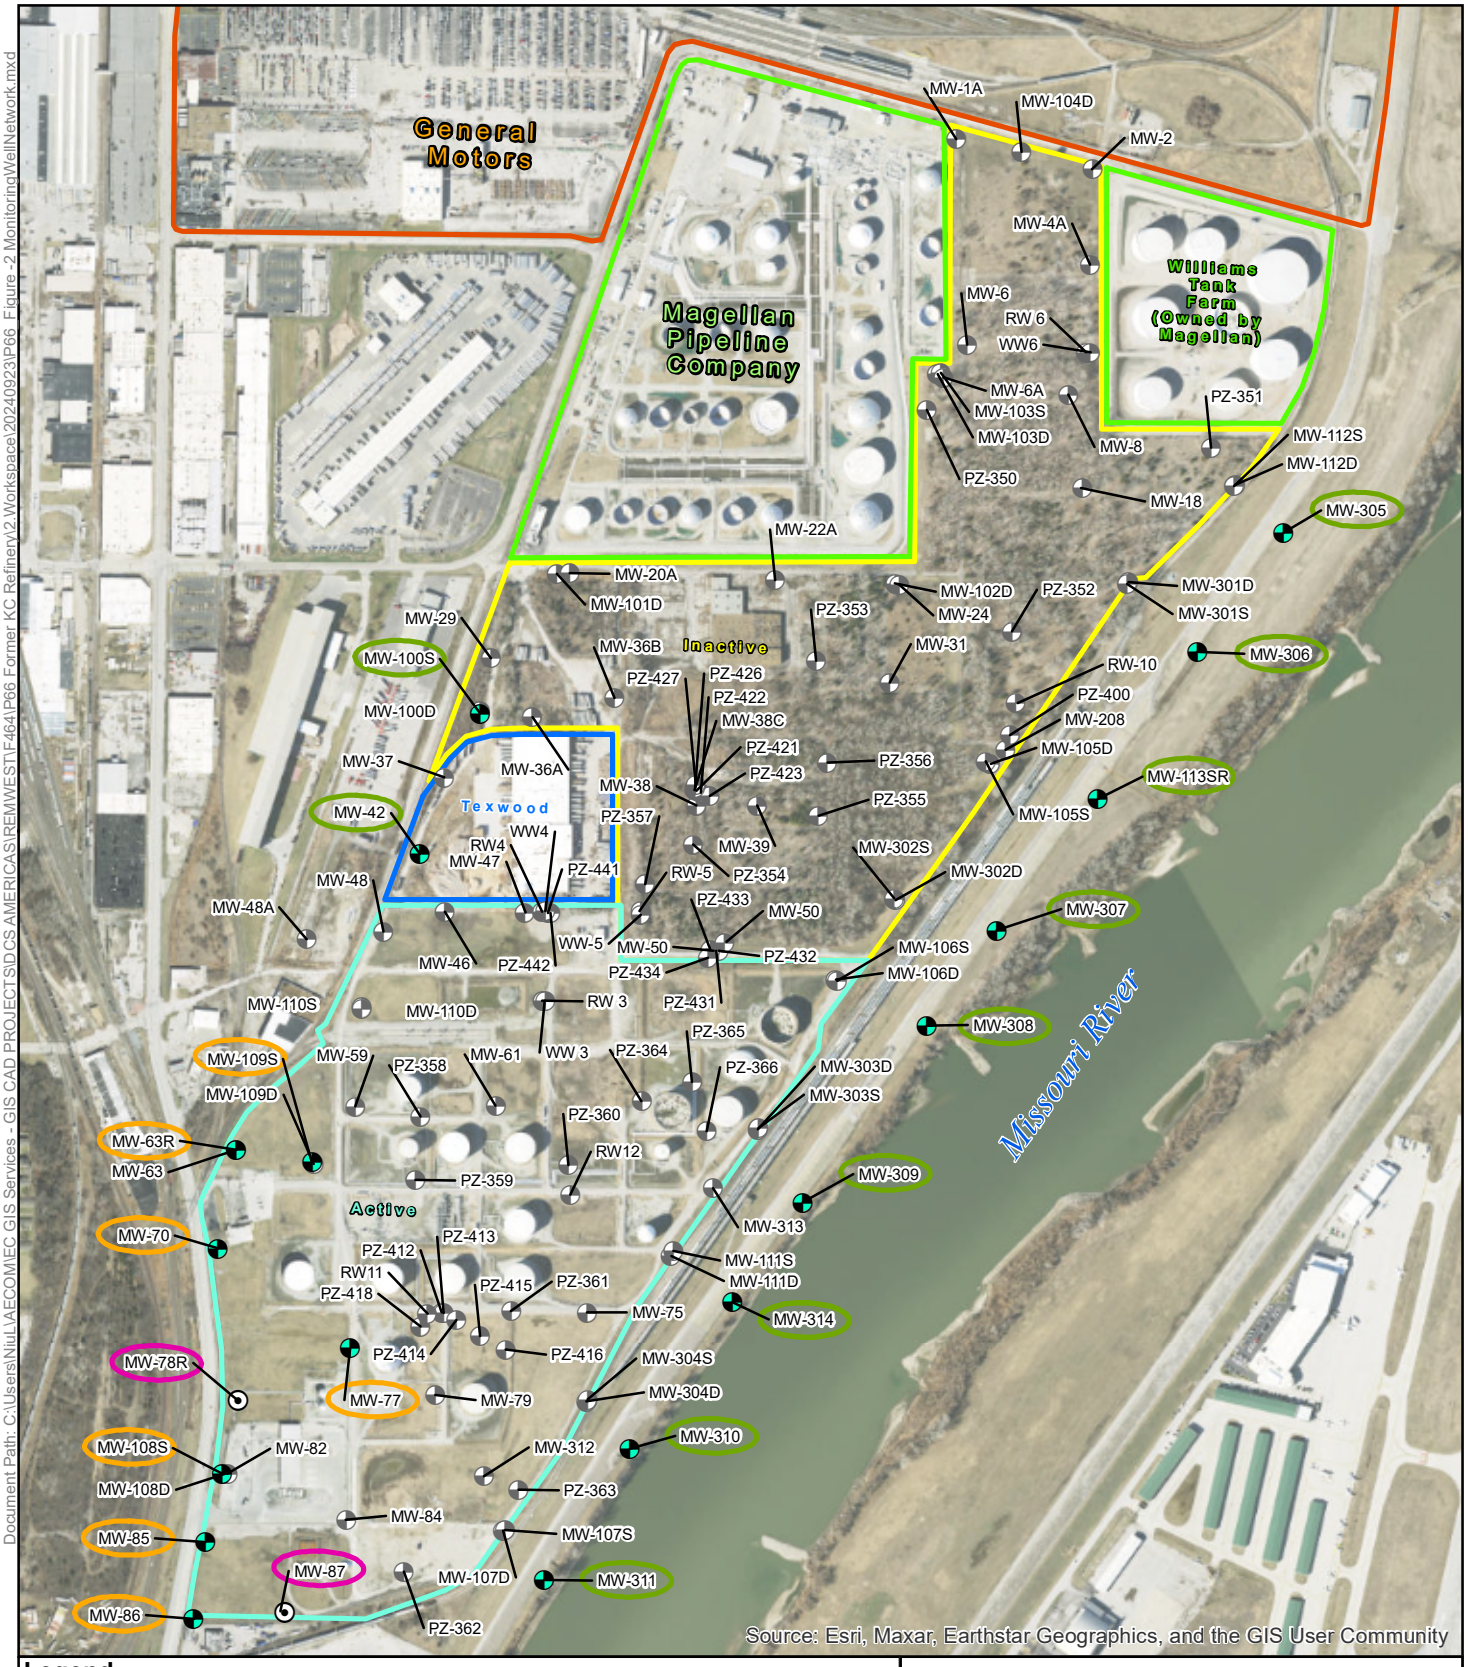


Document Path: C:\Users\NiuL\AECOM\EC GIS Services - GIS CAD PROJECTS\DCS AMERICAS\REMWEST\F464\P66 Former KC Refinery\2.Workspace\20240923\P66_Figure -2 MonitoringWellNetwork.mxd

**Legend**

- MW Gauge Only
- MW Gauge/Sample
- MW Abandoned
- Darby MW Gauge Only
- Darby MW Gauge/Sample
- Post-CAS Annual MW Gauge/Sample
- Active Area
- General Motors
- Inactive Area
- Magellan Pipeline Company
- Texwood Area

N W E S

0 500 1,000 Feet

1 inch = 1,000 feet

AECOM
8300 College Blvd. Suite 200
Overland Park, KS 66210

CLIENT: Phillips 66 Remediation Management

SITE: Former Phillips Refinery

TITLE: Post-CAS Groundwater Monitoring and Recovery System Network

| DRAWN BY | CHECKED BY | APPROVED BY |
|---|---|---|
| NLA | KGS | JW |
| PROJECT No. 60735045 | DATE SEPT. 2024 | FIGURE NO 2 |