KOLAR Document ID: 1800159

WELL ID

KOLAR DOC ID_

WATER WELL RECORD (WWC-5)

Latitude	Longitude		Section		Township	Range	E W Fraction	1/4	1/4	1/4
Datum	Elevation		County		•		, vv j			
VATER WELL OWNER		WELL	WATER U	JSE			PERMIT & ID NUMBE	ERS (AS REQUIF	RED)	
Name							DWR Application No	n:		
Business		WELL	WELL INFORMATION				KDHE / EPA Project Code:			
Address		Depth of well:ft.				Site Name: KDHE UIC Class V Form Completed: Yes No				
			Dry well							
Well location at owner's address			Static water level in well: ft. measured below land surface on (mm/dd/yy):				County Permit: Yes No Permit ID: Lease Name & Well #: # of boreholes: # of dewatering wells:			
			measured above land surface on (mm/dd/yy):							
ASING		GROU	T & PLU	GGING N	MATERIALS					
Type of blank casing used: Casing type details:		_ Gı	rout or Pl interval		Material		Description			
Blank casing diameter		Fro	om	То						
Was casing removed?										
Top of casing is currer	ntlyfeet ground									
feet below ground sur	of casing is now less than 5 face for a hand dug well or ground surface for all other									
types of wells.		СОММ	COMMENTS							
CONTRACTOR'S OR L	ANDOWNERS CERTIFICAT	ION								
This water well was	plugged pursuant to the	stated water	well co	ntractor'	's license and was	s completed	l on	I certify that tl	his	
record is true to the	best of my knowledge ar				=		under the License No			


Send one copy to WATER WELL OWNER and retain one for your records.

person at its submittal



Figure 1-Johns' Sludge Pond Site Map



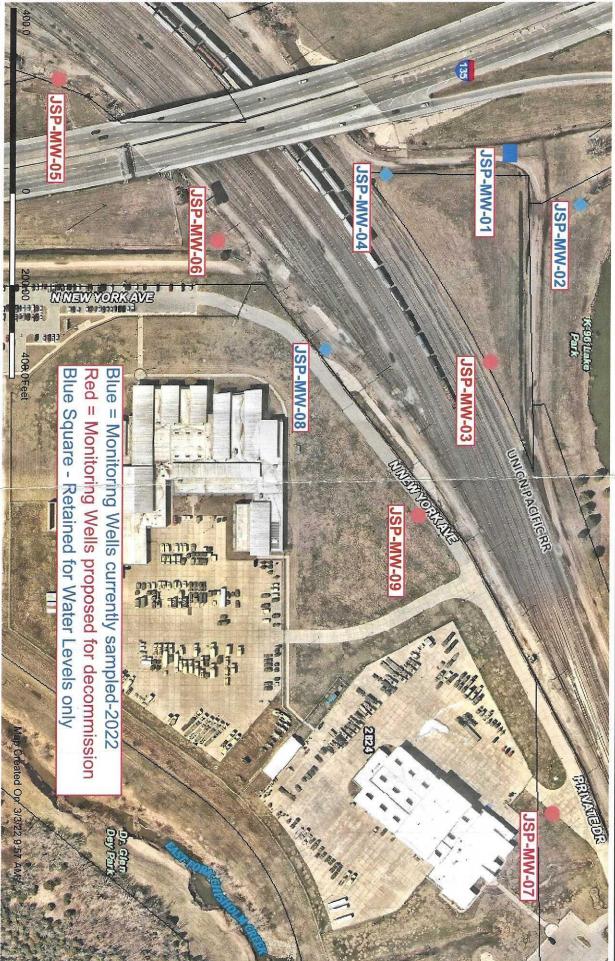

This information is not an official record, and cannot be used as such. The user should rely only upon official records available from the custodian of records in the appropriate City and/or County department. Some data provided here and used for the preparation of these maps has been obtained from public records not created or maintained by the City of Wichita.



