

WATER WELL RECORD (WWC-5)

KOLAR DOC ID _____ WELL ID _____

LOCATION OF WATER WELL

Latitude		Longitude		Section		Township		Range		E W	Fraction	¼	¼	¼
Datum		Elevation		County										

WATER WELL OWNER

Name	
Business	
Address	
Well location at owner's address	

WELL WATER USE

--

WELL INFORMATION

Depth of well: _____ ft.
Dry well
Static water level in well: _____ ft. measured below land surface on (mm/dd/yy): _____
measured above land surface on (mm/dd/yy): _____

PERMIT & ID NUMBERS (AS REQUIRED)

DWR Application No.: _____
KDHE / EPA Project Code: _____
Site Name: _____
KDHE UIC Class V Form Completed: Yes No
County Permit: Yes No Permit ID: _____
Lease Name & Well #: _____
of boreholes: _____ # of dewatering wells: _____

CASING

Type of blank casing used: _____
Casing type details: _____
Blank casing diameter: _____ inches
Was casing removed? Yes No
Top of casing is currently _____ feet _____ ground
Reason required if top of casing is now less than 5 feet below ground surface for a hand dug well or less than 3 feet below ground surface for all other types of wells.

GROUT & PLUGGING MATERIALS

Grout or Plugging interval (ft.)		Material	Description
From	To		


COMMENTS

--

CONTRACTOR'S OR LANDOWNERS CERTIFICATION

<p>This water well was plugged pursuant to the stated water well contractor's license and was completed on _____. I certify that this record is true to the best of my knowledge and belief. This water well record was completed on _____ under the business name of _____, Kansas Water Well Contractor's License No. _____ under the authority of the designated person as defined in K.A.R. 28-30-2(j) and signed and certified by the electronic signature of the designated person at its submittal _____.</p>
--

Send one copy to WATER WELL OWNER and retain one for your records.

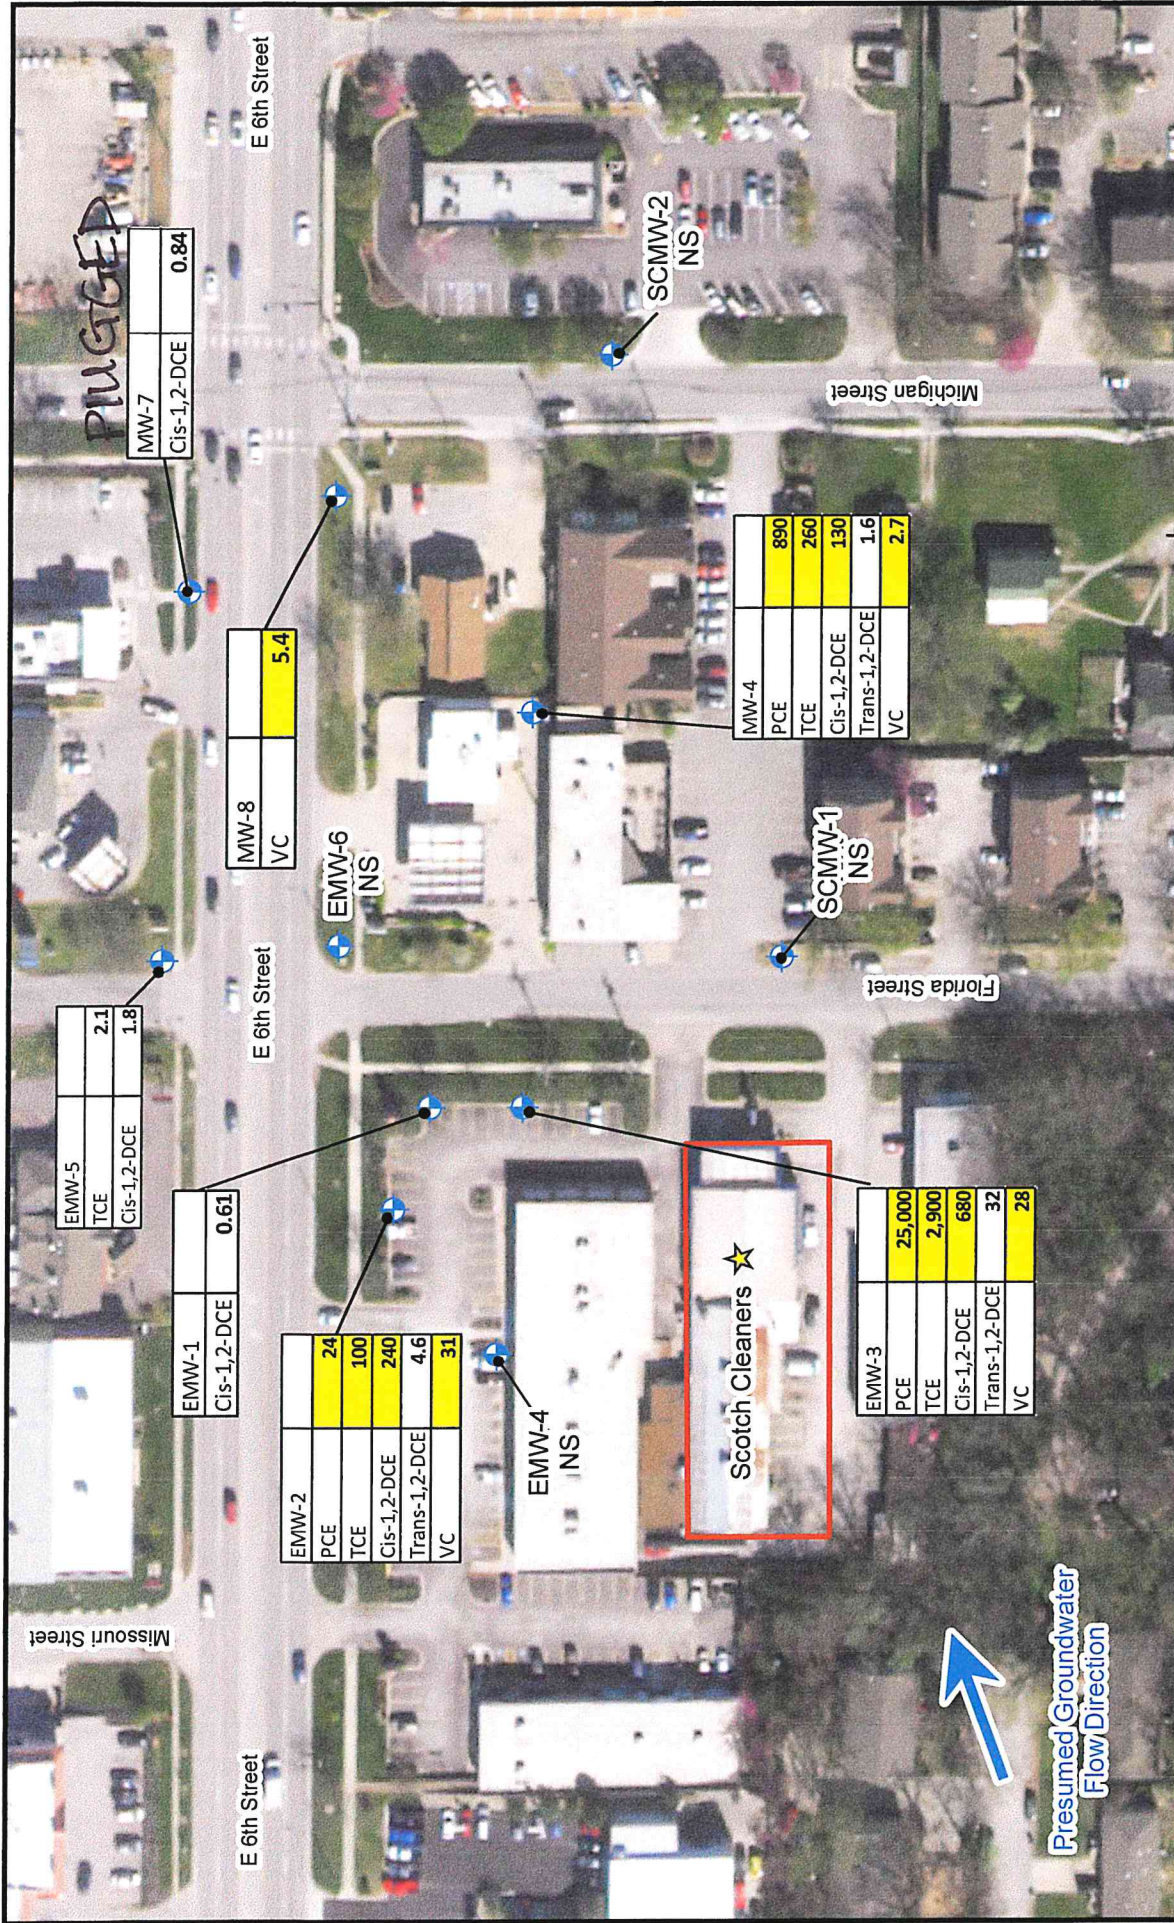

PIUGGED

MW-7	
Cis-1,2-DCE	0.84

MW-8	
VC	5.4

MW-4	
PCE	890
TCE	260
Cis-1,2-DCE	130
Trans-1,2-DCE	1.6
VC	2.7

EMW-5	
TCE	2.1
Cis-1,2-DCE	1.8

EMW-1	
Cis-1,2-DCE	0.61

EMW-2	
PCE	24
TCE	100
Cis-1,2-DCE	240
Trans-1,2-DCE	4.6
VC	31

EMW-3	
PCE	25,000
TCE	2,900
Cis-1,2-DCE	680
Trans-1,2-DCE	32
VC	28



Comments:
 All values reported in micrograms per liter
 PCE - Tetrachloroethylene
 TCE - Trichloroethylene
 VC - Vinyl Chloride
 Cis-1,2-DCE - Dichloroethylene
 Trans-1,2-DCE - Dichloroethylene
 NS - Not Sampled
 Bold & Highlighted = Above RSK

- Legend**
- ★ Site
 - Site Boundary
 - ⊕ Monitoring Well
- 0 100 200 Feet

SITE: Scotch Dry Cleaners
Lawrence, Kansas

TITLE: Groundwater Analytical Results
Monitoring Wells

PROJECT PHASE: LTM

DRAWN BY: SRH
CHECKED BY: JD

BASEMAP DATE: 2013

Figure 3