

KANSAS CORPORATION COMMISSION
OIL & GAS CONSERVATION DIVISION

Form ACO-18
Form must be typed
Form must be signed
May 2009

**APPLICATION FOR VENTING OR FLARING
OF GAS OTHER THAN CASINGHEAD GAS (K.A.R. 82-3-314)**

Venting / Flaring
ID # _____

Operator Information:

OPERATOR: License # _____
Name: _____
Address 1: _____
Address 2: _____
City: _____ State: _____ Zip: _____ + _____
Contact Person: _____
Phone: (_____) _____

Well Information:

API No. 15 - _____
Spot Description: _____
____ - ____ - ____ Sec. ____ Twp. ____ S. R. ____ East West
_____ Feet from North / South Line of Section
_____ Feet from East / West Line of Section
County: _____
Lease Name: _____ Well #: _____

A. Formation/Interval and estimated BTU Value of gas to be vented:

Formation: _____ Interval: _____ Estimated BTU Value: _____

B. Expected Maximum Gas Vented Volume:

Formation: _____ BOPD: _____ MCFPD: _____ BWPD: _____

C. Distance to the nearest pipeline or gathering facility: _____

Include the following attachments for all applications:

- 1. Wireline log of subject well, if available. If not available attach, a written explanation why not available.
- 2. Completed Well Completion form for the subject well, Form ACO-1.
- 3. Method of measuring vented / flared gas.
- 4. Written explanation of why venting or flaring is necessary.
- 5. Signed certificate showing service of the application and affidavit of publication as required in K.A.R. 82-3-135a.

Include the following for coalbed natural gas venting applications only:

- 6. Plat Map including location of subject well, all other wells on subject lease and all wells on offsetting leases. Include the names and address of offsetting operators.
- 7. Completed Affidavit for Venting of Coalbed Natural Gas, Form CG-4.

AFFIDAVIT

I am the affiant and I hereby certify that to the best of my current information, knowledge and personal belief, this request to vent/flare natural gas is true and proper and I have no information or knowledge, which is inconsistent with the information supplied in this application.

KCC Office Use Only

Denied Approved Permit Expires: _____

15-Day Periods Ends: _____

Approved By: _____ Date: _____

Submitted Electronically


Protests may be filed by any party having a valid interest in the application. Protests must be in writing and comply with K.A.R. 82-3-135b and must be filed within 15 days of publication of the notice of the application.

ELK CITY TESTING

Elk City Storage Field

Legend

-  ELK CITY
-  Wells

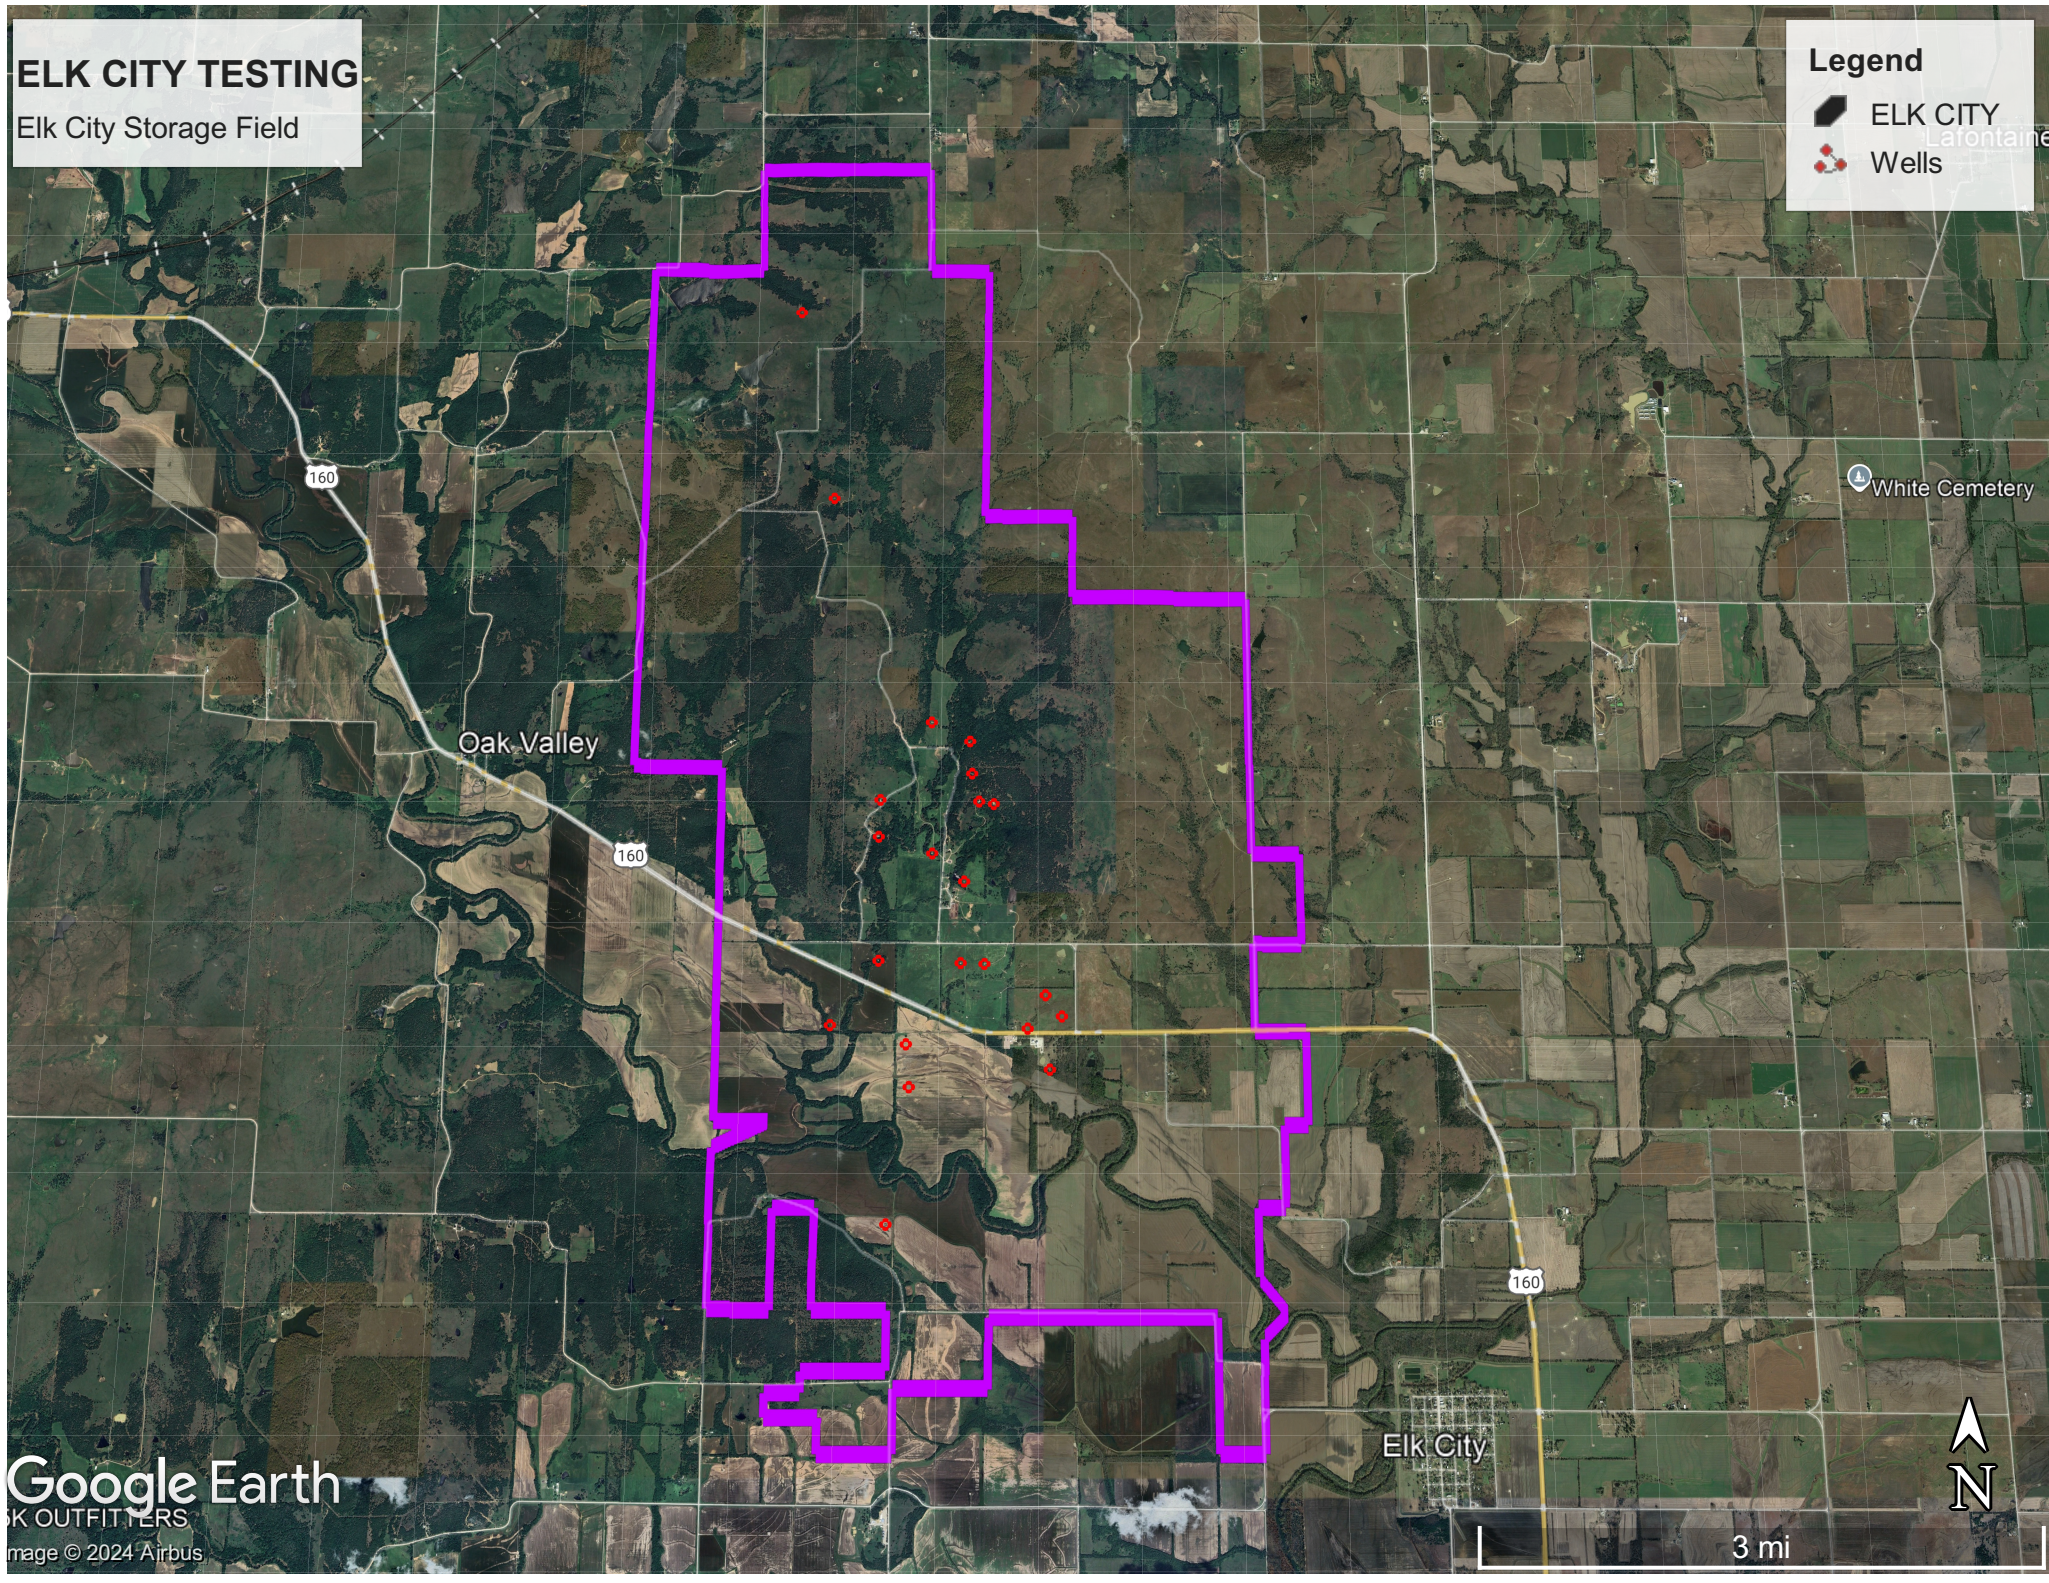

Elk City

3 mi



White Cemetery

Oak Valley

160

160

160

Appendix B – Recommended Procedure for Drawdown/Buildup Testing

The following procedure is a recommended test design for a drawdown/buildup test with the well flowed to a flare stack. We have used similar test designs for other storage operators with great success. The test is designed as a 4-point flow-after-flow drawdown test with an overnight buildup.

1. Rig up slickline and flow equipment, run in hole with bottomhole pressure gauges, tag TD and pick up 5' off bottom or pull up to the bottom of the perf interval.
 - a. Flow measurement will use a flow prover inline just before the flare stack.
2. Slowly open the well and begin flowing to the flare.
3. Hold a constant flowrate on the well for 1.5 hours, then open the choke to allow more flowrate into the well. Continue this process for a total of 4 flow points. Target flowrates are as follows:
 - a. Rate 1 (1.5 hours) – $\Delta P \sim 5\%$ (shut-in pressure – stabilized flowing pressure)
 - b. Rate 2 (1.5 hours) – $\Delta P \sim 10\%$ (shut-in pressure – stabilized flowing pressure)
 - c. Rate 3 (1.5 hours) – $\Delta P \sim 15\%$ (shut-in pressure – stabilized flowing pressure)
 - d. Rate 4 (1.5 hours) – $\Delta P \sim 20\%$ (shut-in pressure – stabilized flowing pressure)
4. Once all four flow periods are complete (total of 6 hours of continuous flow), shut in the well and leave bottomhole gauges hanging in the well overnight.
5. The following morning, pull gauges out of the hole, rig down and move to the next location.

Barring any delays, the above procedure should result in 1 well tested per day.

*FyreRock will provide slickline unit, pressure control, bottomhole and surface pressure gauges, orifice meter trailer or ultrasonic meter for flow measurement, flow iron, separator, flare stack.

*Southern Star proposes to conduct testing on 23 wells, one well at a time, with no concurrent flaring





The Beaufort Gazette
 The Belleville News-Democrat
 Bellingham Herald
 Centre Daily Times
 Sun Herald
 Idaho Statesman
 Bradenton Herald
 The Charlotte Observer
 The State
 Ledger-Enquirer

Durham | The Herald-Sun
 Fort Worth Star-Telegram
 The Fresno Bee
 The Island Packet
 The Kansas City Star
 Lexington Herald-Leader
 The Telegraph - Macon
 Merced Sun-Star
 Miami Herald
 El Nuevo Herald

The Modesto Bee
 The Sun News - Myrtle Beach
 Raleigh News & Observer
 Rock Hill | The Herald
 The Sacramento Bee
 San Luis Obispo Tribune
 Tacoma | The News Tribune
 Tri-City Herald
 The Wichita Eagle
 The Olympian

AFFIDAVIT OF PUBLICATION

Account #	Order Number	Identification	Order PO	Amount	Cols	Depth
147422	602411	Print Legal Ad-IPL01993180 - IPL0199318		\$38.00	1	39 L

Attention: Carly Walton

Carly Walton
 4700 State Route 56
 Owensboro, KY 42301

Carly.Walton@southernstar.com

To Whom It May Concern:

This is to certify the legal advertisement in the above stated case was published in **The Wichita Eagle** legal section on:

1 insertion(s) published on:
 10/16/24

By placing your legal organ advertisement with this newspaper, you agree that your sole remedy if the newspaper should make a mistake in the text or the timing of publication of your advertisement is a refund of the cost you paid for the advertisement or re-advertisement at no additional cost to you.

Southern Star Central Gas Pipeline
 Elk City Storage Field
 Elk and Montgomery Counties, KS
 November 5th and up to December 6th of 2024, and may last up to 6 hours per day.

Case Full Name	API#	Lat	Long
EN 0-67	15-048-21056-00-00	37.38265	-95.9754
EN 04	15-048-21056-00-01	37.3809384	-95.97147961
EN 0-53	15-048-19060-00-00	37.3700038	-95.9610584
EN 0-58	15-048-18059-00-00	37.34170978	-95.97100132
EN 17	15-125-11037-00-01	37.3181077	-95.96802643
EN 50	15-125-11030-00-01	37.31676	-95.9613
EN 44	15-125-10999-00-00	37.3101481	-95.9611111
EN 42	15-125-10995-00-01	37.31142955	-95.951206
EN 40	15-125-10993-00-01	37.3103951	-95.96107137
EN 35	15-125-10988-00-01	37.31411363	-95.94921889
EN 31	15-125-10986-00-01	37.3104961	-95.94761
EN 30	15-125-10983-00-00	37.31640384	-95.95441775
EN 29	15-125-10982-00-01	37.31671468	-95.95786761
EN 27	15-048-18052-00-01	37.31009	-95.9662
EN 17	15-125-19974-00-01	37.3137244	-95.96755199
EN 15	15-125-19972-00-01	37.31371807	-95.96838179
EN 12	15-125-19969-00-01	37.31391413	-95.96444435
EN 11	15-125-19968-00-01	37.31394	-95.95605
EN 8	15-048-18058-00-01	37.313706	-95.96614131
EN 7	15-048-18051-00-01	37.34013	-95.96621
EN 3	15-125-19962-00-01	37.34013	-95.95668
EN 2	15-125-19961-00-01	37.3401046	-95.96701446
EN 1	15-125-19960-00-01	37.34040718	-95.96100597

Notification of Oil and Gas Operations affidavit of publication as required in K.A.R. 82-3-135a

Southern Star Central Gas Pipeline
 4700 State Route 56
 Owensboro, KY 42301

Please find official notice of flaring operations to be held in Southern Star's Elk City Storage Field located in Montgomery County, KS and Elk County, KS. These operations will be held each day from November 5th and up to December 6th of 2024, and may last up to 6 hours per day. For any interested parties, please reach out to Karen Goedde with Corporate Communications.


Southern Star Central Gas Pipeline
 IPL0199318
 Oct 16 2024

Willmenta Semons

Sworn to and subscribed before me this 16th day of October in the year of 2024

Margaret K. Wilson

Notary Public in and for the state of Texas, residing in Dallas County

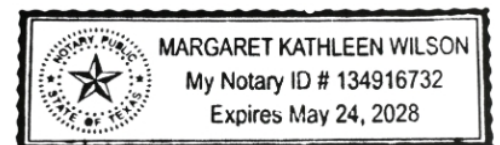

Extra charge for lost or duplicate affidavits.
 Legal document please do not destroy!

MONTGOMERY COUNTY
Chronicle

**P.O. Box 186 • 202 W. Fourth • Caney, KS 67333 • (620) 879-2156
422 W. Main • Independence, KS 67301 • (620) 577-4053**

AFFIDAVIT OF PUBLICATION

SOUTHERN STAR CENTRAL GAS PIPELINE

**NOTICE OF FLARING OPERATIONS
IN ELK CITY STORAGE FIELD**

Andrew R. Taylor of lawful age, being duly sworn, deposes and says he or she represents the publisher of:

Montgomery County Chronicle

P.O. Box 186 • 202 W. Fourth • Caney, KS 67333

a weekly newspaper in the City of Caney, County of Montgomery, State of Kansas, and of general circulation in said county and which has been admitted to the U.S. Mail as a second class matter in said county, and which said newspaper has been continuously and uninterruptedly published in said county during the period of one year immediately prior to the first publication of the notice hereinafter mentioned.

Legal notice publication printed one (1) week,
first published on Thursday, October 17, 2024
and again on ---.

The affiant further says that he or she has personal knowledge of the statements above set forth and that they are true.

Publication costs: \$42.50



Signature

State of Kansas, Montgomery County.

Subscribed and sworn to before me

this 17th day of October, 2024.



(Published in the Montgomery County Chronicle on Thursday, Oct. 17, 2024)

NOTICE OF FLARING OPERATIONS IN ELK CITY STORAGE FIELD

Southern Star Central Gas Pipeline is notifying the public of flaring operations to be held in Southern Star's Elk City Storage Field located in Montgomery County and Elk County, Kansas. The flaring operations will be held each day from Nov. 5 and up to Dec. 6 and may last up to six hours per day.

For more information, contact Karen Goedde with Southern Star corporate communications in Owensboro, Ky.



(Published in the Prairie Star on Thursday, Oct. 17, 2024)

NOTICE OF FLARING OPERATIONS IN ELK CITY STORAGE FIELD

Southern Star Central Gas Pipeline is notifying the public of flaring operations to be held in Southern Star's Elk City Storage Field located in Montgomery County and Elk County, Kansas. The flaring operations will be held each day from Nov. 5 and up to Dec. 6 and may last up to six hours per day.

For more information, contact Karen Goedde with Southern Star corporate communications in Owensboro, Ky.





Southern Star Central Gas Pipeline, Inc.
6300 S. Rangeline Rd.
Joplin, MO 64804

FIRST CLASS MAIL

Tract # D819/009, 001, SL32475
Pipeline Elk O-67, 64, 7

October 14, 2024

Westfall Brothers LLC
1429 Woodbury Dr.
Liberty, MO 64068

Re: C0003331 Develop Reservoir Simulation Model
Location: NW/4 Sec 3, NE/4 Sec 10, & NE/4 Sec 22 T31S R13E Elk County, Kansas

Dear Landowner:

Description of Project Activity:

Southern Star will be conducting deliverability tests on individual wells within the Elk City gas storage field, part of which is on your property. Testing is planned to start on or near November 5th and conclude on or before December 6th, 2024. The planned testing involves flaring gas for approximately 6 hours a day, every day except Sunday.

Regulatory Information:

As you may be aware, Southern Star Central Gas Pipeline, Inc., (Southern Star) owns and operates a natural gas pipeline and storage field on or near your property at the above referenced location pursuant to an existing easement agreement. This letter is providing notice of Southern Star's intent to perform the above described maintenance activities.

Pursuant to Section 2.55(a)(3) of the Regulations of the Federal Energy Regulatory Commission (FERC), Southern Star Central Gas Pipeline, Inc. (Southern Star) is required to give you written notification at least 5-days prior to commencement of any ground-disturbing maintenance activities within its existing right-of way on your property. Upon receipt of all required environmental and cultural resource permits, Southern Star is authorized to proceed with the above described maintenance to its existing facilities without prior notice to the FERC or a separate docket number being assigned.

Landowner Information:

Should you have questions or concerns regarding the project, please contact Allen Reed at **620-330-7248** so that we may discuss and resolve those concerns. Upon completion of the work, either I or another company representative will contact you to discuss any concerns you may have and to settle any damage claims that may have occurred. Southern Star also has a FERC Compliance helpline (**1-800-769-9165**) that you may call if you believe your concerns and issues are not being adequately addressed. If you do place a call to the helpline, please indicate that you are a landowner calling about Southern Star's project C0003331 Develop Reservoir Simulation Model in Storage Field Elk County, KS and provide your name, phone number, address and specific details of your concerns.

Landowner Rights Under the FERC Regulations:

Any person affected by either the construction or operation of a certificated or authorized natural gas project under the Natural Gas Act or by the construction or operation of a project under the Federal Power Act may seek the informal resolution of a dispute by contacting the Commission's Landowner Helpline. The Helpline may be reached by calling toll free **1-877-337-2237**, by e-mail at LandownerHelp@ferc.gov, or writing to: Commission's Landowner Helpline, Federal Energy Regulatory Commission, 888 First Street NE., Washington, DC 20426.

Contact Information For Landowners:

After the project is completed, either I or another company representative will contact you to discuss any concerns you may have and to settle any damage claims that may have occurred. Southern Star has a FERC Compliance helpline **(1-800-769-9165)** that you may call if you believe your concerns and issues are not being adequately addressed.


Southern Star Contact Information For Landowners:


It is Southern Star's policy to make every effort to keep you well informed of activities that affect your property and to achieve satisfactory land restoration upon completion of the job. If you have any concerns about this project now or at any time during or upon completion, please do not hesitate to contact me by phone at **(620)330-7248** or by email at allen.reed@southernstar.com

Sincerely,



Allen Reed
Land Representative
Southern Star Central Gas Pipeline, Inc.
620-330-7248

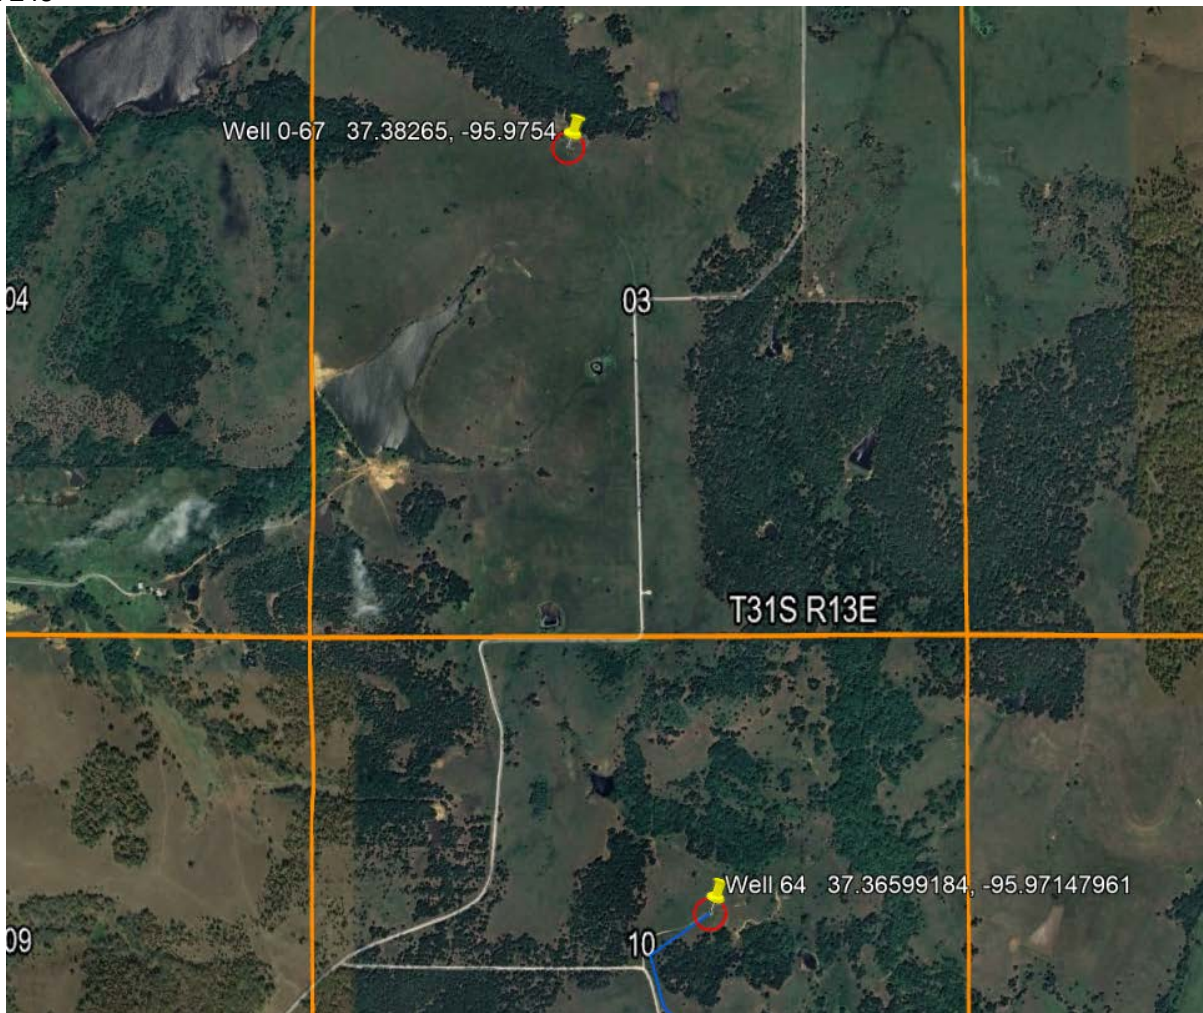

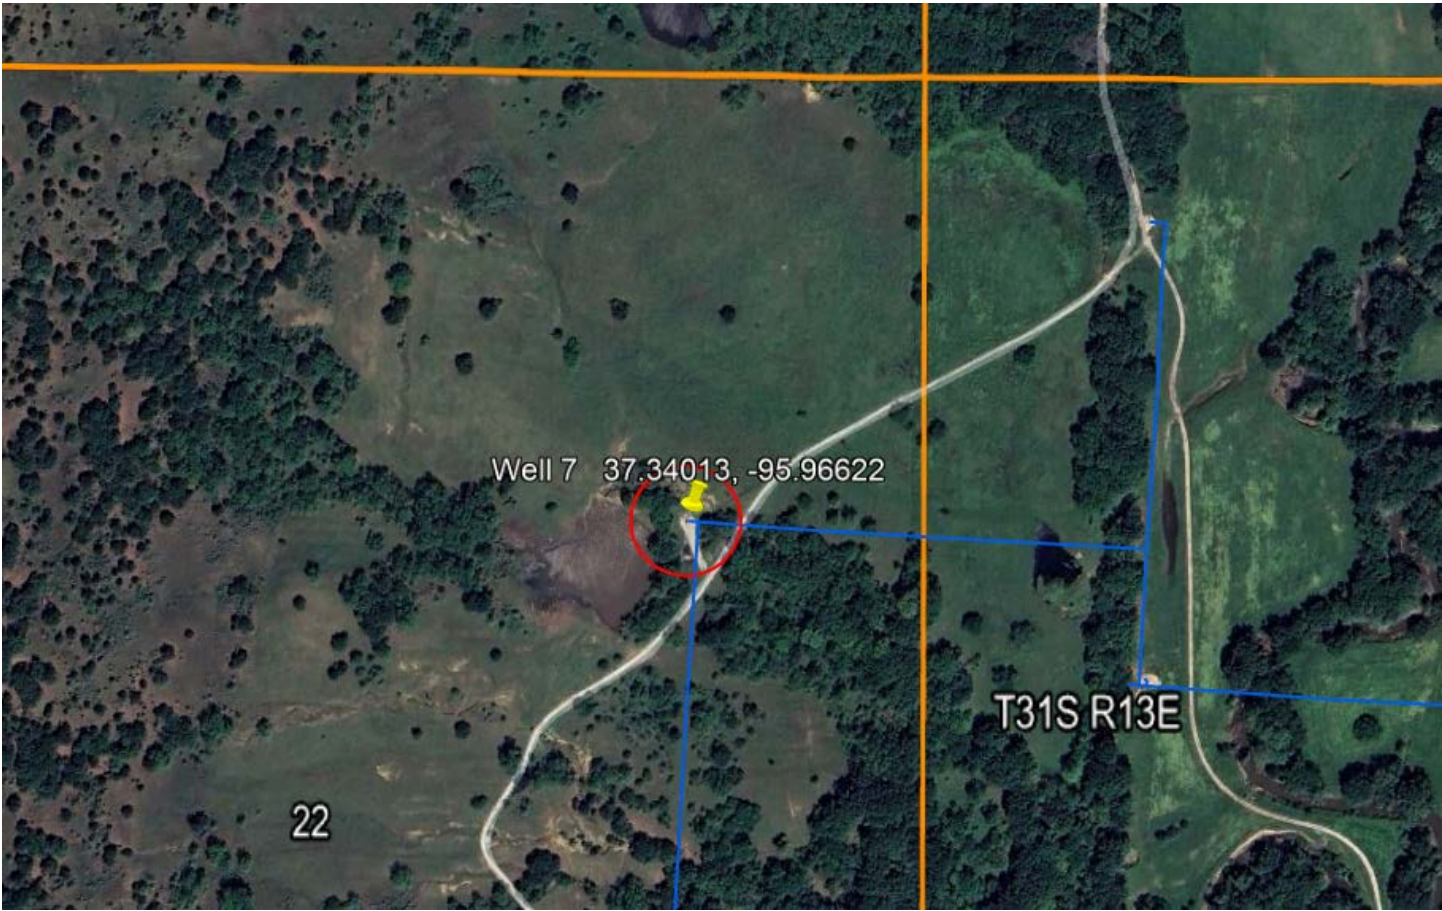



Southern Star Central Gas Pipeline, Inc.
6300 S. Rangeline Rd.
Joplin, MO 64804

FIRST CLASS MAIL

Tract # SL32470
Pipeline Elk O-59

October 14, 2024

Michael Dodson
850 Court Dr.
Independence, KS 67301

Re: C0003331 Develop Reservoir Simulation Model
Location: SE/4 Sec 34 T31S R13E Elk County, Kansas

Dear Landowner:

Description of Project Activity:

Southern Star will be conducting deliverability tests on individual wells within the Elk City gas storage field, part of which is on your property. Testing is planned to start on or near November 5th and conclude on or before December 6th, 2024. The planned testing involves flaring gas for approximately 6 hours a day, every day except Sunday.

Regulatory Information:

As you may be aware, Southern Star Central Gas Pipeline, Inc., (Southern Star) owns and operates a natural gas pipeline and storage field on or near your property at the above referenced location pursuant to an existing easement agreement. This letter is providing notice of Southern Star's intent to perform the above described maintenance activities.

Pursuant to Section 2.55(a)(3) of the Regulations of the Federal Energy Regulatory Commission (FERC), Southern Star Central Gas Pipeline, Inc. (Southern Star) is required to give you written notification at least 5-days prior to commencement of any ground-disturbing maintenance activities within its existing right-of way on your property. Upon receipt of all required environmental and cultural resource permits, Southern Star is authorized to proceed with the above described maintenance to its existing facilities without prior notice to the FERC or a separate docket number being assigned.

Landowner Information:

Should you have questions or concerns regarding the project, please contact Allen Reed at **620-330-7248** so that we may discuss and resolve those concerns. Upon completion of the work, either I or another company representative will contact you to discuss any concerns you may have and to settle any damage claims that may have occurred. Southern Star also has a FERC Compliance helpline (**1-800-769-9165**) that you may call if you believe your concerns and issues are not being adequately addressed. If you do place a call to the helpline, please indicate that you are a landowner calling about Southern Star's project C0003331 Develop Reservoir Simulation Model in Storage Field Elk County, KS and provide your name, phone number, address and specific details of your concerns.

Landowner Rights Under the FERC Regulations:

Any person affected by either the construction or operation of a certificated or authorized natural gas project under the Natural Gas Act or by the construction or operation of a project under the Federal Power Act may seek the informal resolution of a dispute by contacting the Commission's Landowner Helpline. The Helpline may be reached by calling toll free **1-877-337-2237**, by e-mail at LandownerHelp@ferc.gov, or writing to: Commission's Landowner Helpline, Federal Energy Regulatory Commission, 888 First Street NE., Washington, DC 20426.

Contact Information For Landowners:

After the project is completed, either I or another company representative will contact you to discuss any concerns you may have and to settle any damage claims that may have occurred. Southern Star has a FERC Compliance helpline **(1-800-769-9165)** that you may call if you believe your concerns and issues are not being adequately addressed.


Southern Star Contact Information For Landowners:

It is Southern Star's policy to make every effort to keep you well informed of activities that affect your property and to achieve satisfactory land restoration upon completion of the job. If you have any concerns about this project now or at any time during or upon completion, please do not hesitate to contact me by phone at **(620)330-7248** or by email at allen.reed@southernstar.com

Sincerely,



Allen Reed
Land Representative
Southern Star Central Gas Pipeline, Inc.
620-330-7248

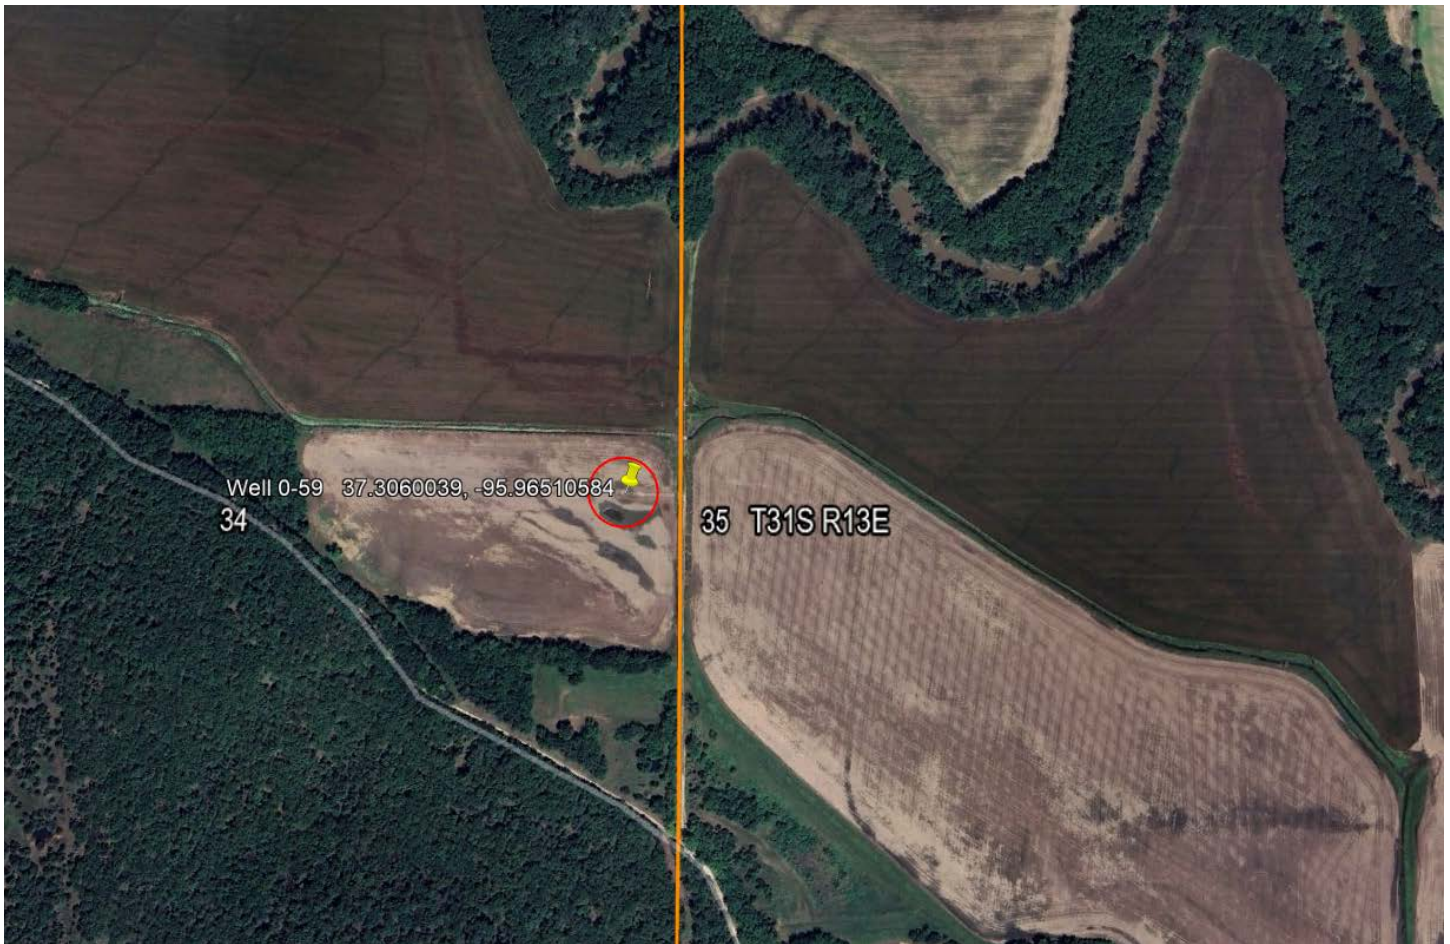



Southern Star Central Gas Pipeline, Inc.
6300 S. Rangeline Rd.
Joplin, MO 64804

FIRST CLASS MAIL

Tract # SL32475
Pipeline Elk O-58, 27

October 14, 2024

Edwin Neal Amick
211 HOH ST SE, APT 239
Lacey, WA 98516

Re: C0003331 Develop Reservoir Simulation Model
Location: NE/4 Sec 27 T31S R13E Elk County, Kansas

Dear Landowner:

Description of Project Activity:

Southern Star will be conducting deliverability tests on individual wells within the Elk City gas storage field, part of which is on your property. Testing is planned to start on or near November 5th and conclude on or before December 6th, 2024. The planned testing involves flaring gas for approximately 6 hours a day, every day except Sunday. We will also be clearing woody vegetation within a 100' – 150' radius of the flare location at well 27.

Regulatory Information:

As you may be aware, Southern Star Central Gas Pipeline, Inc., (Southern Star) owns and operates a natural gas pipeline and storage field on or near your property at the above referenced location pursuant to an existing easement agreement. This letter is providing notice of Southern Star's intent to perform the above described maintenance activities.

Pursuant to Section 2.55(a)(3) of the Regulations of the Federal Energy Regulatory Commission (FERC), Southern Star Central Gas Pipeline, Inc. (Southern Star) is required to give you written notification at least 5-days prior to commencement of any ground-disturbing maintenance activities within its existing right-of way on your property. Upon receipt of all required environmental and cultural resource permits, Southern Star is authorized to proceed with the above described maintenance to its existing facilities without prior notice to the FERC or a separate docket number being assigned.

Landowner Information:

Should you have questions or concerns regarding the project, please contact Allen Reed at **620-330-7248** so that we may discuss and resolve those concerns. Upon completion of the work, either I or another company representative will contact you to discuss any concerns you may have and to settle any damage claims that may have occurred. Southern Star also has a FERC Compliance helpline (**1-800-769-9165**) that you may call if you believe your concerns and issues are not being adequately addressed. If you do place a call to the helpline, please indicate that you are a landowner calling about Southern Star's project C0003331 Develop Reservoir Simulation Model in Storage Field Elk County, KS and provide your name, phone number, address and specific details of your concerns.

Landowner Rights Under the FERC Regulations:

Any person affected by either the construction or operation of a certificated or authorized natural gas project under the Natural Gas Act or by the construction or operation of a project under the Federal Power Act may seek the informal resolution of a dispute by contacting the Commission's Landowner Helpline. The Helpline may be reached by calling toll free **1-877-337-2237**, by e-mail at LandownerHelp@ferc.gov, or writing to: Commission's Landowner Helpline, Federal Energy Regulatory Commission, 888 First Street NE., Washington, DC 20426.

Contact Information For Landowners:

After the project is completed, either I or another company representative will contact you to discuss any concerns you may have and to settle any damage claims that may have occurred. Southern Star has a FERC Compliance helpline **(1-800-769-9165)** that you may call if you believe your concerns and issues are not being adequately addressed.


Southern Star Contact Information For Landowners:

It is Southern Star's policy to make every effort to keep you well informed of activities that affect your property and to achieve satisfactory land restoration upon completion of the job. If you have any concerns about this project now or at any time during or upon completion, please do not hesitate to contact me by phone at **(620)330-7248** or by email at allen.reed@southernstar.com

Sincerely,



Allen Reed
Land Representative
Southern Star Central Gas Pipeline, Inc.
620-330-7248

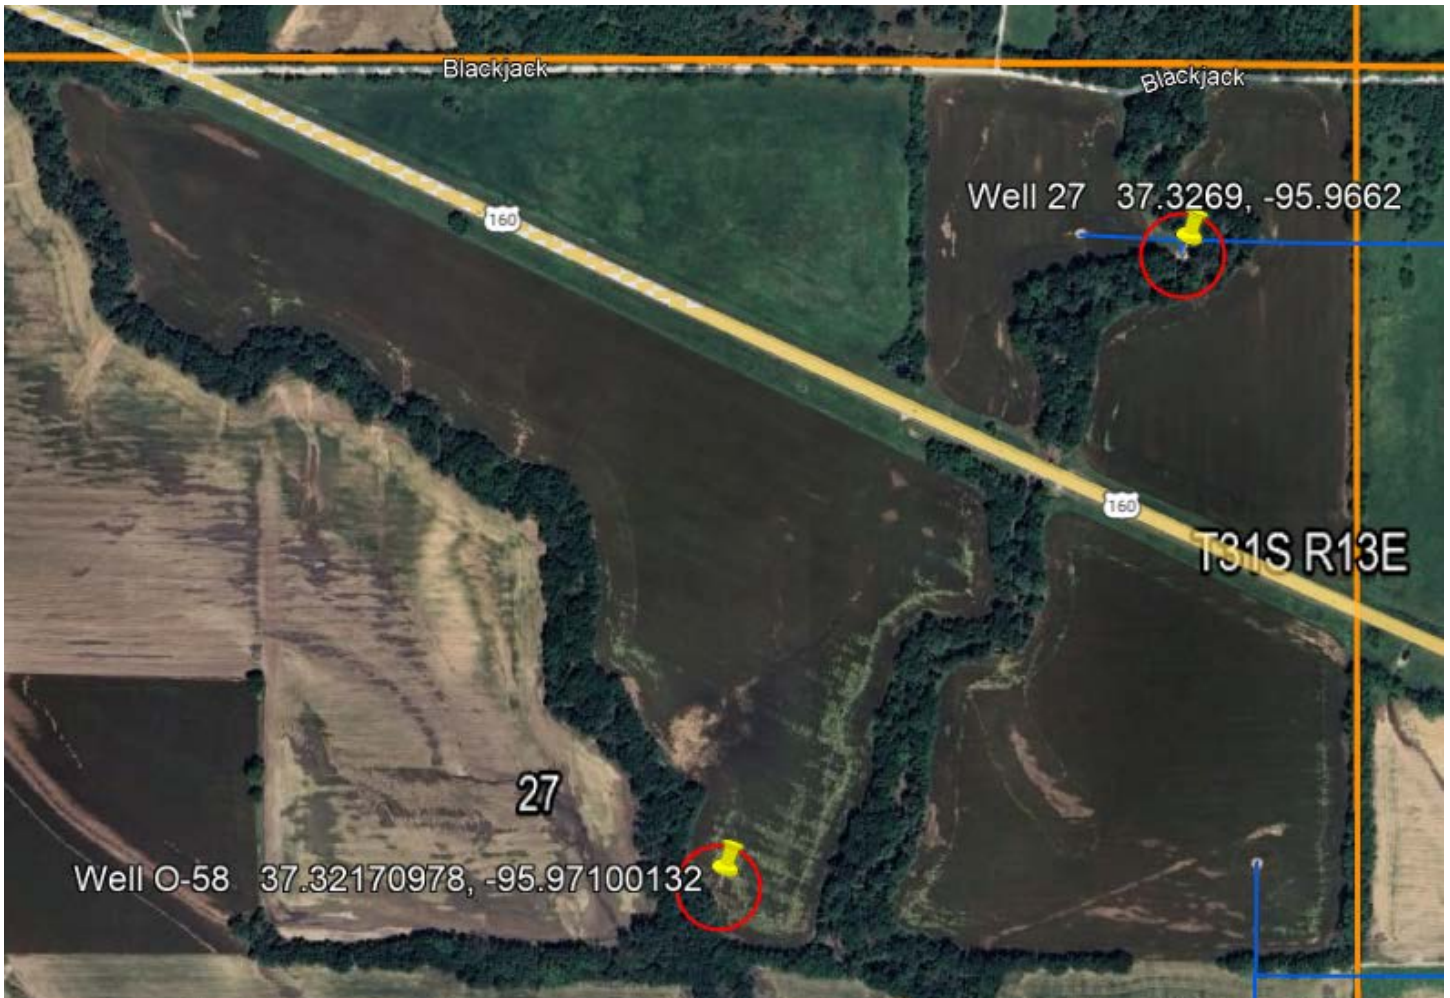



Southern Star Central Gas Pipeline, Inc.
6300 S. Rangeline Rd.
Joplin, MO 64804

FIRST CLASS MAIL

Tract # SL32472
Pipeline Elk 48, 50, 57

October 14, 2024

Jim G. Brenda K. Greer
6023 CR 2300
Elk City, KS 67344

Re: C0003331 Develop Reservoir Simulation Model
Location: SW/4 & SE/4 Sec 26 T31S R13E Montgomery County, Kansas

Dear Landowner:

Description of Project Activity:

Southern Star will be conducting deliverability tests on individual wells within the Elk City gas storage field, part of which is on your property. Testing is planned to start on or near November 5th and conclude on or before December 6th, 2024. The planned testing involves flaring gas for approximately 6 hours a day, every day except Sunday.

Regulatory Information:

As you may be aware, Southern Star Central Gas Pipeline, Inc., (Southern Star) owns and operates a natural gas pipeline and storage field on or near your property at the above referenced location pursuant to an existing easement agreement. This letter is providing notice of Southern Star's intent to perform the above described maintenance activities.

Pursuant to Section 2.55(a)(3) of the Regulations of the Federal Energy Regulatory Commission (FERC), Southern Star Central Gas Pipeline, Inc. (Southern Star) is required to give you written notification at least 5-days prior to commencement of any ground-disturbing maintenance activities within its existing right-of way on your property. Upon receipt of all required environmental and cultural resource permits, Southern Star is authorized to proceed with the above described maintenance to its existing facilities without prior notice to the FERC or a separate docket number being assigned.

Landowner Information:

Should you have questions or concerns regarding the project, please contact Allen Reed at **620-330-7248** so that we may discuss and resolve those concerns. Upon completion of the work, either I or another company representative will contact you to discuss any concerns you may have and to settle any damage claims that may have occurred. Southern Star also has a FERC Compliance helpline (**1-800-769-9165**) that you may call if you believe your concerns and issues are not being adequately addressed. If you do place a call to the helpline, please indicate that you are a landowner calling about Southern Star's project C0003331 Develop Reservoir Simulation Model in Storage Field Montgomery County, and provide your name, phone number, address and specific details of your concerns.

Landowner Rights Under the FERC Regulations:

Any person affected by either the construction or operation of a certificated or authorized natural gas project under the Natural Gas Act or by the construction or operation of a project under the Federal Power Act may seek the informal resolution of a dispute by contacting the Commission's Landowner Helpline. The Helpline may be reached by calling toll free **1-877-337-2237**, by e-mail at LandownerHelp@ferc.gov, or writing to: Commission's Landowner Helpline, Federal Energy Regulatory Commission, 888 First Street NE., Washington, DC 20426.

Contact Information For Landowners:

After the project is completed, either I or another company representative will contact you to discuss any concerns you may have and to settle any damage claims that may have occurred. Southern Star has a FERC Compliance helpline **(1-800-769-9165)** that you may call if you believe your concerns and issues are not being adequately addressed.

Southern Star Contact Information For Landowners:

It is Southern Star's policy to make every effort to keep you well informed of activities that affect your property and to achieve satisfactory land restoration upon completion of the job. If you have any concerns about this project now or at any time during or upon completion, please do not hesitate to contact me by phone at **(620)330-7248** or by email at allen.reed@southernstar.com

Sincerely,



Allen Reed
Land Representative
Southern Star Central Gas Pipeline, Inc.
620-330-7248





Southern Star Central Gas Pipeline, Inc.
6300 S. Rangeline Rd.
Joplin, MO 64804

FIRST CLASS MAIL

Tract # SL32473
Pipeline Elk 35, 40, 42

October 14, 2024

Glora Mae Brooks/William H Cox II
1571 CR 5425
Elk City, KS 67344

Re: C0003331 Develop Reservoir Simulation Model
Location: NE/4 Sec 26 T31S R13E Montgomery County, Kansas

Dear Landowner:

Description of Project Activity:

Southern Star will be conducting deliverability tests on individual wells within the Elk City gas storage field, part of which is on your property. Testing is planned to start on or near November 5th and conclude on or before December 6th, 2024. The planned testing involves flaring gas for approximately 6 hours a day, every day except Sunday.

Regulatory Information:

As you may be aware, Southern Star Central Gas Pipeline, Inc., (Southern Star) owns and operates a natural gas pipeline and storage field on or near your property at the above referenced location pursuant to an existing easement agreement. This letter is providing notice of Southern Star's intent to perform the above described maintenance activities.

Pursuant to Section 2.55(a)(3) of the Regulations of the Federal Energy Regulatory Commission (FERC), Southern Star Central Gas Pipeline, Inc. (Southern Star) is required to give you written notification at least 5-days prior to commencement of any ground-disturbing maintenance activities within its existing right-of way on your property. Upon receipt of all required environmental and cultural resource permits, Southern Star is authorized to proceed with the above described maintenance to its existing facilities without prior notice to the FERC or a separate docket number being assigned.

Landowner Information:

Should you have questions or concerns regarding the project, please contact Allen Reed at **620-330-7248** so that we may discuss and resolve those concerns. Upon completion of the work, either I or another company representative will contact you to discuss any concerns you may have and to settle any damage claims that may have occurred. Southern Star also has a FERC Compliance helpline (**1-800-769-9165**) that you may call if you believe your concerns and issues are not being adequately addressed. If you do place a call to the helpline, please indicate that you are a landowner calling about Southern Star's project C0003331 Develop Reservoir Simulation Model in Storage Field Montgomery County, KS and provide your name, phone number, address and specific details of your concerns.

Landowner Rights Under the FERC Regulations:

Any person affected by either the construction or operation of a certificated or authorized natural gas project under the Natural Gas Act or by the construction or operation of a project under the Federal Power Act may seek the informal resolution of a dispute by contacting the Commission's Landowner Helpline. The Helpline may be reached by calling toll free **1-877-337-2237**, by e-mail at LandownerHelp@ferc.gov, or writing to: Commission's Landowner Helpline, Federal Energy Regulatory Commission, 888 First Street NE., Washington, DC 20426.

Contact Information For Landowners:

After the project is completed, either I or another company representative will contact you to discuss any concerns you may have and to settle any damage claims that may have occurred. Southern Star has a FERC Compliance helpline **(1-800-769-9165)** that you may call if you believe your concerns and issues are not being adequately addressed.


Southern Star Contact Information For Landowners:

It is Southern Star's policy to make every effort to keep you well informed of activities that affect your property and to achieve satisfactory land restoration upon completion of the job. If you have any concerns about this project now or at any time during or upon completion, please do not hesitate to contact me by phone at **(620)330-7248** or by email at allen.reed@southernstar.com

Sincerely,



Allen Reed
Land Representative
Southern Star Central Gas Pipeline, Inc.
620-330-7248

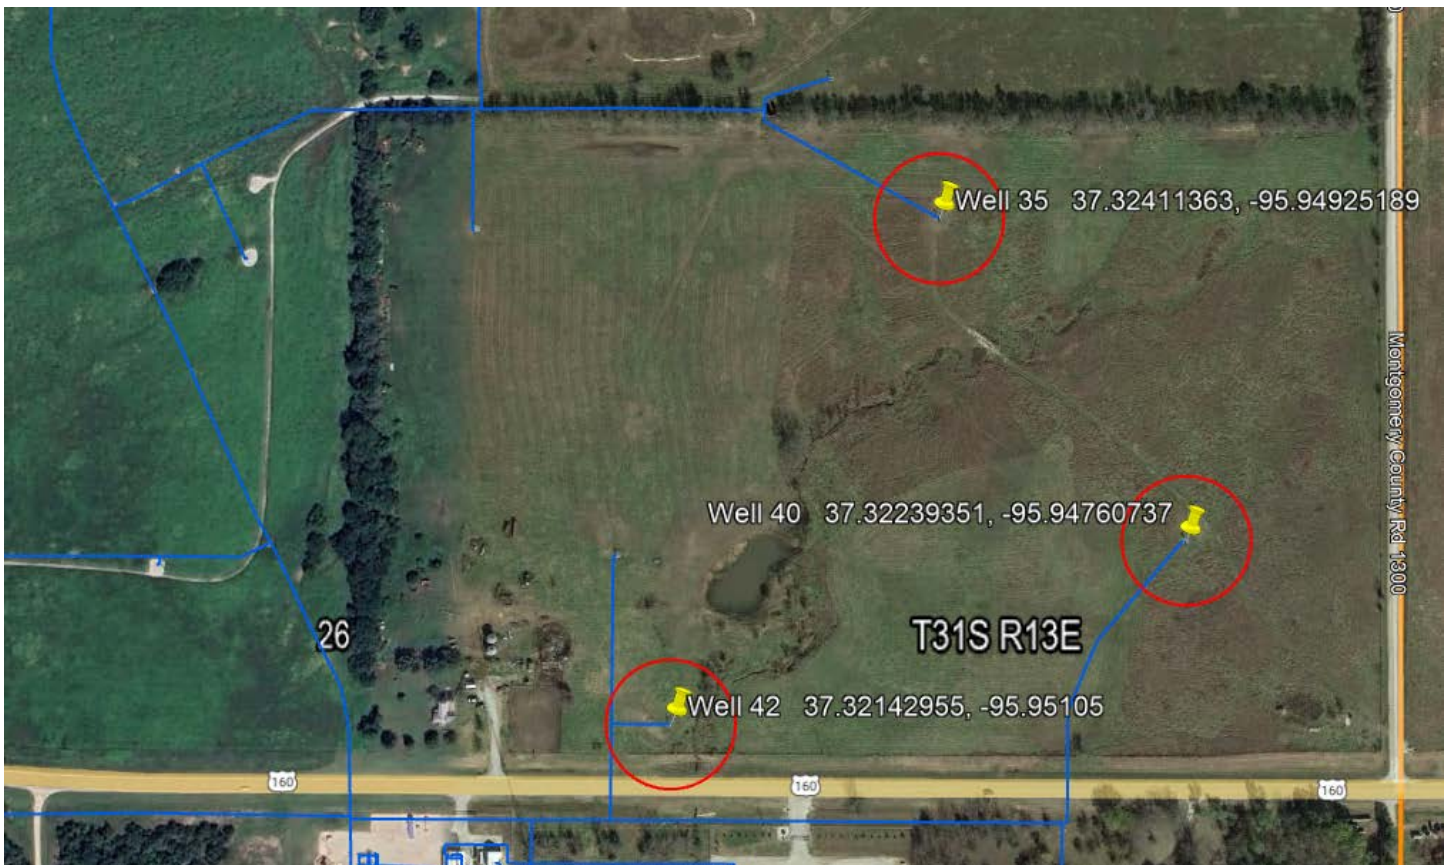



Southern Star Central Gas Pipeline, Inc.
6300 S. Rangeline Rd.
Joplin, MO 64804

FIRST CLASS MAIL

Tract # SL32472
Pipeline Elk 1, 2, 3, 8, 11, 12, 15, 17, 29, 30, 33

October 14, 2024

Westfall Brothers LLC
601 Englewood Dr.
Kearney, MO 64060

Re: C0003331 Develop Reservoir Simulation Model
Location: NE/4 Sec 22 Elk County, KS; SW/4 Sec 14; NW/4 & NE/4 & SW/4 Sec 23; & NW/4 Sec 26 T31S R13E
Montgomery County, Kansas

Dear Landowner:

Description of Project Activity:

Southern Star will be conducting deliverability tests on individual wells within the Elk City gas storage field, part of which is on your property. Testing is planned to start on or near November 5th and conclude on or before December 6th, 2024. The planned testing involves flaring gas for approximately 6 hours a day, every day except Sunday. We will also be clearing woody vegetation within a 100' – 150' radius of the flare location at wells 2, 3, 11, 12, & 15.

Regulatory Information:

As you may be aware, Southern Star Central Gas Pipeline, Inc., (Southern Star) owns and operates a natural gas pipeline and storage field on or near your property at the above referenced location pursuant to an existing easement agreement. This letter is providing notice of Southern Star's intent to perform the above described maintenance activities.

Pursuant to Section 2.55(a)(3) of the Regulations of the Federal Energy Regulatory Commission (FERC), Southern Star Central Gas Pipeline, Inc. (Southern Star) is required to give you written notification at least 5-days prior to commencement of any ground-disturbing maintenance activities within its existing right-of way on your property. Upon receipt of all required environmental and cultural resource permits, Southern Star is authorized to proceed with the above described maintenance to its existing facilities without prior notice to the FERC or a separate docket number being assigned.

Landowner Information:

Should you have questions or concerns regarding the project, please contact Allen Reed at **620-330-7248** so that we may discuss and resolve those concerns. Upon completion of the work, either I or another company representative will contact you to discuss any concerns you may have and to settle any damage claims that may have occurred. Southern Star also has a FERC Compliance helpline (**1-800-769-9165**) that you may call if you believe your concerns and issues are not being adequately addressed. If you do place a call to the helpline, please indicate that you are a landowner calling about Southern Star's project C0003331 Develop Reservoir Simulation Model in Storage Field Elk and Montgomery County, KS and provide your name, phone number, address and specific details of your concerns.

Landowner Rights Under the FERC Regulations:

Any person affected by either the construction or operation of a certificated or authorized natural gas project under the Natural Gas Act or by the construction or operation of a project under the Federal Power Act may seek the informal resolution of a dispute by contacting the Commission's Landowner Helpline. The Helpline may be reached by calling toll free **1-877-**

337-2237, by e-mail at LandownerHelp@ferc.gov, or writing to: Commission's Landowner Helpline, Federal Energy Regulatory Commission, 888 First Street NE., Washington, DC 20426.

Contact Information For Landowners:

After the project is completed, either I or another company representative will contact you to discuss any concerns you may have and to settle any damage claims that may have occurred. Southern Star has a FERC Compliance helpline (1-800-769-9165) that you may call if you believe your concerns and issues are not being adequately addressed.

Southern Star Contact Information For Landowners:

It is Southern Star's policy to make every effort to keep you well informed of activities that affect your property and to achieve satisfactory land restoration upon completion of the job. If you have any concerns about this project now or at any time during or upon completion, please do not hesitate to contact me by phone at (620)330-7248 or by email at allen.reed@southernstar.com

Sincerely,



Allen Reed
Land Representative
Southern Star Central Gas Pipeline, Inc.
620-330-7248



