WELL ID

KOLAR DOC ID

(785) 296-3565 | K.S.A. 82a-1212 | v2022c

## **WATER WELL RECORD** (WWC-5)


OCATION OF WATER WELL						Original Reco	ord Co	rrection	Chang	je in Wel	l Use
Latitude	Longitude			Section	Township	Range	E		1/4	1/4	1/4
Datum	Elevation			County							
WATER WELL OWNER		l	WELL	WATER USE			NEAREST	SOURCE OF	POTENTIAL C	ONTAMIN	IATION
Name											
			COMP	LETION							
Business				LETION			from well	l:	Directio from we	·II:	
Address			Depth of completed well:ft.			Source					
			]   -	-	water encountered	:	description	on:			
******					(2) ft.;		Source:				
Well location			(3)	ft.; (	(4) dry well		Distance	ı.	Directio from we	n 11.	
at owner's			Static	water level	in well:	ft.		l÷	110111 we	11;	
address			m	measured below land surface				Source   description:			
CONCEDUCTION			on	(mm/dd/y	y):		No no	tantial source	e of contami	ination	
CONSTRUCTION	D 1 1 1				ve land surface			itentiai sourc	c of contain	mation	
	Borehole dia	meter:	on (mm/dd/yy):			PERMIT & ID NUMBERS (AS REQUIRED)					
fromtoft.		in.	Estim	ated yield: _	gpm						
fromto ft.		in.	Water	level was:	ft. after	hours	1 -	-	:		
Casing height above land surf	face:	in.			pumping	gpm	KDHE /	EPA Project (	Code:		
If casing height is less that			Pump	installed?	Yes No		Site Name:				
has a variance been appro		s No	T17 .	11 11	. 10				orm Complet		
*variance not required for monitoring or environmental remediation wells					ected? Yes N				No Perm		
Casing type:	lation wens		Date	disinfected (	(mm/dd/yy):		I				
Blank casing interval:	ft. to	ft.	Aquif	er, if known	:		# of borel	noles:	# of dewate	ring wells:	
Blank casing diameter:			LITHO	LOGIC LOG	i						
Casing joints:			FROI	м то	LITHOLOGY	NTERVALS					
Weight: lbs/											
Wall thickness or gauge n											
Blank casing interval:											
Blank casing diameter:											
Casing joints:											
Weight: lbs/	ft.										
Wall thickness or gauge n	10.:										
Court interval 6 to											
Grout interval: ft. to_											
Grout material: ft. to											
			COMM	IENTS							
Grout material:											
Screen / perforation material:											
Screen / perforation material:			CONT	RACTOR'S	OR LANDOWNER	S CERTIFICATION	N				
Screen / perforation openings								numouset t-	the stated -	vatar 11	
From ft. to					was constructe			•	the stated v		
					ense and was con	=		-			
Slot size unit _ From ft. to					knowledge and b						
					ness name of						
Slot size unit _			Kans	as Water V	Vell Contractor's	License No	u	nder the au	thority of th	ne designa	ated
Gravel pack intervals:	Cmarcel et		perso	on as defin	ed in K.A.R. 28-	30-2(j) and sign	ed and certi	fied by the e	electronic si	gnature o	f the
Gravel pack not used:		in	^		on at its submitt	,					
From ft. to	_				VATER WELL OW	<u> </u>	ne for your red	ords. Fee of 9	5 00 for each	constructe	d well
Gravel pack not used:		in	Jena O	copy to v		EPARTMENT OF	•			constituent	a men
From ft. to	_ tt.			Bureau	of Water, Geology					2-1367	

Form	WWC5.2 - Water Well Record
Doc ID	1809199
Well Owner	Midway Coop
Contractor	Coranco Great Plains, Inc.

## Lithology

From	То	Lithology Intervals
0	3	fill (man-made material)
3	5	clay,silty,yellowish,brown,mois t,firm
5	8	clay,silty,tan,slightly moist,firm,shaley/limey
8	12	limey shale,unknown,tan,hard,moist
12	26	shaley limestone,unknown,yellowish, brown,hard,moist
26	30	shale,unknown,gray,hard,dam p
30	33	shale,unknown,gray,hard,moi st
33	39	shale,unknown,black,hard,wet in part

727 N WACO STE 265 • WICHITA, KS 67203 • 316.262.5698

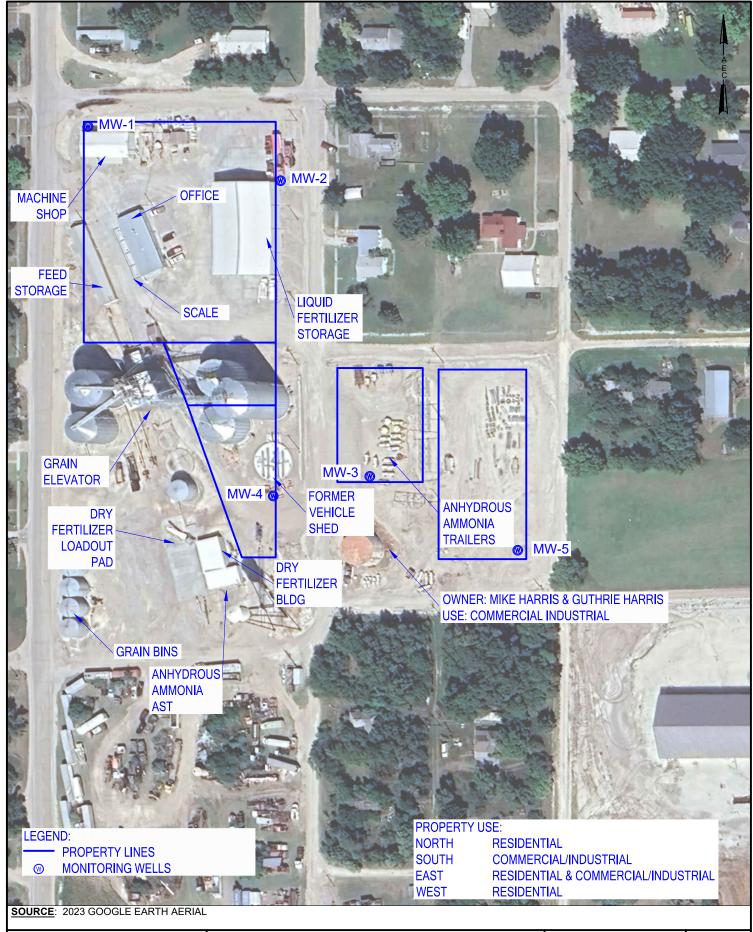

MONITORING WELL LOCATIONS BURR OAK, KANSAS PROJECT: 24070:0288 FIGURE

SCALE: 1"=80'
DATE: 11/11/2024

DWN BY: SMB CHKD BY: DAB SHT:1.0F.1

JEO Consulting Group, Inc. Job No. 242466 For: ALLIED ENVIROMENTAL 12/27/2024

MIDWAY COOP MONITORING WELLS BURR OAK, KANSAS FIELD WORK COMPLETED ON 12/5/2024 FIELD CREW: BRANDON SCHROEDER

HORIZONTAL DATUM (US SURVEY FEET)= KANSAS NORTH (NAD 83) 1995 ADJUSTMENT VERTICAL DATUM (US SURVEY FEET)= NAVD 88

			PVC	TOP OF	GROUND		
DESCRIPTION	NORTHING	EASTING	ELEVATION	CONCRETE	ELEVATION	LAT	Long
MW-1	559079.00	1226485.96	1657.89	1658.13	1658.1	39.8679137	-98.3058270
MW-2	559007.75	1226732.10	1658.14	1658.39	1658.3	39.8677204	-98.3049493
MW-3	558613.09	1226853.09	1655.17	1655.63	1655.6	39.8666381	-98.3045135
MW-4	558602.16	1226728.88	1658.44	1658.77	1658.7	39.8666069	-98.3049559
MW-5	558509.02	1227057.22	1654.96	1655.35	1655.3	39.8663543	-98.3037851