_ WELL ID_

KOLAR DOC ID

WATER WELL RECORD (WWC-5)


OCATION OF WATER WELL						Original I	Recor	d Co	rrection	Chang	e in We	l Use
Latitude	Longitude			Section	Township	R	lange	E W	Fraction	1/4	1/4	1/4
Datum	Elevation			County	<u> </u>							
WATER WELL OWNER		l	WELL	NATER US	 			NEAREST S	OURCE OF	POTENTIAL C	ONTAMIN	IATION
Name								Source:				
Business			COMP	LETION				Distance		Direction	n	
Dustriess					. 1 . 11			from well:		from we	ll:	
Address					ted well:		ft.	Source descriptio	n.			
			1 -	•	water encountered: (2) ft.;	•						
Well location					(2) it.; (4) dry well							
								from well:		Direction from we	n ll:	
at owner's address			Static water level in well: ft. measured below land surface					Source description:				
CONSTRUCTION				(mm/dd/y				No not	ential cour	ce of contami	nation	
CONSTRUCTION Parabala interval.	Borehole dia	um at c ==			ve land surface				100 feet.			
Borehole interval:			on (mm/dd/yy):			=	PERMIT & ID NUMBERS (AS REQUIRED)					
fromtoft.		in.			gpm			DIATE 4	ali anti e - NT			
fromto ft.			Water		ft. after		•	1).: Code:		
Casing height above land sur		in.	pumping gpm					KDHE / EPA Project Code:				
If casing height is less that has a variance been appr		e No	Pump installed? Yes No				Site Name: KDHE UIC Class V Form Completed: Yes No					
has a variance been approved?* Yes No *variance not required for monitoring			Water well disinfected? Yes No						s No Perm			
or environmental remediation wells			Date disinfected (mm/dd/yy):			_	Lease Name & Well #:					
Casing type:			A au : 6	er, if knowr						# of dewater		
Blank casing interval:		ft.										
Blank casing diameter:				LOGIC LOG		NITED\/A.I.C						
Casing joints:lbs			FROI	и то	LITHOLOGY	NIERVALS	'					
Wall thickness or gauge r												
Blank casing interval:												
Blank casing diameter:												
Casing joints:												
Weight:lbs												
Wall thickness or gauge r	10.:											
Grout interval:ft. to	ft											
Grout material:												
Grout interval: ft. to												
Grout material:			СОММ	ENTS								
Screen / perforation material:												
Screen / perforation opening			CONTE	RACTOR'S	OR LANDOWNER	S CERTIFIC	ATION					
Screen / perforation intervals			This	water well	was constructe	d reco	onstru	cted p	oursuant to	the stated w	ater well	
Fromft. to			contr	actor's lice	ense and was con	npleted on		·	I certify th	nat this recor	d is true	to
Slot size unit _			the b	est of my l	knowledge and b	elief. This v	vater v	well record	was compl	eted on		
From ft. to			unde	r the busii	ness name of							,
Slot size unit _			Kans	as Water V	Vell Contractor's	License No	o	uı	nder the au	thority of th	e designa	ited
Gravel pack intervals:	Cmar1 - '				ed in K.A.R. 28-3					•	_	
Gravel pack not used:		in	-		son at its submitt	•	٥				-	
From ft. to Gravel pack not used:					VATER WELL OW		ain one	e for vour rec	ords. Fee of	\$5.00 for each	constructe	d well
From ft. to		in		· · · · · · · · · · · · · · · · · · ·				EALTH AND				
710m n. to	11.			Bureau	of Water, Geology (7			Jackson St., S A. 82a-1212		peka KS 66612	2-1367	

Form	WWC5.2 - Water Well Record
Doc ID	1809195
Well Owner	Midway Coop
Contractor	Coranco Great Plains, Inc.

Lithology

From	То	Lithology Intervals
0	2	fill (man-made material)
2	3	clay,silty,dark,brown,slightly moist,firm
3	16	clay,silty,reddish,brown,slightl y moist,stiff
16	19	clay,medium,gravelly,reddish, brown,moist,stiff
19	25	clay,medium,sandy,light,reddi sh,brown,saturated,firm
25	28	clay,silty,light,brown,moist,stiff ,Saley
28	32	sand,fine,clayey,saturated,Lim ey
32	34	shale,unweathered,greenish,g ray,hard,Damp

727 N WACO STE 265 • WICHITA, KS 67203 • 316.262.5698

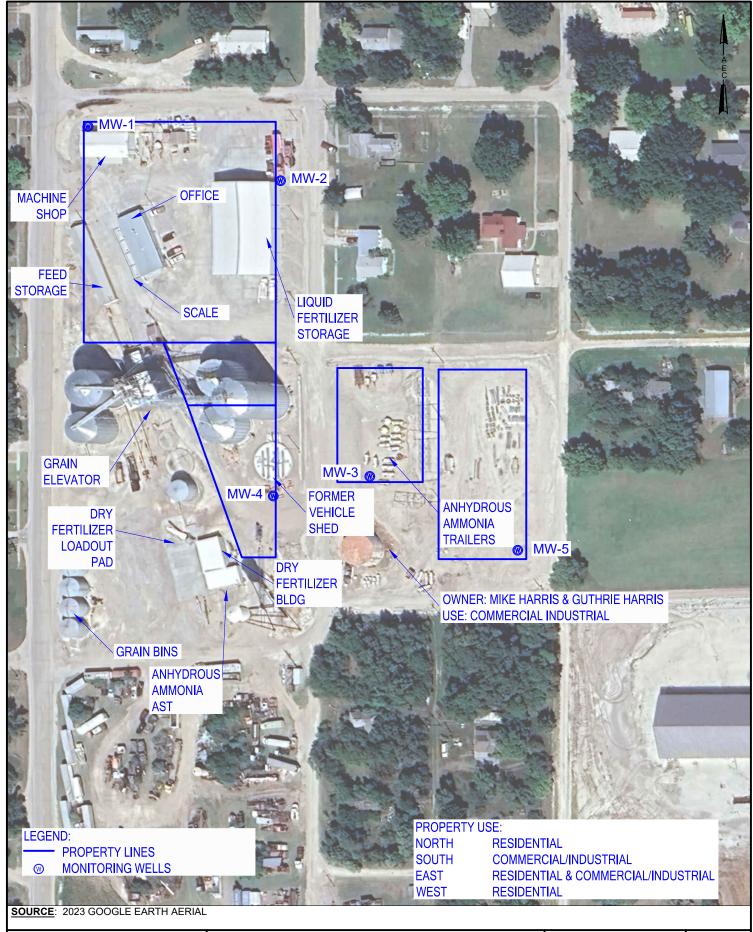

MONITORING WELL LOCATIONS BURR OAK, KANSAS PROJECT: 24070:0288 FIGURE

SCALE: 1"=80'
DATE: 11/11/2024

DWN BY: SMB CHKD BY: DAB SHT:1.0F.1

JEO Consulting Group, Inc. Job No. 242466 For: ALLIED ENVIROMENTAL 12/27/2024

MIDWAY COOP MONITORING WELLS BURR OAK, KANSAS FIELD WORK COMPLETED ON 12/5/2024 FIELD CREW: BRANDON SCHROEDER

HORIZONTAL DATUM (US SURVEY FEET)= KANSAS NORTH (NAD 83) 1995 ADJUSTMENT VERTICAL DATUM (US SURVEY FEET)= NAVD 88

			PVC	TOP OF	GROUND		
DESCRIPTION	NORTHING	EASTING	ELEVATION	CONCRETE	ELEVATION	LAT	Long
MW-1	559079.00	1226485.96	1657.89	1658.13	1658.1	39.8679137	-98.3058270
MW-2	559007.75	1226732.10	1658.14	1658.39	1658.3	39.8677204	-98.3049493
MW-3	558613.09	1226853.09	1655.17	1655.63	1655.6	39.8666381	-98.3045135
MW-4	558602.16	1226728.88	1658.44	1658.77	1658.7	39.8666069	-98.3049559
MW-5	558509.02	1227057.22	1654.96	1655.35	1655.3	39.8663543	-98.3037851