
WATER WELL RECORD (WWC-5)

From _____ ft. to _____ ft.

WATER WEL	L RECORD (\	NWC-5)				KOLAR	DOC ID	WELL ID		
LOCATION OF WA	TER WELL					Original Reco	ord Correction	Chang	e in Well I	Jse
Latitude	Longitud	e	S	Section	Township	Range	E Fraction	1/4	1/4	1/4
Datum	Elevation	n	(County	-		**			
WATER WELL OWN	IER		WELL V	ATER USE			NEAREST SOURCE OF	POTENTIAL C	ONTAMINA	TION
Name							Source:			
Business			COMPL	FTION			Distance from well:			
						a	from well:	from wel	11:	
Address					ted well:water encountered		Source description:			
			(1)	ft.;	(2) ft.;		Source:			
Well location			(3)	ft.; ((4) dry well		Distance from well:	Direction	n ll:	
at owner's address					in well:f	t.	Source description:			_
4447 655				(mm/dd/y			-			
Borehole interval:	Borehole	liameter:	i	asured abo (mm/dd/y	ve land surface y):		No potential sour within 100 feet.	ce of contami	nation	
fromto		in.					PERMIT & ID NUMBE	RS (AS REQUI	RED)	
fromto					gpm ft. after	hours	DWR Application No).:		
	ve land surface:				pumping		KDHE / EPA Project	Code:		
	t is less than 12 in.		Pump	installed?	Yes No	01	Site Name:			
		Yes No					KDHE UIC Class V F	Form Complet	ed: Yes	No
	equired for monitoria				ected? Yes N		County Permit: Yes	s No Permi	it ID:	
	ntal remediation wells	8	Date d	isinfected ((mm/dd/yy):		Lease Name & Well #	:		
Casing type:	val:ft. to _		Aguife	r, if known	ı:		# of boreholes:	# of dewater	ring wells: _	
Blank casing diame		1.		OGIC LOG						
			FROM		LITHOLOGY	NTFRVALS				
	lbs/ft.		- 111011							
	or gauge no.:									
	val:ft. to									
Blank casing diame										
Casing joints:_										
Weight:	lbs/ft.									
Wall thickness	or gauge no.:									
Grout interval:	ft. toft.									
Grout material	:	_								
Grout interval:	ft. toft.									
Grout material	:	-	COMMI	ENTS						
Screen / perforation	n material:									
Screen / perforatio	n openings:		CONTR	ACTOR'S	OR LANDOWNER	S CERTIFICATIO	N			
Screen / perforation	n intervals:		This v	vater well	was constructe	d reconstr	ructed pursuant to	the stated w	ater well	
Fromft.	toft.		contra	ctor's lice	ense and was con	npleted on	I certify th			
	unit					_	r well record was compl			
From ft.	toft.			•			wen record was compr			
Slot size	unit									
Gravel pack interva							under the au	•	-	
Gravel pack no	t used: Gravel size	:in	-				ned and certified by the	electronic sig	gnature of t	he
From f	t. to ft.				son at its submitt		·			
Gravel pack no	t used: Gravel size	in	Send on	e copy to V	VATER WELL OW	NER and retain o	ne for your records. Fee of	\$5.00 for each	constructed	well.

KANSAS DEPARTMENT OF HEALTH AND ENVIRONMENT Bureau of Water, Geology Section, 1000 SW Jackson St., Suite 420, Topeka KS 66612-1367 (785) 296-3565 | K.S.A. 82a-1212 | v2022c

727 N WACO STE 265 • WICHITA, KS 67203 • 316.262.5698

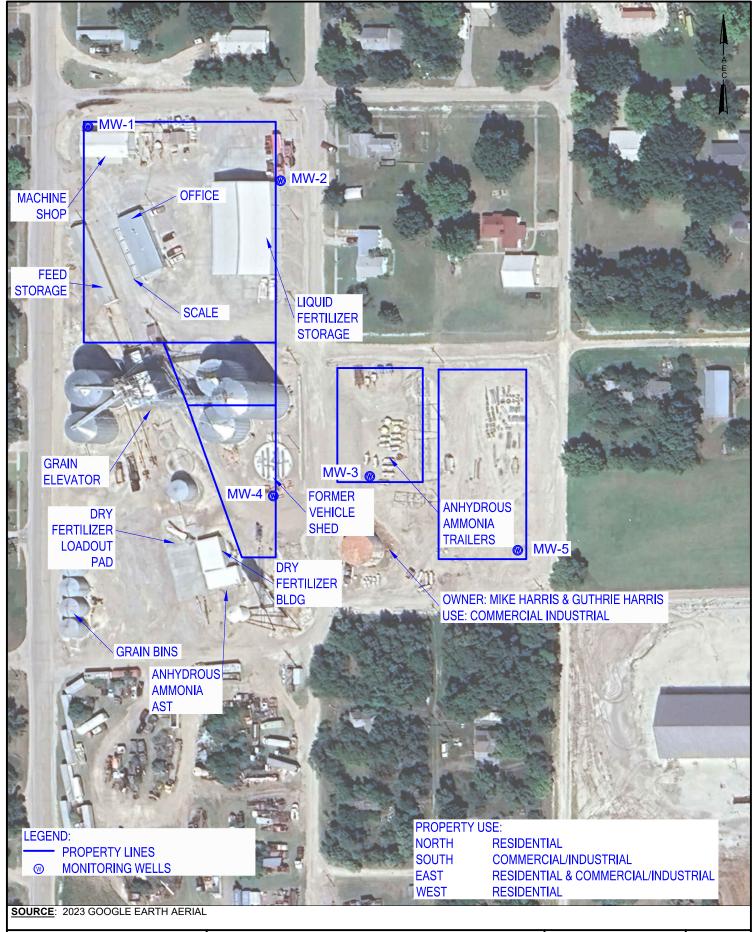

MONITORING WELL LOCATIONS BURR OAK, KANSAS PROJECT: 24070:0288 FIGURE

SCALE: 1"=80'
DATE: 11/11/2024

DWN BY: SMB CHKD BY: DAB SHT:1.0F.1

JEO Consulting Group, Inc. Job No. 242466 For: ALLIED ENVIROMENTAL 12/27/2024

MIDWAY COOP MONITORING WELLS BURR OAK, KANSAS FIELD WORK COMPLETED ON 12/5/2024 FIELD CREW: BRANDON SCHROEDER

HORIZONTAL DATUM (US SURVEY FEET)= KANSAS NORTH (NAD 83) 1995 ADJUSTMENT VERTICAL DATUM (US SURVEY FEET)= NAVD 88

			PVC	TOP OF	GROUND		
DESCRIPTION	NORTHING	EASTING	ELEVATION	CONCRETE	ELEVATION	LAT	Long
MW-1	559079.00	1226485.96	1657.89	1658.13	1658.1	39.8679137	-98.3058270
MW-2	559007.75	1226732.10	1658.14	1658.39	1658.3	39.8677204	-98.3049493
MW-3	558613.09	1226853.09	1655.17	1655.63	1655.6	39.8666381	-98.3045135
MW-4	558602.16	1226728.88	1658.44	1658.77	1658.7	39.8666069	-98.3049559
MW-5	558509.02	1227057.22	1654.96	1655.35	1655.3	39.8663543	-98.3037851