

ALT ☐ I ☐ II ☐ III Approved by: _____ Date: _____

Form	ACO1 - Well Completion
Operator	Tallgrass Interstate Gas Transmission, LLC
Well Name	TRUAN NORTH WELL #1
Doc ID	1839224


Casing

Purpose Of String	Size Hole Drilled	Size Casing Set	Weight	Setting Depth	Type Of Cement	Number of Sacks Used	Type and Percent Additives
Surface	16	1	1.32	20	100% Bentonite Chips	14	100% Bentonite

Truan North #1
2024 Deep-hole Ground bed Installation
TIGT- AFE#12896



Deephole Groundbed Location

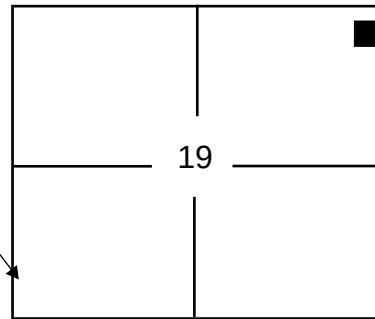

Well Bore Diagram

KS/
S19-T12S-R23W
Trego Co., KS

Top of Bore hole and
Casing 20' Below Ground
Level

14-50# Bags of 100%
Bentonite Chips Used To
Seal 10'X20' Casing in 16"
Hole

Top Of Last Anode- 40'

20-50# Bags of Bentonite
Chips Used To Plug Well
From Top Of Coke Column
To Top of Casing

20'- Top Of Coke Backfill
Column

8- Mixed Metal Oxide
Anodes Evenly Spaced In
150' Column- Coke Backfill
Installed Around Anode
Column

Cables From Anodes

