

WATER WELL RECORD (WWC-5)

KOLAR DOC ID _____ WELL ID _____

Original Record Correction Change in Well Use

LOCATION OF WATER WELL

Latitude		Longitude		Section		Township		Range		E W	Fraction	¼	¼	¼
Datum		Elevation		County										

WATER WELL OWNER

Name	
Business	
Address	
Well location at owner's address	

WELL WATER USE

--

COMPLETION

Depth of completed well: _____ ft.
Depth(s) groundwater encountered:
(1) _____ ft.; (2) _____ ft.;
(3) _____ ft.; (4) dry well
Static water level in well: _____ ft.
measured below land surface
on (mm/dd/yy): _____
measured above land surface
on (mm/dd/yy): _____
Estimated yield: _____ gpm
Water level was: _____ ft. after _____ hours
pumping _____ gpm
Pump installed? Yes No
Water well disinfected? Yes No
Date disinfected (mm/dd/yy): _____
Aquifer, if known:

NEAREST SOURCE OF POTENTIAL CONTAMINATION

Source: _____
Distance from well: _____ Direction from well: _____
Source description: _____
Source: _____
Distance from well: _____ Direction from well: _____
Source description: _____
No potential source of contamination within 100 feet.

CONSTRUCTION

Borehole interval:	Borehole diameter:
from _____ to _____ ft.	_____ in.
from _____ to _____ ft.	_____ in.
Casing height above land surface: _____ in.	
If casing height is less than 12 in. has a variance been approved?*	Yes No
*variance not required for monitoring or environmental remediation wells	
Casing type: _____	
Blank casing interval: _____ ft. to _____ ft.	
Blank casing diameter: _____ in.	
Casing joints: _____	
Weight: _____ lbs/ft.	
Wall thickness or gauge no.: _____	
Blank casing interval: _____ ft. to _____ ft.	
Blank casing diameter: _____ in.	
Casing joints: _____	
Weight: _____ lbs/ft.	
Wall thickness or gauge no.: _____	
Grout interval: _____ ft. to _____ ft.	
Grout material: _____	
Grout interval: _____ ft. to _____ ft.	
Grout material: _____	
Screen / perforation material: _____	
Screen / perforation openings: _____	
Screen / perforation intervals:	
From _____ ft. to _____ ft.	
Slot size _____ unit _____	
From _____ ft. to _____ ft.	
Slot size _____ unit _____	
Gravel pack intervals:	
Gravel pack not used: Gravel size _____ in	
From _____ ft. to _____ ft.	
Gravel pack not used: Gravel size _____ in	
From _____ ft. to _____ ft.	

PERMIT & ID NUMBERS (AS REQUIRED)

DWR Application No.: _____
KDHE / EPA Project Code: _____
Site Name: _____
KDHE UIC Class V Form Completed: Yes No
County Permit: Yes No Permit ID: _____
Lease Name & Well #: _____
of boreholes: _____ # of dewatering wells: _____

LITHOLOGIC LOG

FROM	TO	LITHOLOGY INTERVALS

COMMENTS

--

CONTRACTOR'S OR LANDOWNERS CERTIFICATION

This water well was constructed reconstructed pursuant to the stated water well contractor's license and was completed on _____. I certify that this record is true to the best of my knowledge and belief. This water well record was completed on _____ under the business name of _____, Kansas Water Well Contractor's License No. _____ under the authority of the designated person as defined in K.A.R. 28-30-2(j) and signed and certified by the electronic signature of the designated person at its submittal: _____.

Send one copy to WATER WELL OWNER and retain one for your records. Fee of \$5.00 for each constructed well.

FULL SITE SURVEY

BAILEY'S #8
INDEPENDENCE, KANSAS

Point	North Coordinate	East Coordinate	Distance from SE Cor. Sec. 12	*Elev. Top of Rim or of PVC Pipe	Elev. Top of PVC Pipe	Latitude North	Longitude West
SE Cor.			North West	PK Nail			
Sec.12-T33S-R15E	5000	5000					
MW-1	10088.25	4846.16	5088.25	153.84	846.67	846.29	37.19592 95.71124
MW-2	10044.31	4944.16	5044.31	55.84	845.42	845.16	37.19579 95.71091
MW-3	9975.82	4918.93	4975.82	81.07	845.42	845.16	37.19562 95.71098
MW-4	10195.25	4937.75	5195.25	62.25	845.99	945.74	37.19622 95.71092
MW-5	10005.93	4801.70	5005.93	198.30	845.72	845.31	37.19569 95.71139
MW-6	10225.65	4827.23	5225.65	172.77	845.97	845.62	37.19632 95.71133
MW-7	10135.73	4792.48	5135.73	207.52	846.14	845.87	37.19607 95.71139
MW-8	10043.87	4705.14	5043.87	294.86	844.77	844.28	37.19579 95.71175
MW-9	9930.41	4749.55	4930.41	250.45	844.26	844.01	37.19548 95.71159
MW-10	10175.90	4704.70	5175.90	295.30	845.35	844.91	37.19618 95.71172
MW-11	10327.40	4693.40	5327.40	306.60	844.62	844.24	37.19660 95.71176
MW-12	10318.70	4906.10	5318.70	93.90	841.60	841.31	37.19657 95.71103
MW-13	10353.40	4916.60	5353.40	83.40 E	843.78	843.51	37.19667 95.71099
MW-14	10212.20	4954.30	5212.20	45.70 E	844.52	844.12	37.19628 95.71087
MW-15	10049.50	4952.60	5049.50	47.40 E	845.74	845.48	37.19583 95.71088
MW-16	10136.68	4906.91	5136.68	93.09	846.47	846.21	37.19604 95.71102
MW-17	10136.62	4934.76	5136.62	65.24	846.23	845.90	37.19606 95.71093
MW-18	10104.73	4909.82	5104.73	90.18	846.22	845.93	37.19597 95.71101
MW-19	10045.79	4882.53	5045.79	117.47	845.82	845.46	37.19581 95.71111
MW-20	10054.40	4840.22	5054.40	159.78	846.04	845.73	37.19583 95.71125
MW-21	10058.91	4785.31	5058.91	214.69	845.53	845.25	37.19584 95.71144
MW-22	10108.18	4835.76	5108.18	164.24	846.13	845.79	37.19598 95.71127
MW-23	10110.37	4853.85	5110.37	146.15	846.38	845.99	37.19598 95.71121
MW-24	10167.39	4908.56	5167.39	91.44	846.17	845.79	37.19616 95.71102
MW-26	10223.14	4742.16	5223.14	257.84	845.47	845.02	37.19631 95.71159
MW-27	10077.19	4806.06	5077.19	193.94	845.89	845.38	37.19591 95.71138
MW-28	10033.07	4806.92	5033.07	193.08	845.77	845.41	37.19579 95.71138
MW-29	10057.01	4914.40	5057.01	85.60	845.51	845.07	37.19585 95.71101

Site B.M. 10218.80 4941.90 5218.80 58.10 B.M. Elev. = 845.20

Description: "□" Square cut on NE corner of concrete sign base at NE corner of property

LEGEND


- MW1 MONITORING WELL LOCATION
- OE OVERHEAD ELECTRIC
- SITE BENCHMARK
- DRAINAGE DIRECTION
- POWER POLE

SMH Consultants
By: Tim Sloan

Tim Sloan, P.S.
Vice-President



SMH
CONSULTANTS

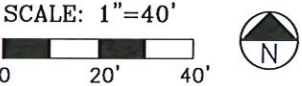

Civil Engineering • Land Surveying • Landscape Architecture
www.smhconsultants.com

Manhattan, KS - HQ P: (785) 776-0541 • Dodge City, KS P: (620) 255-1952
Kansas City P: (913) 444-9615 • Colorado Springs, CO P: (719) 428-8677

Drawn By:RJC Project #2503-0070 TDS #101

