

KANSAS CORPORATION COMMISSION  
OIL & GAS CONSERVATION DIVISION

**WELL PLUGGING APPLICATION**

**Form KSONA-1, Certification of Compliance with the Kansas Surface Owner Notification Act,  
MUST be submitted with this form.**

Form CP-1  
March 2010

This Form must be Typed  
Form must be Signed  
All blanks must be Filled

OPERATOR: License #: \_\_\_\_\_

API No. 15 - \_\_\_\_\_

Name: \_\_\_\_\_

If pre 1967, supply original completion date: \_\_\_\_\_

Address 1: \_\_\_\_\_

Spot Description: \_\_\_\_\_

Address 2: \_\_\_\_\_

— - - - - Sec. \_\_\_\_ Twp. \_\_\_\_ S. R. \_\_\_\_  East  West

City: \_\_\_\_\_ State: \_\_\_\_\_ Zip: \_\_\_\_\_ + \_\_\_\_\_

\_\_\_\_\_ Feet from  North /  South Line of Section

Contact Person: \_\_\_\_\_

\_\_\_\_\_ Feet from  East /  West Line of Section

Phone: (\_\_\_\_\_) \_\_\_\_\_

Footages Calculated from Nearest Outside Section Corner:

NE  NW  SE  SW

County: \_\_\_\_\_

Lease Name: \_\_\_\_\_ Well #: \_\_\_\_\_

Check One:  Oil Well  Gas Well  OG  D&A  Cathodic  Water Supply Well  Other: \_\_\_\_\_

SWD Permit #: \_\_\_\_\_  ENHR Permit #: \_\_\_\_\_  Gas Storage Permit #: \_\_\_\_\_

Conductor Casing Size: \_\_\_\_\_ Set at: \_\_\_\_\_ Cemented with: \_\_\_\_\_ Sacks

Surface Casing Size: \_\_\_\_\_ Set at: \_\_\_\_\_ Cemented with: \_\_\_\_\_ Sacks

Production Casing Size: \_\_\_\_\_ Set at: \_\_\_\_\_ Cemented with: \_\_\_\_\_ Sacks

List (ALL) Perforations and Bridge Plug Sets:

Elevation: \_\_\_\_\_ ( G.L. /  K.B.) T.D.: \_\_\_\_\_ PBTD: \_\_\_\_\_ Anhydrite Depth: \_\_\_\_\_

(Stone Corral Formation)

Condition of Well:  Good  Poor  Junk in Hole  Casing Leak at: \_\_\_\_\_

(Interval)

Proposed Method of Plugging (attach a separate page if additional space is needed):

Is Well Log attached to this application?  Yes  No Is ACO-1 filed?  Yes  No

If ACO-1 not filed, explain why:

**Plugging of this Well will be done in accordance with K.S.A. 55-101 et. seq. and the Rules and Regulations of the State Corporation Commission**

Company Representative authorized to supervise plugging operations: \_\_\_\_\_

Address: \_\_\_\_\_ City: \_\_\_\_\_ State: \_\_\_\_\_ Zip: \_\_\_\_\_ + \_\_\_\_\_

Phone: (\_\_\_\_\_) \_\_\_\_\_

Plugging Contractor License #: \_\_\_\_\_ Name: \_\_\_\_\_

Address 1: \_\_\_\_\_ Address 2: \_\_\_\_\_

City: \_\_\_\_\_ State: \_\_\_\_\_ Zip: \_\_\_\_\_ + \_\_\_\_\_

Phone: (\_\_\_\_\_) \_\_\_\_\_

**Proposed Date of Plugging (if known): \_\_\_\_\_**

**Payment of the Plugging Fee (K.A.R. 82-3-118) will be guaranteed by Operator or Agent**

**Submitted Electronically**

KANSAS CORPORATION COMMISSION  
OIL & GAS CONSERVATION DIVISION

**CERTIFICATION OF COMPLIANCE WITH THE  
KANSAS SURFACE OWNER NOTIFICATION ACT**

Form KSONA-1  
July 2021

Form Must Be Typed  
Form must be Signed  
All blanks must be Filled

*This form must be submitted with all Forms C-1 (Notice of Intent to Drill); CB-1 (Cathodic Protection Borehole Intent); T-1 (Request for Change of Operator Transfer of Injection or Surface Pit Permit); and CP-1 (Well Plugging Application).*

*Any such form submitted without an accompanying Form KSONA-1 will be returned.*

**Select the corresponding form being filed:**  **C-1** (Intent)  **CB-1** (Cathodic Protection Borehole Intent)  **T-1** (Transfer)  **CP-1** (Plugging Application)

OPERATOR: License # \_\_\_\_\_

Name: \_\_\_\_\_

Address 1: \_\_\_\_\_

Address 2: \_\_\_\_\_

City: \_\_\_\_\_ State: \_\_\_\_\_ Zip: \_\_\_\_\_ + \_\_\_\_\_

Contact Person: \_\_\_\_\_

Phone: ( \_\_\_\_\_ ) \_\_\_\_\_ Fax: ( \_\_\_\_\_ ) \_\_\_\_\_

Email Address: \_\_\_\_\_

Well Location:

\_\_\_\_ - \_\_\_\_ - \_\_\_\_ Sec. \_\_\_\_ Twp. \_\_\_\_ S. R. \_\_\_\_  East  West

County: \_\_\_\_\_

Lease Name: \_\_\_\_\_ Well #: \_\_\_\_\_

*If filing a Form T-1 for multiple wells on a lease, enter the legal description of the lease below:*

**Surface Owner Information:**

Name: \_\_\_\_\_

Address 1: \_\_\_\_\_

Address 2: \_\_\_\_\_

City: \_\_\_\_\_ State: \_\_\_\_\_ Zip: \_\_\_\_\_ + \_\_\_\_\_

*When filing a Form T-1 involving multiple surface owners, attach an additional sheet listing all of the information to the left for each surface owner. Surface owner information can be found in the records of the register of deeds for the county, and in the real estate property tax records of the county treasurer.*

*If this form is being submitted with a Form C-1 (Intent) or CB-1 (Cathodic Protection Borehole Intent), you must supply the surface owners and the KCC with a plat showing the predicted locations of lease roads, tank batteries, pipelines, and electrical lines. The locations shown on the plat are preliminary non-binding estimates. The locations may be entered on the Form C-1 plat, Form CB-1 plat, or a separate plat may be submitted.*

**Select one of the following:**

- I certify that, pursuant to the Kansas Surface Owner Notice Act (see Chapter 55 of the Kansas Statutes Annotated), I have provided the following to the surface owner(s) of the land upon which the subject well is or will be located: 1) a copy of the Form C-1, Form CB-1, Form T-1, or Form CP-1 that I am filing in connection with this form; 2) if the form being filed is a Form C-1 or Form CB-1, the plat(s) required by this form; and 3) my operator name, address, phone number, fax, and email address.
- I have not provided this information to the surface owner(s). I acknowledge that, because I have not provided this information, the KCC will be required to send this information to the surface owner(s). To mitigate the additional cost of the KCC performing this task, I acknowledge that I must provide the name and address of the surface owner by filling out the top section of this form and that I am being charged a \$30.00 handling fee, payable to the KCC, which is enclosed with this form.

*If choosing the second option, submit payment of the \$30.00 handling fee with this form. If the fee is not received with this form, the KSONA-1 form and the associated Form C-1, Form CB-1, Form T-1, or Form CP-1 will be returned.*

I Submitted Electronically

I

Form	CP1 - Well Plugging Application
Operator	Urban Oil and Gas Group LLC
Well Name	DON 1-22
Doc ID	1854509

Perforations And Bridge Plug Sets

Perforation Top	Perforation Base	Formation	Bridge Plug Depth
4551	4561	Johnson	4545
4488	4528	Cherokee	

Don 1-22

15-101-22441

Borell Field

SPUD 5/29/13

Lane County, KS

Cherokee A, B, and E (Johnson A/B)

22-17S-29W NW NW SE NW

INJ - 1300#, 300 bpd, Cherok.&amp;John.

KB: 2809'



URBAN


OIL &amp; GAS GROUP LLC

GL: 2804'

Corr: 5'

Drilled &amp; Completed JUL 2013

Casing Details	Feet	Top	Bottom
	-	-	
	-	-	
	-	-	
	-	-	
	-	-	

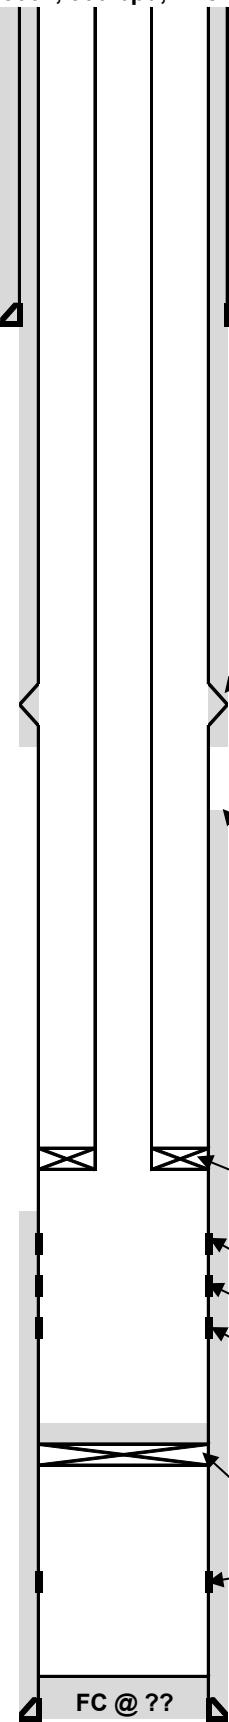

## SURFACE CASING

Size: 8-5/8" Weight: 24# Depth: 302'

Grade: 0 Cmt: 200 sx TOC: surf.

Hole: 12-1/4"

## PRODUCTION CASING

Size: 5-1/2" Weight: 15.5# Depth: 4649'

Grade: J-55 Cmt: 50&amp;120 TOC: 3250+/-

Hole: 7-7/8" DVT @ 2286

## Tubing Details (4/20/18 per MIT)

2-3/8" Sealtite tubing @ 4409'

2-3/8x5-1/2" AS1x

DVT @ 2286 w/375 sx per cement report

TOC @ 3250+/-, per CBL

AS1x @ 4409, per WOR 12/22/2021

Cherokee A - 4488-4494 6/'13

Cherokee B - 4500-4502 6/'13

Cherokee E - 4524-4528 6/'13

CIBP @ 4545 w/2 sx cmt 6/'13

Johnson A/B - 4551-4561 6/'13

PBTD 4605

DTD 4650, LTD 4650

FC @ ??

Don 1-22

15-101-22441



URBAN

OIL & GAS GROUP

Borell Field

SPUD 5/29/13

Lane County, KS

Cherokee A, B, and E (Johnson A/B)

22-17S-29W NW NW SE NW


KB: 2809'

GL: 2804'

Corr: 5'

Drilled & Completed JUL 2013

Casing Details	Feet	Top	Bottom
	-	-	
	-	-	
	-	-	
	-	-	
	-	-	

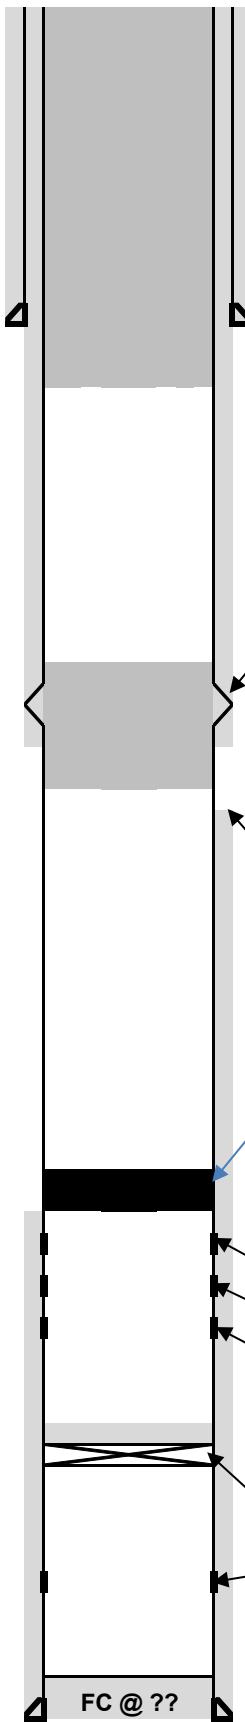

**SURFACE CASING**

Size: 8-5/8" Weight: 24# Depth: 302'

Grade: 0 Cmt: 200 sx TOC: surf.

Hole: 12-1/4"

**PRODUCTION CASING**

Size: 5-1/2" Weight: 15.5# Depth: 4649'

Grade: J-55 Cmt: 50&120 TOC: 3250+/-

Hole: 7-7/8" DVT @ 2286

**Cement Plug @ 1260-4'**

DVT @ 2286 w/375 sx per cement report

**Cement Plug @ 2336-2236'**

TOC @ 3250+/-, per CBL

**CIBP @ 4430' w/ 5 sks cement**

Cherokee A - 4488-4494 6/13

Cherokee B - 4500-4502 6/13

Cherokee E - 4524-4528 6/13

**CIBP @ 4545 w/2 sx cmt 6/13**

Johnson A/B - 4551-4561 6/13

PBTD 4605

DTD 4650, LTD 4650



Conservation Division  
266 N. Main St., Ste. 220  
Wichita, KS 67202-1513

Phone: 316-337-6200  
Fax: 316-337-6211  
<http://kcc.ks.gov/>

Andrew J. French, Chairperson  
Dwight D. Keen, Commissioner  
Annie Kuether, Commissioner

Laura Kelly, Governor

August 01, 2025

Penny Plumlee  
Urban Oil and Gas Group LLC  
1000 E 14TH ST SUITE 300  
PLANO, TX 75074-6214

Re: Plugging Application  
API 15-101-22441-00-01  
DON 1-22  
NW/4 Sec.22-17S-29W  
Lane County, Kansas

Dear Penny Plumlee:

The Conservation Division has received your Well Plugging Application (CP-1).

**Under K.A.R. 82-3-113(b)(2), you must notify DISTRICT 1 of your proposed plugging plan at least 5 days before plugging the well.** DISTRICT 1's phone number is (620) 682-7933. Failure to notify DISTRICT 1, or failure to file a Well Plugging Record (CP-4) after the well is plugged will result in a penalty recommendation.

**Under K.A.R. 82-3-600, you must file an Application for Surface Pit (CDP-1) if you wish to use a workover pit while plugging the well.** Failure to timely file a CDP-1, failure to timely remove fluids, or failure to timely file Closure of Surface Pit (CDP-4) or Waste Transfer (CDP-5) forms will result in a penalty recommendation.

This receipt does NOT constitute authorization to plug this well if you do not otherwise have the legal right to do so.

This receipt is VOID after January 28, 2026. If the well is not plugged by then, you will have to submit a new CP-1 if you wish to plug the well.

**The January 28, 2026 deadline does NOT override any compliance deadline given to you by Legal, District, or other Commission Staff.** Failure to comply with any given deadline will still result in the Commission assessing penalties, or taking other legal action.

Sincerely,  
Production Department Supervisor

cc: DISTRICT 1