

Form	ACO1 - Well Completion
Operator	Tallgrass Interstate Gas Transmission, LLC
Well Name	DAMAR EAST WELL #1
Doc ID	1855807


Casing

Purpose Of String	Size Hole Drilled	Size Casing Set	Weight	Setting Depth	Type Of Cement	Number of Sacks Used	Type and Percent Additives
Surface	16	10	11.132	40	100% Bentonite Chips	28	100% Bentonite

Damar East
2024 Deep-hole Ground bed Installation
TIGT- AFE#12896



Deephole Groundbed Location

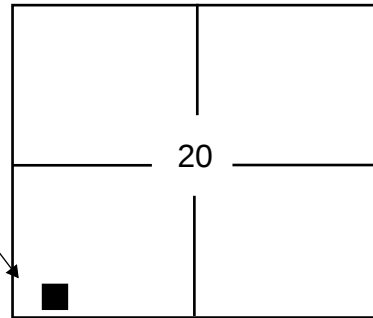

Well Bore Diagram

KS/
S20-T08S-R19W
Rooks Co., KS

Top of Bore hole and
Casing 40' Below Ground
Level

14-50# Bags of 100%
Bentonite Chips Used To
Seal 10'X40' Casing in 16"
Hole

Top Of Last Anode- 50'

20-50# Bags of Bentonite
Chips Used To Plug Well
From Top Of Coke Column
To Top of Casing

20'- Top Of Coke Backfill
Column

15- Mixed Metal Oxide
Anodes Evenly Spaced In
300' Column- Coke Backfill
Installed Around Anode
Column

Cables From Anodes

