WATER WELL RECORD (WWC-5)

Plugged

KOLAR DOC ID 1862383 WELL ID VMP-3

LOCATION OF WATER WELL

Latitude	37.63559	Longitude	-97.18933	Section	11	Township	28	Range	2	✓E ☐W	Fraction	NW ¼ NW ¼ NW ¼
Datum	WGS84	Elevation	1355	County	Sedgwick							

WATER WELL OWNER

Name	
Business	Phillips 66
Address	411 S Keeler Ave Bartlesville OK 74003
Well location ☐ at owner's address	the well was located 75 feet to the east and 55 feet to the south of the intersection of 31st and 127th in Sedgwick County.

WELL WATER USE

Environmental Remediation / Monitoring Mc

WELL INFORMATION

Depth of well: 16 ft.

✓ Dry well

Static water level in well: _____ ft.

☐ measured below land surface on (mm/dd/yy): _____

☐ measured above land surface on (mm/dd/yy): _____

PERMIT & ID NUMBERS (AS REQUIRED)

DWR Application No.: _____

KDHE / EPA Project Code: C208700644

Site Name: Phillips 66 Gasoline

KDHE UIC Class V Form Completed: ☐ Yes ☐ No

County Permit: ☐ Yes ☐ No Permit ID: _____

Lease Name & Well #: _____

# of boreholes: _____ # of dewatering wells: _____

CASING

Type of blank casing used: ThermalPlastic

Casing type details: _____

Blank casing diameter: 2 inches

Was casing removed? ☐ Yes ☐ No

Top of casing is currently 3 feet

Below ground

Reason required if top of casing is now less than 5 feet below ground surface for a hand dug well or less than 3 feet below ground surface for all other types of wells.

GROUT & PLUGGING MATERIALS

Grout or Plugging interval (ft.) From	To	Material	Description
0	3	other	native soil
3	16	bentonite	chips

COMMENTS

CONTRACTOR'S OR LANDOWNERS CERTIFICATION

This water well was plugged pursuant to the stated water well contractor's license and was completed on 09/05/2025. I certify that this record is true to the best of my knowledge and belief. This water well record was completed on 09/23/2025 under the business name of UES Exploration #531, Kansas Water Well Contractor's License No. 531 under the authority of the designated person as defined in K.A.R. 28-30-2(j) and signed and certified by the electronic signature of the designated person at its submittal Ian Smith.

Send one copy to WATER WELL OWNER and retain one for your records.

REVISIONS			
REV	DESCRIPTION	DATE	APPROVED

FILE COPY

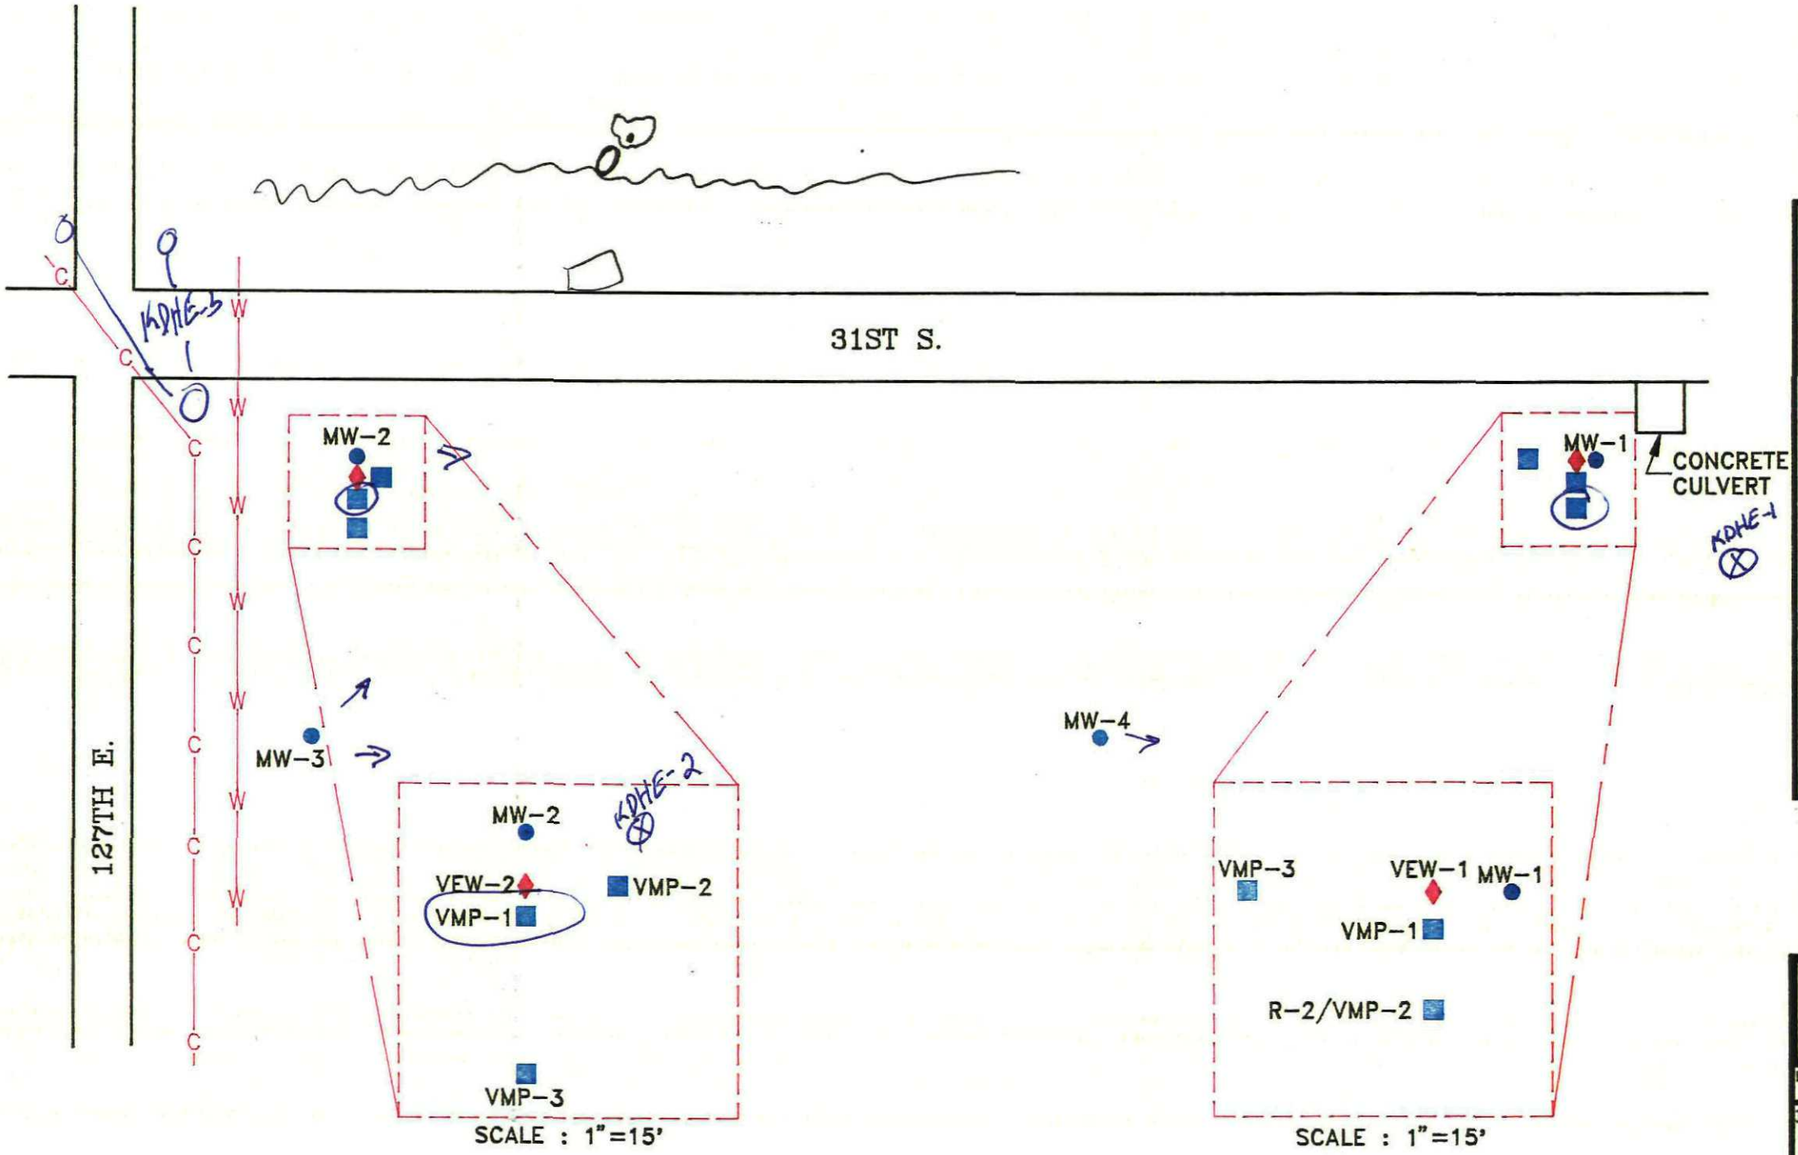

N

LEGEND

- ● = MONITORING WELL
- —C— = CONOCO PIPELINE
- —W— = WATER LINE
- ■ = SOIL VAPOR MONITORING POINT
- ♦ = SOIL VAPOR EXTRACTION WELL

60 0 60 120
SCALE FEET

FIG. 1

GROUNDWATER TECHNOLOGY, INC.
443 N. MAIZE ROAD
WICHITA, KS. 67212

PROJECT No: 042200839	DATE 04/03/91
DETAILED MCH RHW	TITLE: SOIL VAPOR EXTRACTION SITE MAP
CLIENT: CONOCO PIPELINE	LOCATION: WICHITA, KS.
CAD DWG. FILE No. 0839-SM1	