KOLAR Document ID: 1858563

WATER WELL RECORD (WWC-5)

Constructed

KOLAR DOC ID 1858563 WELL ID MW9

✓ Original Record ☐ Correction ☐ Change in Well Use

LOCATION OF WATER WELL

Latitude	39.01425	Longitude	-95.71625	Section	14	Township	12	Range	15 ✓E ☐W	Fraction	NE ¼ NE ¼ NW ¼
Datum	WGS84	Elevation	938	County	Shawnee						

WATER WELL OWNER

Name	
Business	Kylehang, LLC
Address	3101 SW 29th St Topeka KS 66614
Well location ☐ at owner's address	~130' south of 3101 SW 29th St, Topeka, KS

WELL WATER USE

Environmental Remediation / Monitoring Mc

COMPLETION

Depth of completed well: 25.5 ft.

Depth(s) groundwater encountered:

(1) _____ ft.; (2) _____ ft.;

(3) _____ ft.; (4) ☐ dry well

Static water level in well: 14.30 ft.

✓ measured below land surface on (mm/dd/yy): 08/14/2025

☐ measured above land surface on (mm/dd/yy): _____

Estimated yield: _____ gpm

Water level was: _____ ft. after _____ hours pumping _____ gpm

Pump installed? ☐ Yes ✓ No

Water well disinfected? ☐ Yes ☐ No

Date disinfected (mm/dd/yy): _____

Aquifer, if known:

NEAREST SOURCE OF POTENTIAL CONTAMINATION

Source: _____

Distance from well: _____ Direction from well: _____

Source description: _____

Source: _____

Distance from well: _____ Direction from well: _____

Source description: _____

☐ No potential source of contamination within 100 feet.

PERMIT & ID NUMBERS (AS REQUIRED)

DWR Application No.: _____

KDHE / EPA Project Code: U4-089-15627

Site Name: 29th Quick Stop

KDHE UIC Class V Form Completed: ☐ Yes ☐ No

County Permit: ☐ Yes ☐ No Permit ID: _____

Lease Name & Well #: _____

# of boreholes: _____ # of dewatering wells: _____

CONSTRUCTION

Borehole interval: from 0 to 25.5 ft.

from _____ to _____ ft.

Borehole diameter: 7.25 in.

_____ in.

Casing height above land surface: -4.08 in.

If casing height is less than 12 in. has a variance been approved?* ✓ Yes ☐ No

*variance not required for monitoring or environmental remediation wells

Casing type: ThermalPlastic

Blank casing interval: 0 ft. to 10 ft.

Blank casing diameter: 2 in.

Casing joints: Threaded

Weight: _____ lbs/ft.

Wall thickness or gauge no.: 0.154"

Blank casing interval: _____ ft. to _____ ft.

Blank casing diameter: _____ in.

Casing joints: _____

Weight: _____ lbs/ft.

Wall thickness or gauge no.: _____

Grout interval: 1 ft. to 8 ft.

Grout material: Bentonite

Grout interval: 0 ft. to 1 ft.

Grout material: Cement

Screen / perforation material: PVC

Screen / perforation openings: Mill slot

Screen / perforation intervals:

From 10 ft. to 25.5 ft.

Slot size _____ unit _____

From _____ ft. to _____ ft.

Slot size _____ unit _____

Gravel pack intervals:

Gravel pack not used: ☐ Gravel size _____ in

From 8 ft. to 25.5 ft.

Gravel pack not used: ☐ Gravel size _____ in

From _____ ft. to _____ ft.

LITHOLOGIC LOG

FROM	TO	LITHOLOGY INTERVALS
0	4	clay-fat
4	8	clay-lean
8	9	clay,sandy
9	25.5	sandstone,unknown

COMMENTS

When this well is to be abandoned and plugged, the KDHE Water Well Program will be contacted in advance to determine an appropriate and protective procedure.

CONTRACTOR'S OR LANDOWNERS CERTIFICATION

This water well was constructed ✓ reconstructed ☐ pursuant to the stated water well contractor's license and was completed on 08/14/2025. I certify that this record is true to the best of my knowledge and belief. This water well record was completed on 10/08/2025 under the business name of Larsen And Associates, Kansas Water Well Contractor's License No. 757 under the authority of the designated person as defined in K.A.R. 28-30-2(j) and signed and certified by the electronic signature of the designated person at its submittal: Donald Beemer.

Send one copy to WATER WELL OWNER and retain one for your records. Fee of $5.00 for each constructed well.

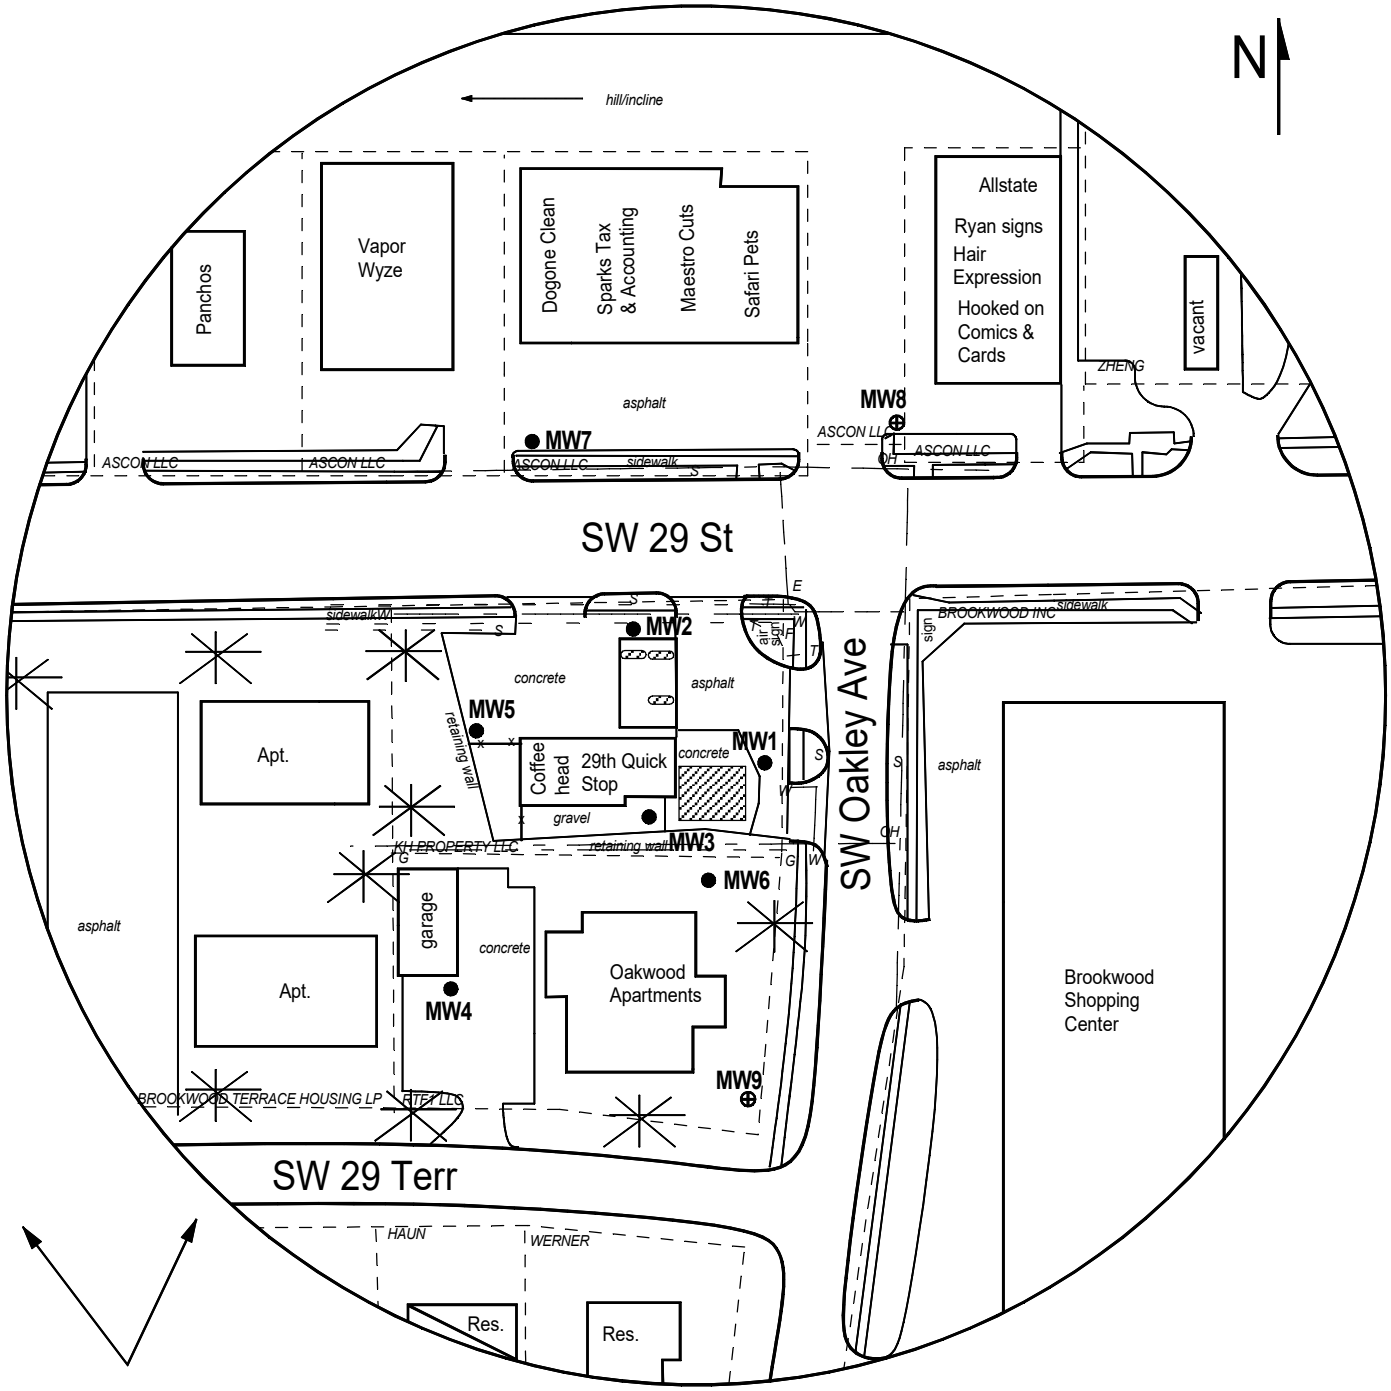

FIGURE 3 - 350 FT RADIUS AREA BASE MAP

larsen & ASSOCIATES, INC.

1311 E 25th St., Suite B, Lawrence, KS 66046
Office: (785) 841-8707

PROJECT:

29th Quick Stop
3101 SW 29th St,
Topeka, KS
KDHE ID: U4-089-15627
Date: 8/14/25

0 100 ft

LEGEND:

- Approximate Location of Active UST Basin and Pump Island
- Building with Basement
- ● Existing Monitoring Well
- ⊕ New Monitoring Well (Installed 8/14/25)
- X Proposed Soil Boring
- OH ——— Overhead Lines
- SS — — — Sanitary Sewer (2 - 6 ft BGS)

NOTE: Utility depths and locations are approximate.

DENNIS L HANDKE

1820 NW 59th Terrace
TOPEKA, KANSAS 66618
785-286-4047 Home

Jess Chapman
Larsen & Associates
1311 E. 25th Street, Suite B
Lawrence, Kansas 66046

August 23, 2025

RE: Monitor Well Elevation Survey
3101 SW 29th St., Topeka, Kansas

Proj. 25-00JJ
29TH Quick Stop
KDHE ID U4-089-15627

Bench Mark: Chisled X on top NW bolt of old concrete sign base near the NE Corner of property.
Elev: 905.04 North 5205.00 West 2813.37 (from SE Cor. Sec. 5-10-19E)

MW-8	rim	901.55	North	5302.18	SE1/4,SE1/4,SE1/4,SW1/4 (Sec.32-9-19E)
	top pipe	901.20	West	2766.19	Lat = 39.01514 Long = 95.71604
MW-9	rim	911.77	North	4974.95	NE1/4,NE1/4,NE1/4,NW1/4
	top pipe	911.43	West	2818.73	Lat = 39.01425 Long = 95.71625

Elevation derived from existing project. NAVD 88

Lat & Long derived from Topeka 7.5 Quad Map WGS84

If you have any questions, please feel free to call me. Thank you for the opportunity to be of service to you.

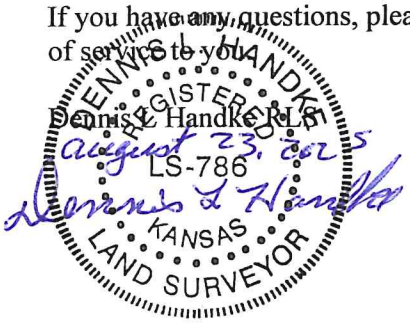

Dennis L Handke RLS