

Notice: Fill out COMPLETELY and return to Conservation Division at the address below within 60 days from plugging date.

**KANSAS CORPORATION COMMISSION
OIL & GAS CONSERVATION DIVISION
WELL PLUGGING RECORD
K.A.R. 82-3-117**

Form CP-4
March 2009
**Type or Print on this Form
Form must be Signed
All blanks must be Filled**

OPERATOR: License #: _____
 Name: _____
 Address 1: _____
 Address 2: _____
 City: _____ State: _____ Zip: _____ + _____
 Contact Person: _____
 Phone: (_____) _____
 Type of Well: (Check one) Oil Well Gas Well OG D&A Cathodic
 Water Supply Well Other: _____ SWD Permit #: _____
 ENHR Permit #: _____ Gas Storage Permit #: _____
 Is ACO-1 filed? Yes No If not, is well log attached? Yes No
 Producing Formation(s): List All (If needed attach another sheet)
 _____ Depth to Top: _____ Bottom: _____ T.D. _____
 _____ Depth to Top: _____ Bottom: _____ T.D. _____
 _____ Depth to Top: _____ Bottom: _____ T.D. _____

API No. 15 - _____
 Spot Description: _____
 _____ - _____ - _____ - _____ Sec. _____ Twp. _____ S. R. _____ East West
 _____ Feet from North / South Line of Section
 _____ Feet from East / West Line of Section
 Footages Calculated from Nearest Outside Section Corner:
 NE NW SE SW
 County: _____
 Lease Name: _____ Well #: _____
 Date Well Completed: _____
 The plugging proposal was approved on: _____ (Date)
 by: _____ (KCC District Agent's Name)
 Plugging Commenced: _____
 Plugging Completed: _____

Show depth and thickness of all water, oil and gas formations.

| Oil, Gas or Water Records | | Casing Record (Surface, Conductor & Production) | | | |
|---------------------------|---------|---|------|---------------|------------|
| Formation | Content | Casing | Size | Setting Depth | Pulled Out |
| | | | | | |
| | | | | | |
| | | | | | |
| | | | | | |

Describe in detail the manner in which the well is plugged, indicating where the mud fluid was placed and the method or methods used in introducing it into the hole. If cement or other plugs were used, state the character of same depth placed from (bottom), to (top) for each plug set.

Plugging Contractor License #: _____ Name: _____
 Address 1: _____ Address 2: _____
 City: _____ State: _____ Zip: _____ + _____
 Phone: (_____) _____
 Name of Party Responsible for Plugging Fees: _____
 State of _____ County, _____, ss.
 _____ Employee of Operator or Operator on above-described well,
 (Print Name)

being first duly sworn on oath, says: That I have knowledge of the facts statements, and matters herein contained, and the log of the above-described well is as filed, and the same are true and correct, so help me God.

Submitted Electronically

TO:
 STATE CORPORATION COMMISSION
 CONSERVATION DIVISION - PLUGGING
 266 N. Main St., Ste. 220
 Wichita, KS 67202-1513

API Well Number: 15-161-20009-00-00
 Spot: SENWSWSW Sec/Twnshp/Rge: 26-11S-8E
880 feet from S Section Line, 4933 feet from E Section Line
 Lease Name: GREEN Well #: 2
 County: RILEY Total Vertical Depth: 1680 feet

Operator License No.: 34742
 Op Name: PIONEER FEEDYARD, LLC
 Address: 1021 COUNTY RD CC
OAKLEY, KS 67748

| String | Size | Depth (ft) | Pulled (ft) | Comments |
|--------|-------|------------|-------------|----------|
| CIBP | 4.5 | 1680 | | |
| PROD | 4.5 | 1675 | | 35 SX |
| SURF | 8.625 | 50 | | 35 SX |

Well Type: OIL UIC Docket No: _____ Date/Time to Plug: 07/03/2025 8:00 AM
 Plug Co. License No.: 35469 Plug Co. Name: FRANKS OILFIELD SERVICE, LLC
 Proposal Rcvd. from: SCOTT SCHIPPERS Company: PIONEER FEEDYARD, LLC. Phone: (785) 675-8974

Proposed Plugging Method: AS PER KCC RULES & REGS

Plugging Proposal Received By: JERRY SPARLING Witness Type: COMPLETE (100%)
 Date/Time Plugging Completed: 07/03/2025 11:30 AM KCC Agent: JERRY SPARLING

Actual Plugging Report:

FRANKS RIG ON THE HOLE. PULLED TUBING & PERFORATED 4 1/2" @ 351'. RAN TUBING BACK IN & TAGGED @ 1320', PUMPED 35 SXS. PULLED TUBING, WAITED 1 HOUR, RAN IN & TAGGED @ 330'. HOOKED UP TO TUBING AND PUMPED 85 SXS COMMON CEMENT & CIRCULATED TO SURFACE.

Perfs:

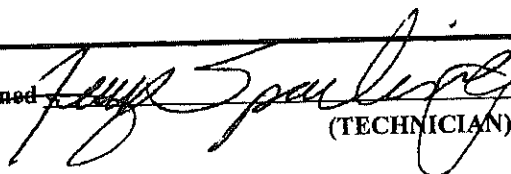
| Top | Bot | Thru | Comments |
|------|------|------|----------|
| 1655 | 1670 | | |

Remarks: FRANKS OILFIELD SERVICE, 120 SXS COMMON CEMENT. COMPLIANC ISSUE/PLGGING AGREEMENT.

Plugged through: CSG

District: 02

Signed


 (TECHNICIAN)