KOLAR Document ID: 1868983

For KCC Use:
Effective Date: 11/24/2025
District # 2
SGA? [ ] Yes [X] No

KANSAS CORPORATION COMMISSION
OIL & GAS CONSERVATION DIVISION

Form C-1
March 2010
Form must be Typed
Form must be Signed
All blanks must be Filled

NOTICE OF INTENT TO DRILL

Must be approved by KCC five (5) days prior to commencing well

Form KSONA-1, Certification of Compliance with the Kansas Surface Owner Notification Act, MUST be submitted with this form.

Expected Spud Date: 11/20/2025 (month / day / year)

OPERATOR: License# 5822
Name: Val Energy, Inc.
Address 1: 8625 E 37TH ST N STE 104
Address 2:
City: WICHITA State: KS Zip: 67226 + 2008
Contact Person: Dustin Wyer
Phone: 316-263-6688

CONTRACTOR: License# 32701
Name: C & G Drilling, Inc.

Well Drilled For:	*Well Class:*	*Type Equipment:*
[X] Oil	[X] Infield	[X] Mud Rotary
[ ] Gas	[ ] Pool Ext.	[ ] Air Rotary
[ ] Enh Rec	[ ] Storage	[ ] Wildcat	[ ] Cable
[ ] Disposal		
[ ] Seismic ; ____ # of Holes	[ ] Other	
[ ] Other:		

[ ] If OWWO: old well information as follows:

Operator:
Well Name:
Original Completion Date: ____ Original Total Depth:

Directional, Deviated or Horizontal wellbore? [ ] Yes [X] No
If Yes, true vertical depth:
Bottom Hole Location:
KCC DKT #:

Spot Description:
S2 (Q/Q/Q/Q) - NE - NW - SW Sec. 13 Twp. 33 S. R. 5 [X] E [ ] W
2040 feet from [ ] N / [X] S Line of Section
990 feet from [ ] E / [X] W Line of Section
Is SECTION: [X] Regular [ ] Irregular?

*(**Note:** Locate well on the Section Plat on reverse side)*

County: Cowley
Lease Name: KADAU Well #: V2-13
Field Name: ALBRIGHT
Is this a Prorated / Spaced Field? [ ] Yes [X] No
Target Formation(s): Mississippi
Nearest Lease or unit boundary line (in footage): 600
Ground Surface Elevation: 1261 Estimated feet MSL
Water well within one-quarter mile: [ ] Yes [X] No
Public water supply well within one mile: [ ] Yes [X] No
Depth to bottom of fresh water: 100
Depth to bottom of usable water: 180
Surface Pipe by Alternate: [X] I [ ] II
Length of Surface Pipe Planned to be set: 200
Length of Conductor Pipe (if any):
Projected Total Depth: 3400
Formation at Total Depth: Miss
Water Source for Drilling Operations:
[ ] Well [X] Farm Pond [ ] Other:
DWR Permit #:
*(**Note:** Apply for Permit with DWR [ ])*
Will Cores be taken? [ ] Yes [X] No
If Yes, proposed zone:

AFFIDAVIT

The undersigned hereby affirms that the drilling, completion and eventual plugging of this well will comply with K.S.A. 55 et. seq.

It is agreed that the following minimum requirements will be met:

1. Notify the appropriate district office ***prior*** to spudding of well;
2. A copy of the approved notice of intent to drill ***shall be*** posted on each drilling rig;
3. The minimum amount of surface pipe as specified below ***shall be set*** by circulating cement to the top; in all cases surface pipe ***shall be set*** through all unconsolidated materials plus a minimum of 20 feet into the underlying formation.
4. If the well is dry hole, an agreement between the operator and the district office on plug length and placement is necessary ***prior to plugging;***
5. The appropriate district office will be notified before well is either plugged or production casing is cemented in;
6. If an ALTERNATE II COMPLETION, production pipe shall be cemented from below any usable water to surface within ***120 DAYS*** of spud date. Or pursuant to Appendix "B" - Eastern Kansas surface casing order #133,891-C, which applies to the KCC District 3 area, alternate II cementing must be completed within 30 days of the spud date or the well shall be plugged. ***In all cases, NOTIFY district office*** prior to any cementing.

Submitted Electronically

For KCC Use ONLY
API # 15 - 15-035-24813-00-00
Conductor pipe required 0 feet
Minimum surface pipe required 200 feet per ALT. [X] I [ ] II
Approved by: CeLena Peterson 11/19/2026
This authorization expires: 11/19/2026
(This authorization void if drilling not started within 12 months of approval date.)

Spud date: ____ Agent: ____

Remember to:

- File Certification of Compliance with the Kansas Surface Owner Notification Act (KSONA-1) with Intent to Drill;
- File Drill Pit Application (form CDP-1) with Intent to Drill;
- File Completion Form ACO-1 within 120 days of spud date;
- File acreage attribution plat according to field proration orders;
- Notify appropriate district office 48 hours prior to workover or re-entry;
- Submit plugging report (CP-4) after plugging is completed (within 60 days);
- Obtain written approval before disposing or injecting salt water.
- If well will not be drilled or permit has expired (See: authorized expiration date) please check the box below and return to the address below.

[ ] **Well will not be drilled or Permit Expired** Date: ____
Signature of Operator or Agent:

13 33 5 [X] E [ ] W

KOLAR Document ID: 1868983

Side Two

For KCC Use ONLY
API # 15 - 15-035-24813-00-00

IN ALL CASES PLOT THE INTENDED WELL ON THE PLAT BELOW

In all cases, please fully complete this side of the form. Include items 1 through 5 at the bottom of this page.

Operator: Val Energy, Inc.
Lease: KADAU
Well Number: V2-13
Field: ALBRIGHT

Number of Acres attributable to well: _____
QTR/QTR/QTR/QTR of acreage: S2 - NE - NW - SW

Location of Well: County: Cowley
2040 feet from ☐ N / ☒ S Line of Section
990 feet from ☐ E / ☒ W Line of Section
Sec. 13 Twp. 33 S. R. 5 ☒ E ☐ W

Is Section: ☒ Regular or ☐ Irregular

If Section is Irregular, locate well from nearest corner boundary.
Section corner used: ☐ NE ☐ NW ☐ SE ☐ SW

PLAT

Show location of the well. Show footage to the nearest lease or unit boundary line. Show the predicted locations of lease roads, tank batteries, pipelines and electrical lines, as required by the Kansas Surface Owner Notice Act (House Bill 2032). You may attach a separate plat if desired.

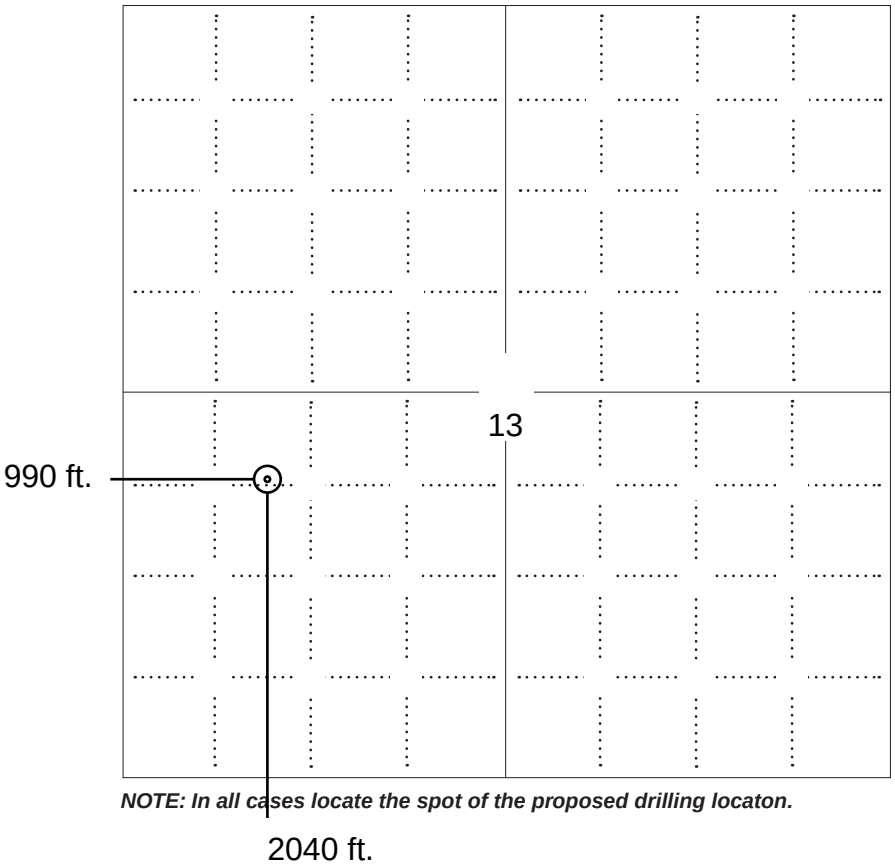

LEGEND

- ○ Well Location
- ▭ Tank Battery Location
- ——— Pipeline Location
- - - - - - Electric Line Location
- ▬▬ Lease Road Location

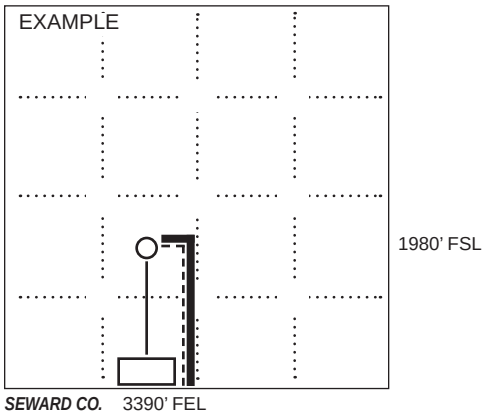

NOTE: In all cases locate the spot of the proposed drilling locaton.

In plotting the proposed location of the well, *you must show*:

1. The manner in which you are using the depicted plat by identifying section lines, i.e. 1 section, 1 section with 8 surrounding sections, 4 sections, etc.
2. The distance of the proposed drilling location from the south / north and east / west outside section lines.
3. The distance to the nearest lease or unit boundary line (in footage).
4. If proposed location is located within a prorated or spaced field a certificate of acreage attribution plat must be attached: (C0-7 for oil wells; CG-8 for gas wells).
5. The predicted locations of lease roads, tank batteries, pipelines, and electrical lines.

KOLAR Document ID: 1868983

KANSAS CORPORATION COMMISSION
OIL & GAS CONSERVATION DIVISION

Form CDP-1
May 2010
Form must be Typed

APPLICATION FOR SURFACE PIT

Submit in Duplicate

Operator Name: Val Energy, Inc.
License Number: 5822

Operator Address: 8625 E 37TH ST N STE 104 WICHITA KS 67226

Contact Person: Dustin Wyer
Phone Number: 316-263-6688

Lease Name & Well No.: KADAU V2-13

Type of Pit:
☐ Emergency Pit ☐ Burn Pit
☐ Settling Pit ☒ Drilling Pit
☐ Workover Pit ☐ Haul-Off Pit
(If WP Supply API No. or Year Drilled)

Pit is:
☒ Proposed ☐ Existing
If Existing, date constructed:
Pit capacity: 11132 (bbls)

Pit Location (QQQQ): S2 - NE - NW - SW
Sec. 13 Twp. 33 R. 5 ☒ East ☐ West
2040 Feet from ☐ North / ☒ South Line of Section
990 Feet from ☐ East / ☒ West Line of Section
Cowley County

Is the pit located in a Sensitive Ground Water Area? ☐ Yes ☒ No

Chloride concentration: _____ mg/l
(For Emergency Pits and Settling Pits only)

Is the bottom below ground level? ☒ Yes ☐ No

Artificial Liner? ☐ Yes ☒ No

How is the pit lined if a plastic liner is not used?
Clay Bottom

Pit dimensions (all but working pits): 125 Length (feet) 125 Width (feet) ☐ N/A: Steel Pits

Depth from ground level to deepest point: 4 (feet) ☐ No Pit

If the pit is lined give a brief description of the liner material, thickness and installation procedure.

Describe procedures for periodic maintenance and determining liner integrity, including any special monitoring.

Distance to nearest water well within one-mile of pit: 4386 feet Depth of water well 200 feet

Depth to shallowest fresh water 40 feet.
Source of information:
☐ measured ☐ well owner ☐ electric log ☒ KDWR

Emergency, Settling and Burn Pits ONLY:

Producing Formation: _____

Number of producing wells on lease: _____

Barrels of fluid produced daily: _____

Does the slope from the tank battery allow all spilled fluids to flow into the pit? ☐ Yes ☐ No

Drilling, Workover and Haul-Off Pits ONLY:

Type of material utilized in drilling/workover: Fresh Mud

Number of working pits to be utilized: 1

Abandonment procedure: Let dry, cover

Drill pits must be closed within 365 days of spud date.

Submitted Electronically

KCC OFFICE USE ONLY

☐ Liner ☐ Steel Pit ☒ RFAC ☐ RFAS

Date Received: 11/18/2025 Permit Number: 15-035-24813-00-00 Permit Date: 11/19/2025 Lease Inspection: ☒ Yes ☐ No

KOLAR Document ID: 1868983

KANSAS CORPORATION COMMISSION
OIL & GAS CONSERVATION DIVISION

Form KSONA-1
July 2021
Form Must Be Typed
Form must be Signed
All blanks must be Filled

CERTIFICATION OF COMPLIANCE WITH THE KANSAS SURFACE OWNER NOTIFICATION ACT

This form must be submitted with all Forms C-1 (Notice of Intent to Drill); CB-1 (Cathodic Protection Borehole Intent); T-1 (Request for Change of Operator Transfer of Injection or Surface Pit Permit); and CP-1 (Well Plugging Application). Any such form submitted without an accompanying Form KSONA-1 will be returned.

Select the corresponding form being filed: ☒ **C-1** (Intent) ☐ **CB-1** (Cathodic Protection Borehole Intent) ☐ **T-1** (Transfer) ☐ **CP-1** (Plugging Application)

OPERATOR: License # 5822
Name: Val Energy, Inc.
Address 1: 8625 E 37TH ST N STE 104
Address 2:
City: WICHITA State: KS Zip: 67226 + 2008
Contact Person: Dustin Wyer
Phone: (316) 2636688 Fax: ( )
Email Address:

Well Location:
S2 NE NW SW Sec. 13 Twp. 33 S. R. 5 ☒ East ☐ West
County: Cowley
Lease Name: KADAU Well #: V2-13

If filing a Form T-1 for multiple wells on a lease, enter the legal description of the lease below:

Surface Owner Information:
Name: Neil Kadau
Address 1: 17972 212th Rd
Address 2:
City: Winfield State: KS Zip: 67156 +

When filing a Form T-1 involving multiple surface owners, attach an additional sheet listing all of the information to the left for each surface owner. Surface owner information can be found in the records of the register of deeds for the county, and in the real estate property tax records of the county treasurer.

If this form is being submitted with a Form C-1 (Intent) or CB-1 (Cathodic Protection Borehole Intent), you must supply the surface owners and the KCC with a plat showing the predicted locations of lease roads, tank batteries, pipelines, and electrical lines. The locations shown on the plat are preliminary non-binding estimates. The locations may be entered on the Form C-1 plat, Form CB-1 plat, or a separate plat may be submitted.

Select one of the following:

☒ I certify that, pursuant to the Kansas Surface Owner Notice Act (*see* Chapter 55 of the Kansas Statutes Annotated), I have provided the following to the surface owner(s) of the land upon which the subject well is or will be located: 1) a copy of the Form C-1, Form CB-1, Form T-1, or Form CP-1 that I am filing in connection with this form; 2) if the form being filed is a Form C-1 or Form CB-1, the plat(s) required by this form; and 3) my operator name, address, phone number, fax, and email address.

☐ I have not provided this information to the surface owner(s). I acknowledge that, because I have not provided this information, the KCC will be required to send this information to the surface owner(s). To mitigate the additional cost of the KCC performing this task, I acknowledge that I must provide the name and address of the surface owner by filling out the top section of this form and that I am being charged a $30.00 handling fee, payable to the KCC, which is enclosed with this form.

If choosing the second option, submit payment of the $30.00 handling fee with this form. If the fee is not received with this form, the KSONA-1 form and the associated Form C-1, Form CB-1, Form T-1, or Form CP-1 will be returned.

Submitted Electronically

ADVANTAGE ELEVATIONS
OIL FIELD SURVEYORS

BOX 8604 - PRATT, KS 67124
(620) 672-6491

1014251
INVOICE NO.

VAL ENERGY INC
OPERATOR

#V2-13
NO.

KADAU
FARM

COWLEY CO. KS
COUNTY

13 33s 5e
S T R

2040' FSL & 990' FWL of Sec.
LOCATION

ELEVATION: 1260' GR

VAL ENERGY INC.
3625 E. 37th N. #104
WICHITA, KS 67226

N

AUTHORIZED BY: Todd Allam

SCALE: 1" = 1000'

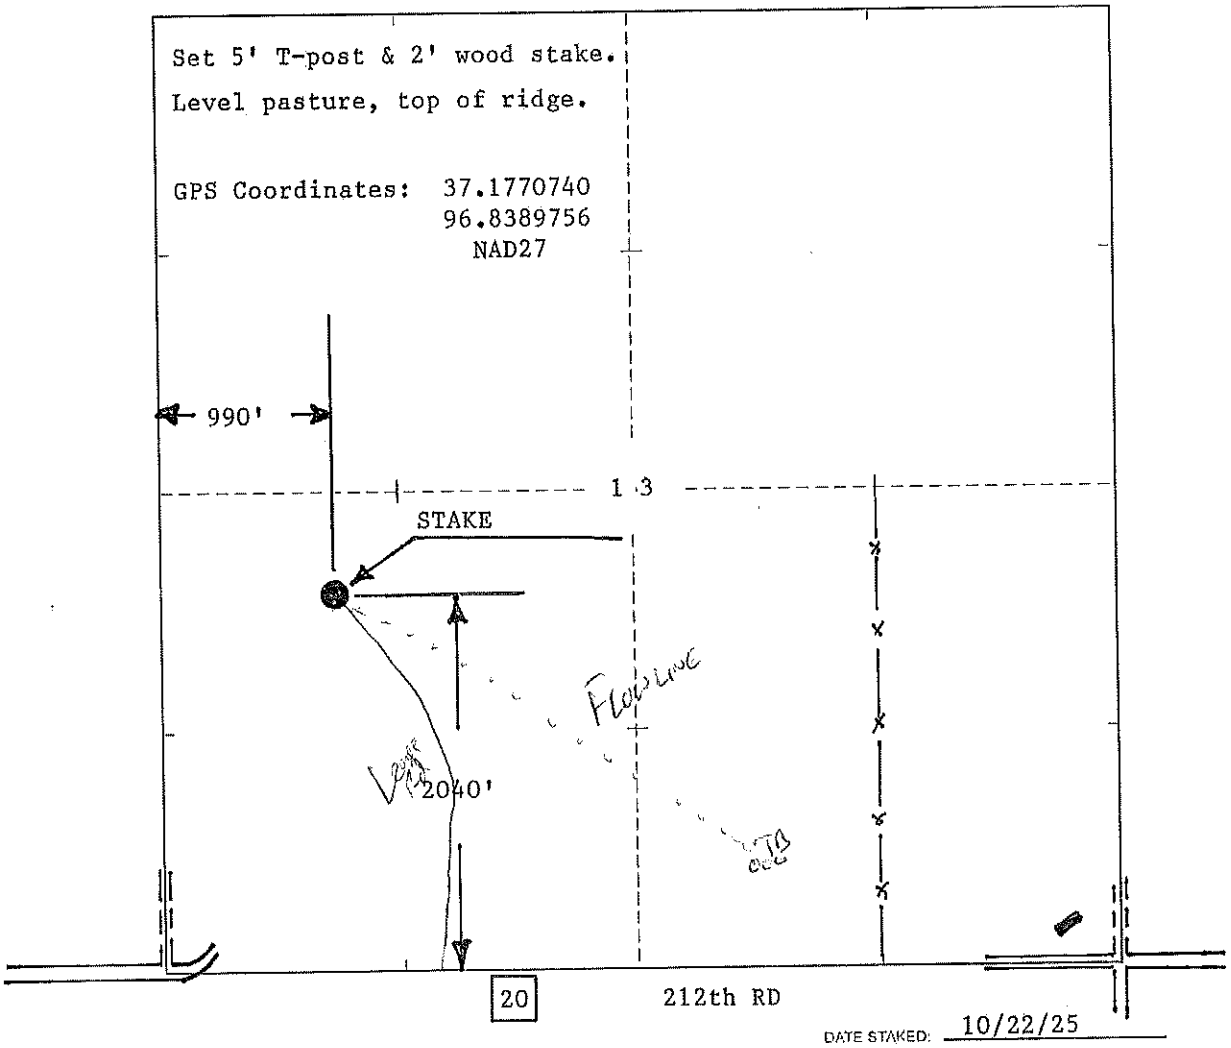

DATE STAKED: 10/22/25

Royse Printing Inc. • Pratt, KS 67124 • 620 672 5456

Conservation Division
266 N. Main St., Ste. 220
Wichita, KS 67202-1513

Kansas
Corporation Commission

Phone: 316-337-6200
Fax: 316-337-6211
http://kcc.ks.gov/

Andrew J. French, Chairperson
Dwight D. Keen, Commissioner
Annie Kuether, Commissioner

Laura Kelly, Governor

November 19, 2025

Dustin Wyer
Val Energy, Inc.
8625 E 37TH ST N STE 104
WICHITA, KS 67226-2008

Re: Drilling Pit Application
KADAU V2-13
SW/4 Sec.13-33S-05E
Cowley County, Kansas

Dear Dustin Wyer:

District staff has inspected the above referenced location and has determined that an unsealed condition will present a pollution threat to water resources.

District staff has recommended that the reserve pit be lined with bentonite or native clay, constructed **without slots**, the bottom shall be flat and reasonably level and the free fluids must be removed. The fluids are to be removed from the reserve pit after drilling operations have ceased.

If production casing is set all completion fluids shall be removed from the working pits daily. NO completion fluids or non-exempt wastes shall be placed in the reserve pit.

The fluids should be taken to an authorized disposal well. Please call the District Office at (316) 337-7400 when the fluids have been removed. Please file form CDP-5 (August 2008), Exploration and Production Waste Transfer, through KOLAR within 30 days of fluid removal.

A copy of this letter should be posted in the doghouse along with the approved Intent to Drill. If you have any questions or concerns please feel free to contact the District Office at (316) 337-7400.