KOLAR Document ID: 1888751

KANSAS CORPORATION COMMISSION
OIL & GAS CONSERVATION DIVISION

Form CP-111
July 2017
Form must be Typed
Form must be signed
All blanks must be complete

TEMPORARY ABANDONMENT WELL APPLICATION

OPERATOR: License# 31652
Name: Norstar Petroleum, Inc.
Address 1: 88 INVERNESS CIR E
Address 2: UNIT F104
City: ENGLEWOOD State: CO Zip: 80112 + 5514
Contact Person: Per Burchardt
Phone: (303) 9250696
Contact Person Email:
Field Contact Person:
Field Contact Person Phone: ( )

API No. 15- 15-079-19028-00-00
Spot Description:
- - SW-SW Sec. 31 Twp. 22 S. R. 3 ☐ E ☑ W
660 feet from ☐ N / ☑ S Line of Section
4620 feet from ☑ E / ☐ W Line of Section
GPS Location: Lat: (e.g. xx.xxxxx) , Long: (e.g. -xxx.xxxxx)
Datum: ☐ NAD27 ☐ NAD83 ☐ WGS84
County: Harvey Elevation: ☐ GL ☐ KB
Lease Name: FREDERICK B Well #: 1
Well Type: *(check one)* ☑ Oil ☐ Gas ☐ OG ☐ WSW ☐ Other:
☐ SWD Permit #: ☐ ENHR Permit #:
☐ Gas Storage Permit #:
Spud Date: 11/21/1962 Date Shut-In: 03/14/2025

	Conductor	Surface	Production	Intermediate	Liner	Tubing
Size	N/A	8.625	5.5	N/A	N/A	2.875
Setting Depth		306	3369			3019
Amount of Cement		250	250			N/A
Top of Cement		0	N/A			N/A
Bottom of Cement		306	3369			N/A

Casing Fluid Level from Surface: 2016 How Determined? FLUID LEVEL Date: 02/03/2026
Casing Squeeze(s): (top) to (bottom) w / sacks of cement, (top) to (bottom) w / sacks of cement. Date:
Do you have a valid Oil & Gas Lease? ☑ Yes ☐ No
Depth and Type: ☐ Junk in Hole at (depth) ☐ Tools in Hole at (depth) Casing Leaks: ☐ Yes ☑ No Depth of casing leak(s):
Type Completion: ☑ ALT. I ☐ ALT. II Depth of: ☐ DV Tool: (depth) w / sacks of cement ☐ Port Collar: (depth) w / sack of cement
Packer Type: Size: Inch Set at: Feet
Total Depth: 3335 Plug Back Depth: Plug Back Method:

Geological Date:

Formation Name	Formation Top	Formation Base	Completion Information
1.	At:	to Feet	Perforation Interval 3330 to 3333 Feet or Open Hole Interval to Feet
2.	At:	to Feet	Perforation Interval to Feet or Open Hole Interval to Feet

UNDER PENALTY OF PERJURY I HEREBY ATTEST THAT THE INFORMATION CONTAINED HEREIN IS TRUE AND CORRECT TO THE BEST OF MY KNOWLEDGE

Submitted Electronically

***Do NOT Write in This Space* - KCC USE ONLY**

Date Tested:	Results:	Date Plugged:	Date Repaired:	Date Put Back in Service:

Review Completed by: Virgil Clothier Comments:
TA Approved: ☑ Yes ☐ Denied Date: 02/12/2026

Mail to the Appropriate KCC Conservation Office:

KCC District Office #1 - 210 E. Frontview, Suite A, Dodge City, KS 67801	Phone 620.682.7933
KCC District Office #2 - 3450 N. Rock Road, Building 600, Suite 601, Wichita, KS 67226	Phone 316.337.7400
KCC District Office #3 - 137 E. 21st St., Chanute, KS 66720	Phone 620.902.6450
KCC District Office #4 - 2301 E. 13th Street, Hays, KS 67601-2651	Phone 785.261.6250

PHONE-940-767-4334 ECHOMETER COMPANY PHONE-940-767-4334 ECHOMETER COMPANY PHONE-940-76

02/03/2026 16:25:13

WELL Frederick B #1 Norstar

CASING PRESSURE 0

ΔP

ΔT

PRODUCTION RATE

JOINTS TO LIQUID 63

DISTANCE TO LIQUID 2016

PBHP

SBHP

PROD RATE EFF, %

MAX PRODUCTION

QUIET WELL

UPPER COLLARS A: 10.0

P-P 0.021 mV

LIQUID LEVEL A: 8.7

P-P 0.042 mV

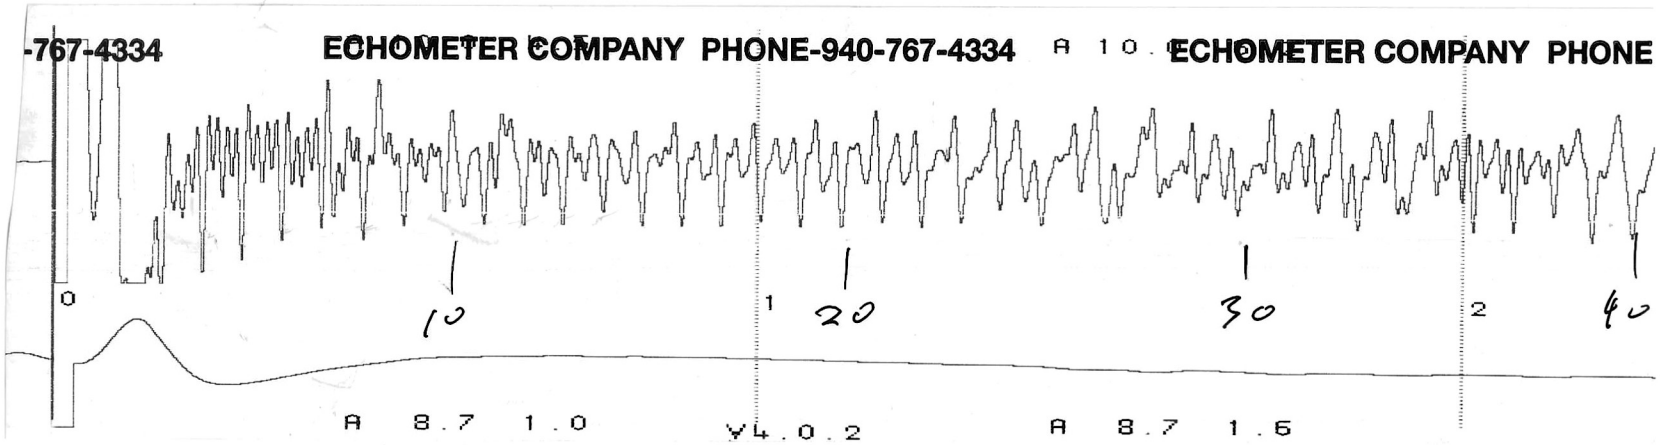

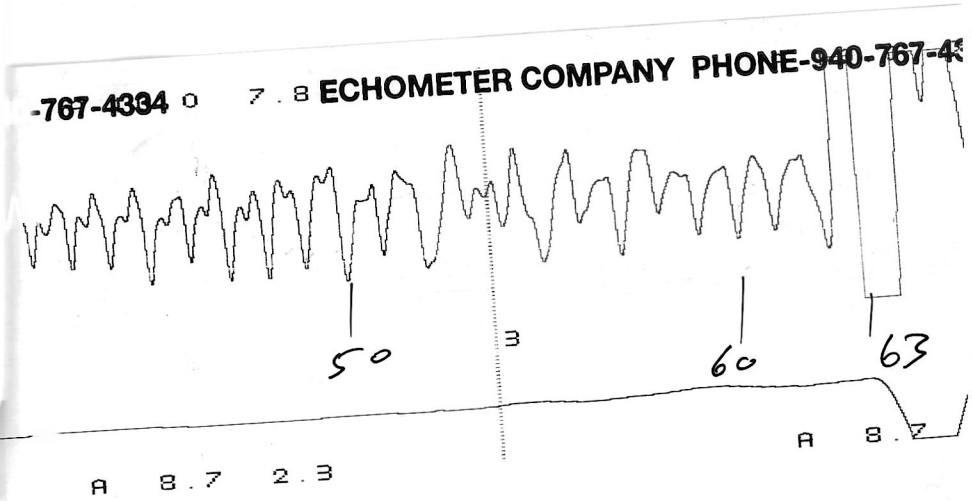

Conservation Division
District Office No. 2
3450 N. Rock Road
Building 600, Suite 601
Wichita, KS 67226

Kansas
Corporation Commission

Phone: 316-337-7400
http://kcc.ks.gov/

Andrew J. French, Chairperson
Dwight D. Keen, Commissioner
Annie Kuether, Commissioner

Laura Kelly, Governor

02/12/2026

Per Burchardt
Norstar Petroleum, Inc.
88 INVERNESS CIR E
UNIT F104
ENGLEWOOD, CO 80112-5514

Re: Temporary Abandonment
API 15-079-19028-00-00
FREDERICK B 1
SW/4 Sec.31-22S-03W
Harvey County, Kansas

Dear Per Burchardt:

"Your temporary abandonment (TA) application for the well listed above has been approved. In accordance with K.A.R. 82-3-111 the TA status of this well will expire 02/12/2027.

* If you return this well to service or plug it, please notify the District Office.

* If you sell this well you are required to file a Transfer of Operator form, T-1.

* If the well will remain temporarily abandoned, you must submit a new TA application, CP-111, before 02/12/2027.

You may contact me at the number above if you have questions.

Very truly yours,

Virgil Clothier"