

E M

For KCC Use ONLY

API # 15 - _____

IN ALL CASES PLOT THE INTENDED WELL ON THE PLAT BELOW

In all cases, please fully complete this side of the form. Include items 1 through 5 at the bottom of this page.

Operator: _____

Lease: _____

Well Number: _____

Field: _____


Number of Acres attributable to well: _____

QTR/QTR/QTR/QTR of acreage: _____ - _____ - _____ - _____

Location of Well: County: _____

_____ feet from ☐ N / ☐ S Line of Section_____ feet from ☐ E / ☐ W Line of SectionSec. _____ Twp. _____ S. R. _____ ☐ E ☐ WIs Section: ☐ Regular or ☐ Irregular**If Section is Irregular, locate well from nearest corner boundary.**Section corner used: ☐ NE ☐ NW ☐ SE ☐ SW**PLAT**

Show location of the well. Show footage to the nearest lease or unit boundary line. Show the predicted locations of lease roads, tank batteries, pipelines and electrical lines, as required by the Kansas Surface Owner Notice Act (House Bill 2032). You may attach a separate plat if desired.

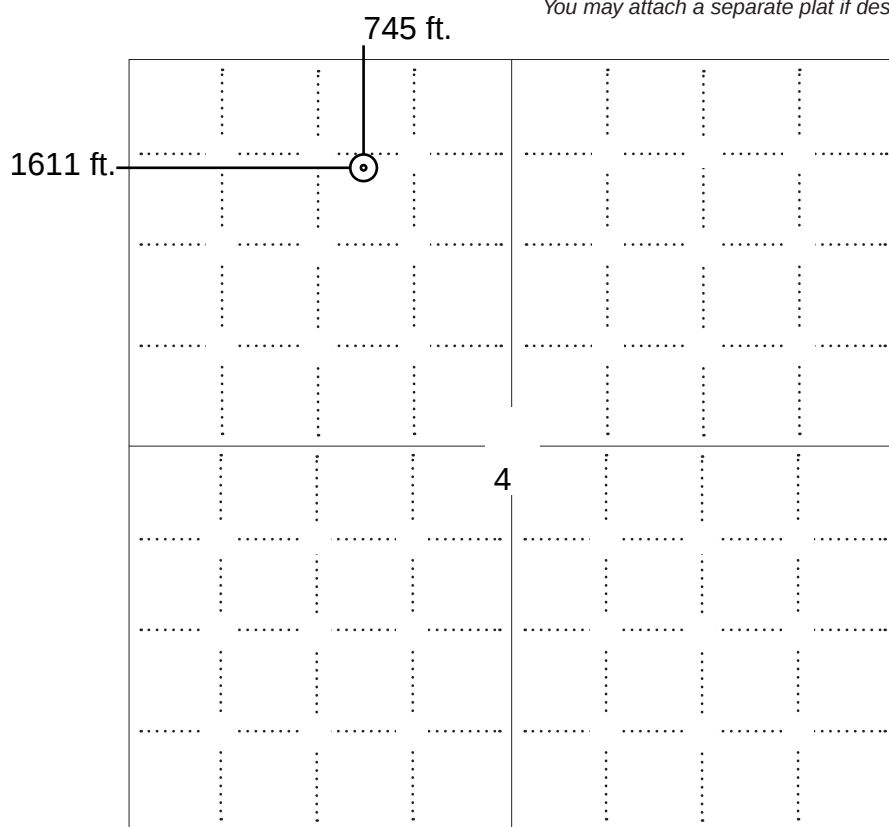**LEGEND**

- ☐ Well Location
- ☐ Tank Battery Location
- ☐ Pipeline Location
- ☐ Electric Line Location
- ☐ Lease Road Location

**NOTE: In all cases locate the spot of the proposed drilling location.****In plotting the proposed location of the well, you must show:**

1. The manner in which you are using the depicted plat by identifying section lines, i.e. 1 section, 1 section with 8 surrounding sections, 4 sections, etc.
2. The distance of the proposed drilling location from the south / north and east / west outside section lines.
3. The distance to the nearest lease or unit boundary line (in footage).
4. If proposed location is located within a prorated or spaced field a certificate of acreage attribution plat must be attached: (C0-7 for oil wells; CG-8 for gas wells).
5. The predicted locations of lease roads, tank batteries, pipelines, and electrical lines.

KANSAS CORPORATION COMMISSION
OIL & GAS CONSERVATION DIVISION
APPLICATION FOR SURFACE PIT

Form CDP-1
May 2010
Form must be Typed

Submit in Duplicate

Operator Name:		License Number:	
Operator Address:			
Contact Person:		Phone Number:	
Lease Name & Well No.:		Pit Location (QQQQ): ____ - ____ - ____ - ____ Sec. ____ Twp. ____ R. ____ ☐ East ☐ West ____ Feet from ☐ North / ☐ South Line of Section ____ Feet from ☐ East / ☐ West Line of Section ____ County	
Type of Pit: ☐ Emergency Pit ☐ Burn Pit ☐ Settling Pit ☐ Drilling Pit ☐ Workover Pit ☐ Haul-Off Pit <i>(If WP Supply API No. or Year Drilled)</i>	Pit is: ☐ Proposed ☐ Existing If Existing, date constructed: _____ Pit capacity: _____ (bbls)		
Is the pit located in a Sensitive Ground Water Area? ☐ Yes ☐ No		Chloride concentration: _____ mg/l <i>(For Emergency Pits and Settling Pits only)</i>	
Is the bottom below ground level? ☐ Yes ☐ No	Artificial Liner? ☐ Yes ☐ No	How is the pit lined if a plastic liner is not used?	
Pit dimensions (all but working pits): _____ Length (feet) _____ Width (feet) ☐ N/A: Steel Pits Depth from ground level to deepest point: _____ (feet) ☐ No Pit			
If the pit is lined give a brief description of the liner material, thickness and installation procedure.		Describe procedures for periodic maintenance and determining liner integrity, including any special monitoring.	
Distance to nearest water well within one-mile of pit: _____ feet Depth of water well _____ feet		Depth to shallowest fresh water _____ feet. Source of information: ☐ measured ☐ well owner ☐ electric log ☐ KDWR	
Emergency, Settling and Burn Pits ONLY: Producing Formation: _____ Number of producing wells on lease: _____ Barrels of fluid produced daily: _____ Does the slope from the tank battery allow all spilled fluids to flow into the pit? ☐ Yes ☐ No		Drilling, Workover and Haul-Off Pits ONLY: Type of material utilized in drilling/workover: _____ Number of working pits to be utilized: _____ Abandonment procedure: _____ _____ Drill pits must be closed within 365 days of spud date.	
Submitted Electronically			

KCC OFFICE USE ONLY

☐ Liner ☐ Steel Pit ☐ RFAC ☐ RFAS

Date Received: _____ Permit Number: _____ Permit Date: _____ Lease Inspection: ☐ Yes ☐ No

KANSAS CORPORATION COMMISSION
OIL & GAS CONSERVATION DIVISION

Form KSONA-1

July 2021

Form Must Be Typed

Form must be Signed

All blanks must be Filled

CERTIFICATION OF COMPLIANCE WITH THE KANSAS SURFACE OWNER NOTIFICATION ACT

This form must be submitted with all Forms C-1 (Notice of Intent to Drill); CB-1 (Cathodic Protection Borehole Intent); T-1 (Request for Change of Operator Transfer of Injection or Surface Pit Permit); and CP-1 (Well Plugging Application). Any such form submitted without an accompanying Form KSONA-1 will be returned.

Select the corresponding form being filed: ☐ **C-1** (Intent) ☐ **CB-1** (Cathodic Protection Borehole Intent) ☐ **T-1** (Transfer) ☐ **CP-1** (Plugging Application)

OPERATOR: License # _____

Name: _____

Address 1: _____

Address 2: _____

City: _____ State: _____ Zip: _____ + _____

Contact Person: _____

Phone: (_____) _____ Fax: (_____) _____

Email Address: _____

Well Location:

____ - ____ - ____ Sec. ____ Twp. ____ S. R. ____ ☐ East ☐ West

County: _____

Lease Name: _____ Well #: _____

If filing a Form T-1 for multiple wells on a lease, enter the legal description of the lease below:

Surface Owner Information:

Name: _____

Address 1: _____

Address 2: _____

City: _____ State: _____ Zip: _____ + _____

When filing a Form T-1 involving multiple surface owners, attach an additional sheet listing all of the information to the left for each surface owner. Surface owner information can be found in the records of the register of deeds for the county, and in the real estate property tax records of the county treasurer.

If this form is being submitted with a Form C-1 (Intent) or CB-1 (Cathodic Protection Borehole Intent), you must supply the surface owners and the KCC with a plat showing the predicted locations of lease roads, tank batteries, pipelines, and electrical lines. The locations shown on the plat are preliminary non-binding estimates. The locations may be entered on the Form C-1 plat, Form CB-1 plat, or a separate plat may be submitted.

Select one of the following:

- ☐ I certify that, pursuant to the Kansas Surface Owner Notice Act (see Chapter 55 of the Kansas Statutes Annotated), I have provided the following to the surface owner(s) of the land upon which the subject well is or will be located: 1) a copy of the Form C-1, Form CB-1, Form T-1, or Form CP-1 that I am filing in connection with this form; 2) if the form being filed is a Form C-1 or Form CB-1, the plat(s) required by this form; and 3) my operator name, address, phone number, fax, and email address.
- ☐ I have not provided this information to the surface owner(s). I acknowledge that, because I have not provided this information, the KCC will be required to send this information to the surface owner(s). To mitigate the additional cost of the KCC performing this task, I acknowledge that I must provide the name and address of the surface owner by filling out the top section of this form and that I am being charged a \$30.00 handling fee, payable to the KCC, which is enclosed with this form.

If choosing the second option, submit payment of the \$30.00 handling fee with this form. If the fee is not received with this form, the KSONA-1 form and the associated Form C-1, Form CB-1, Form T-1, or Form CP-1 will be returned.

I Submitted Electronically

I



24-17s-35w-Bar-999
CRD NO.

00-17s-35w
DMT NO.

PRO-STAKE LLC

Oil field & Construction Site Staking

20639
INVOICE NO.



Landmark Resources, Inc.

OPERATOR

JJARD North #1-4

LEASE NAME

NW/4 Sec. 4-T17S-R35W

LEGAL DESCRIPTION

Wichita Co. KS

COUNTY

745' FNL - 1611' FWL

FOOTAGE CALLS

3209.5'

GR ELEVATION

P.O. Box 1575
Leoti, Ks. 67861
Jay Koehn: 620-874-0022
jay@prostakellc.com

SCALE: 1" = 1000'
DATE STAKED: Feb. 10, 2026
MEASURED BY: Jay K.
DRAWN BY: Jay K.
AUTHORIZED BY: Becky P.

LEGEND

- irr. well
- water hydrant
- tank battery
- staked loc.
- prod. well / aband. well
- house
- building
- gas line
- water line
- transmission powerline
- 3 phase powerline
- single phase powerline
- fence
- gravel / sand rd.
- gravel trail / lease rd.
- dirt rd.
- dirt trail / lease rd.
- Hwy / blacktop rd.




DIRECTIONS: From the intersection of Hwy K-96 & Hwy K-25 in Leoti, KS – proceed east on Hwy K-96 for 7.5 miles – turn left onto Rd 20/Marienthal Rd. and proceed north for 9 miles – turn right onto G Rd and proceed east for 1.3 miles to an ingress stake “south into” – from this point, the staked location is 745’ south in field with corn stalks

NAD 83
LAT: 38.610761°
LONG: -101.196496°

SPCS NAD 27 KS-S
X: 1229661
Y: 719033

LANDOWNER: John Simmons 620-290-9681

*This drawing does not constitute a monumented survey or a land survey plat.
This drawing is for construction purposes only.*

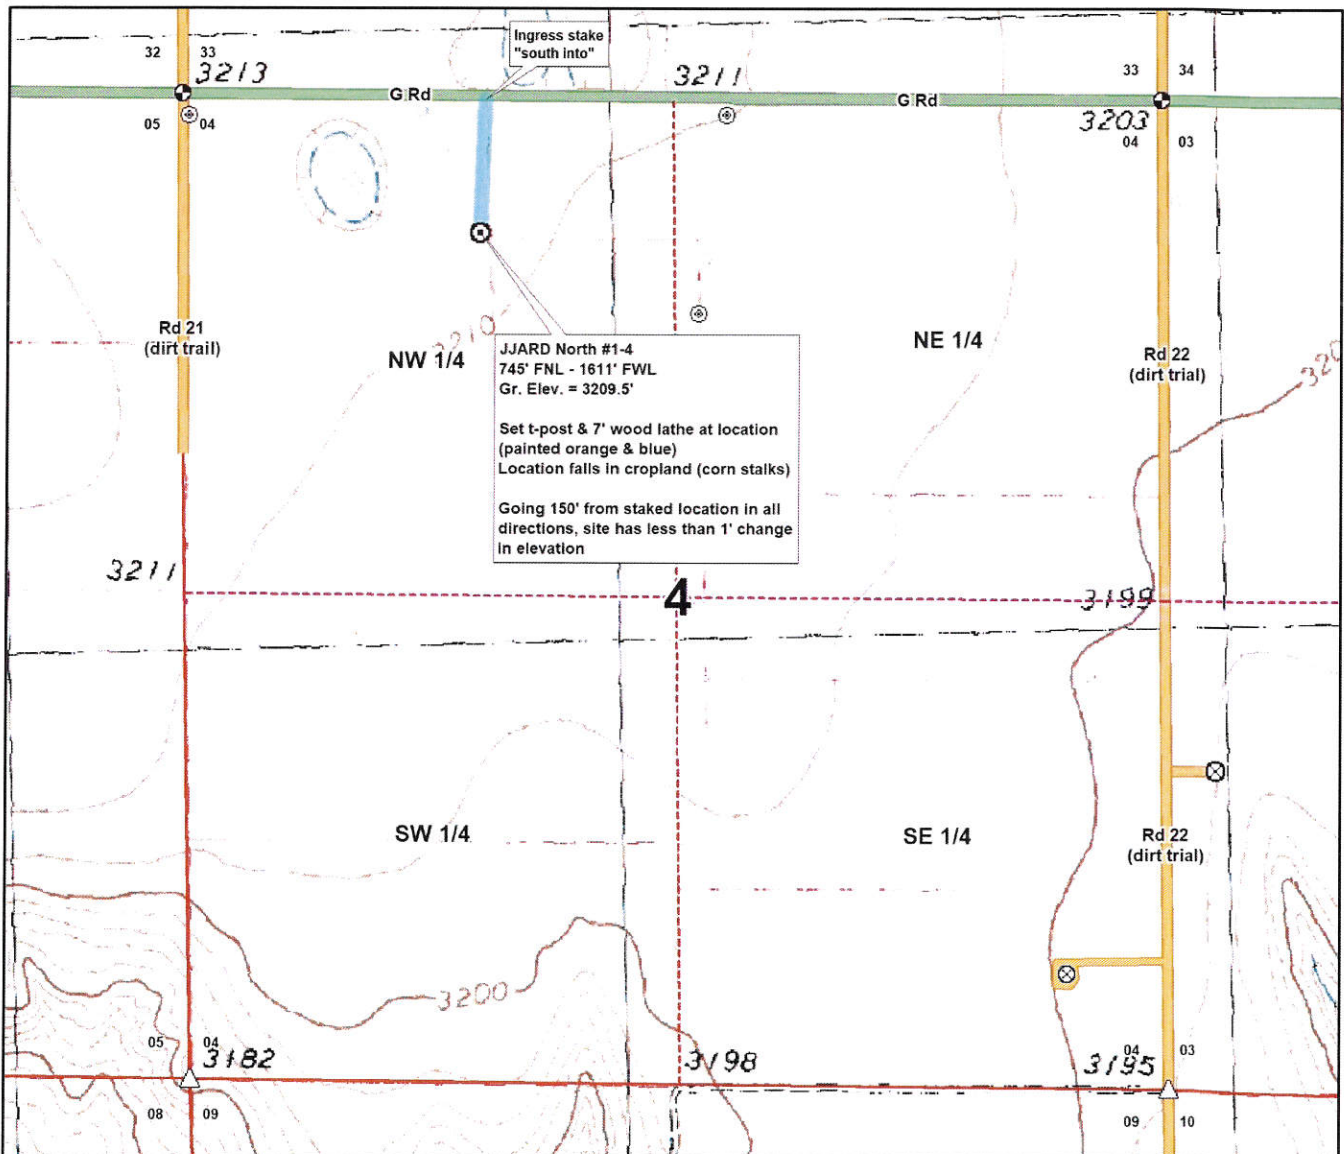



24-17s-35w-Bar-999

CRD NO.

00-17s-35w


DMT NO.

PRO-STAKE LLC

Oil field & Construction Site Staking

20639

INVOICE NO.

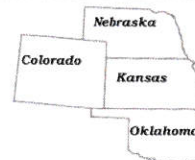

Landmark Resources, Inc.

OPERATOR

JJARD North #1-4

LEASE NAME

NW/4 Sec. 4-T17S-R35W

LEGAL DESCRIPTION

Wichita Co. KS

COUNTY

745' FNL - 1611' FWL

FOOTAGE CALLS

3209.5'

GR ELEVATION

P.O. Box 1575

Leoti, Ks. 67861

Jay Koehn: 620-874-0022

jay@prostakellc.com

LEGEND

- | | | |
|--------------------------|----------------------------|--------------------------|
| ⊙ irr. well | —G— gas line | ▬ gravel/sand rd. |
| ⊕ water hydrant | —W— water line | ▬ gravel trail/lease rd. |
| ⊕ tank battery | —E— transmission powerline | ▬ dirt rd. |
| ⊕ staked loc. | —3— 3 phase powerline | ▬ dirt trail/lease rd. |
| ⊕ prod. well/aband. well | —S— single phase powerline | ▬ Hwy/blacktop rd. |
| ⊕ house | —X—X— fence | |
| □ building | | |

SCALE: N/A

DATE STAKED: Feb. 10, 2026

MEASURED BY: Jay K.

DRAWN BY: Jay K.

AUTHORIZED BY: Becky P.



DIRECTIONS: From the intersection of Hwy K-96 & Hwy K-25 in Leoti, KS – proceed east on Hwy K-96 for 7.5 miles – turn left onto Rd 20/Marienthal Rd. and proceed north for 9 miles – turn right onto G Rd and proceed east for 1.3 miles to an ingress stake “south into” – from this point, the staked location is 745' south in field with corn stalks

NAD 83

SPCS NAD 27 KS-S

LAT: 38.610761°


X: 1229661

LONG: -101.196496°

Y: 719033

LANDOWNER: John Simmons 620-290-9681

*This drawing does not constitute a monumented survey or a land survey plat.
This drawing is for construction purposes only.*

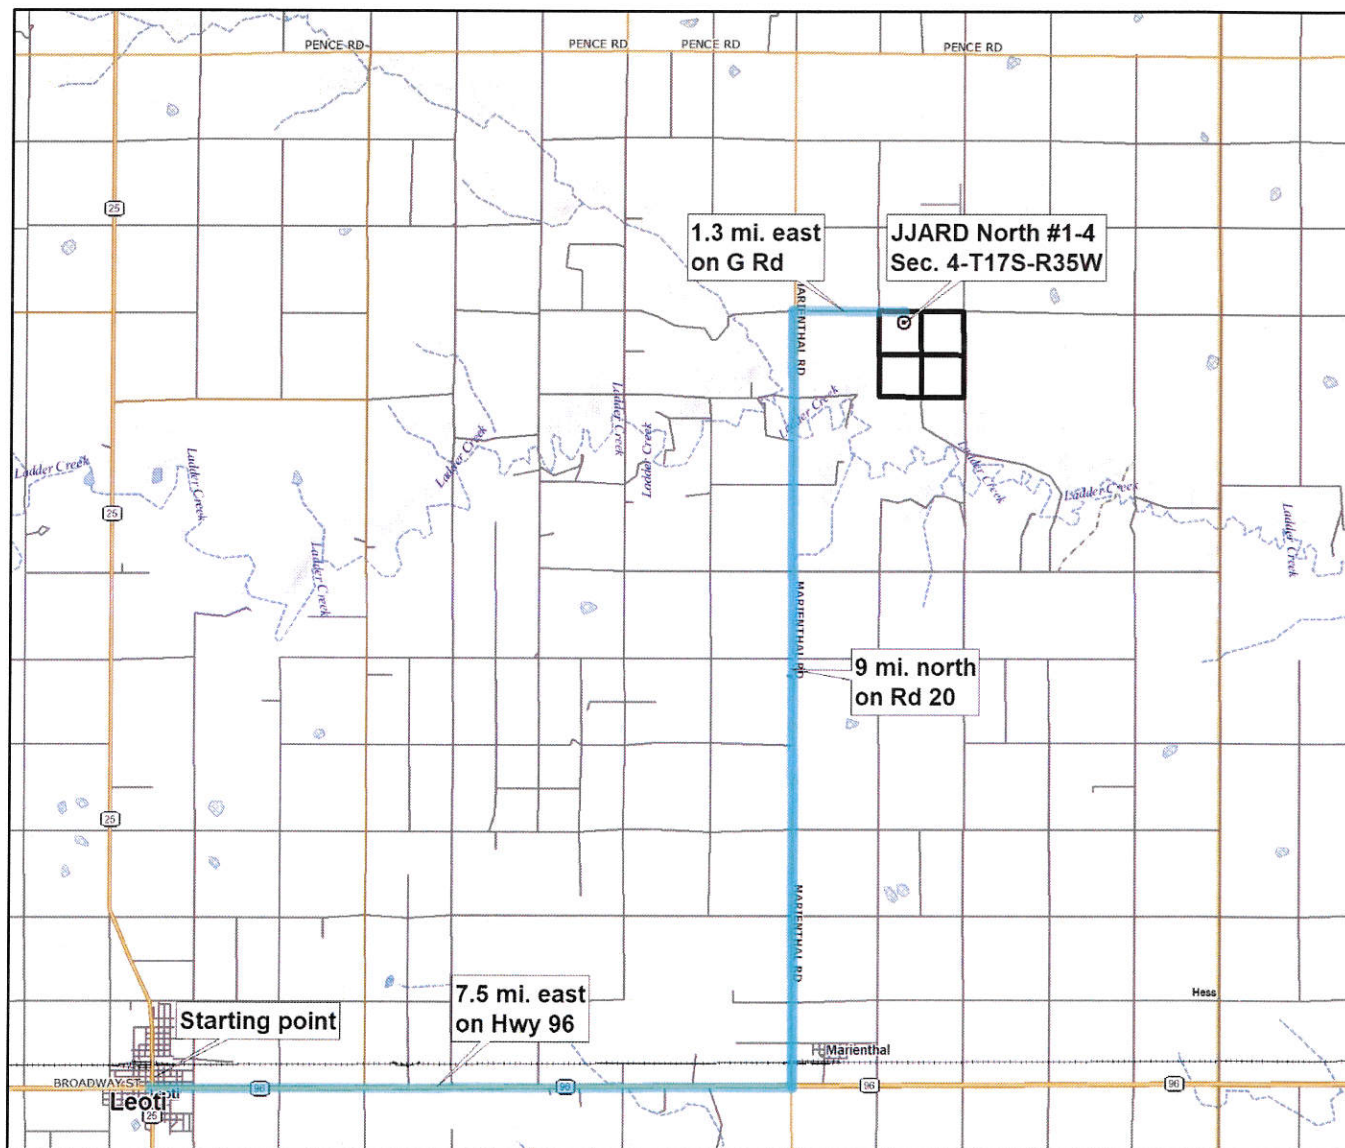




24-17s-35w-Bar-999
CRD NO.

00-17s-35w
DMT NO.

PRO-STAKE LLC

Oil field & Construction Site Staking

20639
INVOICE NO.

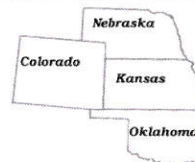

Landmark Resources, Inc.

OPERATOR

JJARD North #1-4

LEASE NAME

NW/4 Sec. 4-T17S-R35W

LEGAL DESCRIPTION

Wichita Co. KS

COUNTY

745' FNL - 1611' FWL

FOOTAGE CALLS

3209.5'

GR ELEVATION

P.O. Box 1575

Leoti, Ks. 67861

Jay Koehn: 620-874-0022

jay@prostakellc.com

SCALE: N/A

DATE STAKED: Feb. 10, 2026

MEASURED BY: Jay K.

DRAWN BY: Jay K.

AUTHORIZED BY: Becky P.

- LEGEND
- irr. well
 - water hydrant
 - tank battery
 - staked loc.
 - prod. well / aband. well
 - house
 - building
 - gas line
 - water line
 - transmission powerline
 - 3 phase powerline
 - single phase powerline
 - fence

- gravel / sand rd.
- gravel trail / lease rd.
- dirt rd.
- dirt trail / lease rd.
- Hwy / blacktop rd.




DIRECTIONS: From the intersection of Hwy K-96 & Hwy K-25 in Leoti, KS – proceed east on Hwy K-96 for 7.5 miles – turn left onto Rd 20/Marienthal Rd. and proceed north for 9 miles – turn right onto G Rd and proceed east for 1.3 miles to an ingress stake “south into” – from this point, the staked location is 745’ south in field with corn stalks

NAD 83
LAT: 38.610761°
LONG: -101.196496°

SPCS NAD 27 KS-S
X: 1229661
Y: 719033

LANDOWNER: John Simmons 620-290-9681

*This drawing does not constitute a monumented survey or a land survey plat.
This drawing is for construction purposes only.*

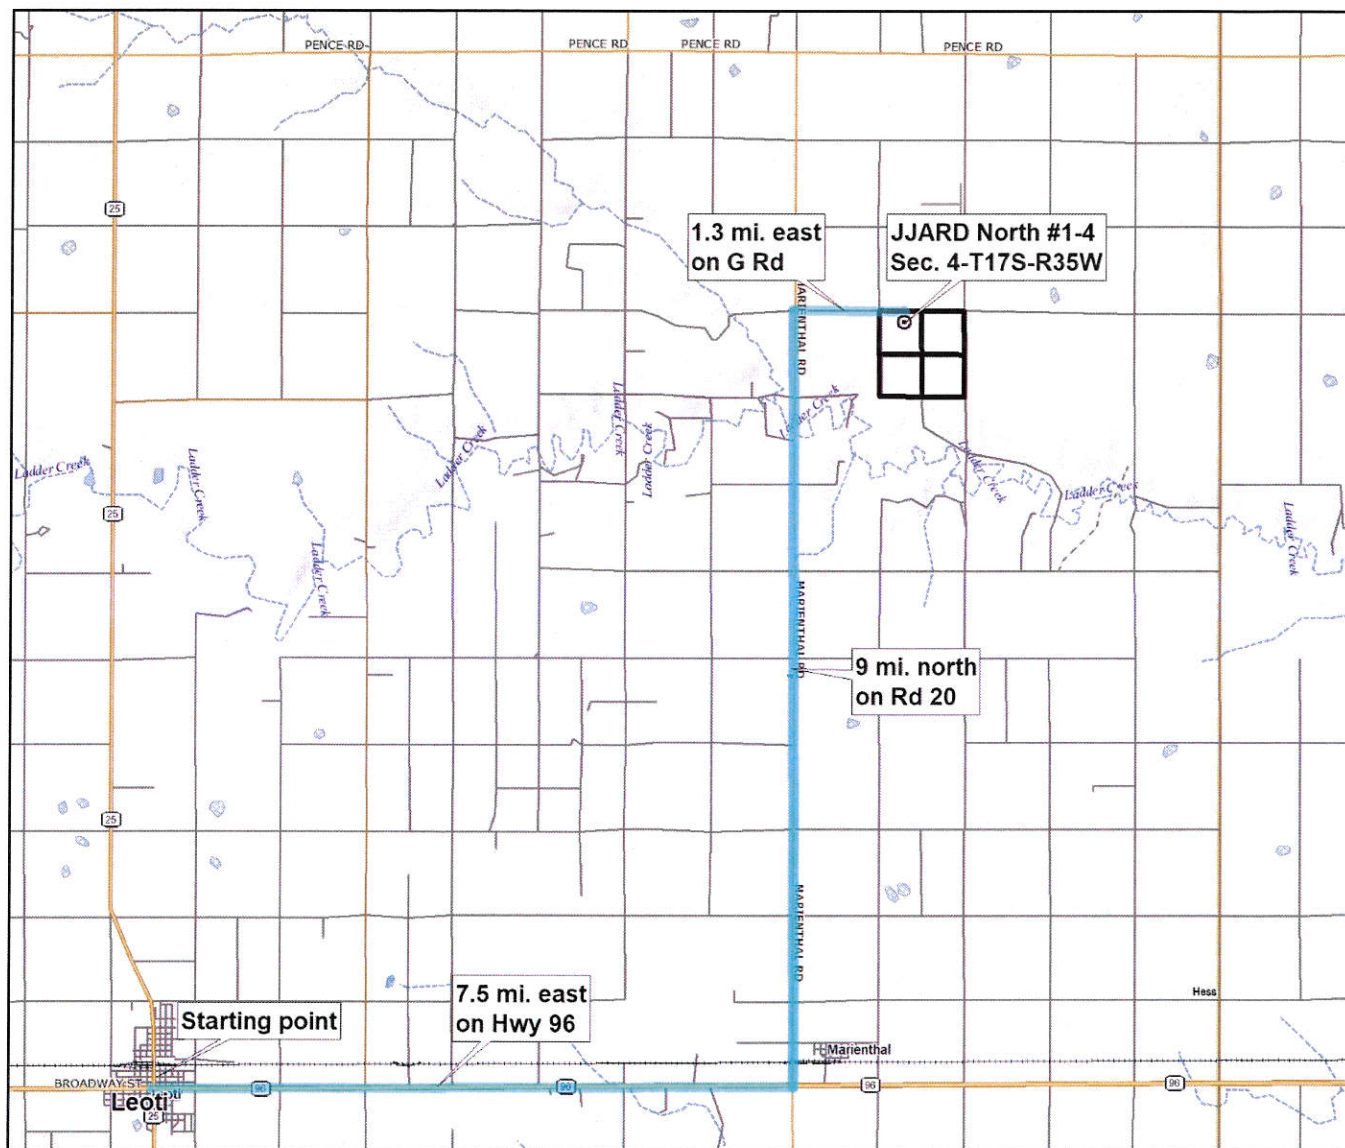




24-17s-35w-Bar-999
CRD NO.

00-17s-35w
DMT NO.

PRO-STAKE LLC

Oil field & Construction Site Staking

20639
INVOICE NO.

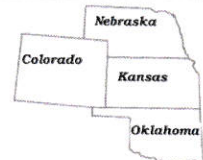

Landmark Resources, Inc.
OPERATOR

JJARD North #1-4
LEASE NAME

NW/4 Sec. 4-T17S-R35W
LEGAL DESCRIPTION

Wichita Co. KS
COUNTY

745' FNL - 1611' FWL
FOOTAGE CALLS

3209.5'
GR ELEVATION

P.O. Box 1575
Leoti, Ks. 67861
Jay Koehn: 620-874-0022
jay@prostakellc.com

SCALE: 1" = 1000'
DATE STAKED: Feb. 10, 2026
MEASURED BY: Jay K.
DRAWN BY: Jay K.
AUTHORIZED BY: Becky P.

- irr. well
- water hydrant
- tank battery
- staked loc.
- prod. well / aband. well
- house
- building

- LEGEND
- gas line
 - water line
 - transmission powerline
 - 3 phase powerline
 - single phase powerline
 - fence

- gravel / sand rd.
- gravel trail / lease rd.
- dirt rd.
- dirt trail / lease rd.
- Hwy / blacktop rd.




DIRECTIONS: From the intersection of Hwy K-96 & Hwy K-25 in Leoti, KS – proceed east on Hwy K-96 for 7.5 miles – turn left onto Rd 20/Marienthal Rd. and proceed north for 9 miles – turn right onto G Rd and proceed east for 1.3 miles to an ingress stake “south into” – from this point, the staked location is 745’ south in field with corn stalks

NAD 83
LAT: 38.610761°
LONG: -101.196496°

SPCS NAD 27 KS-S
X: 1229661
Y: 719033

LANDOWNER: John Simmons 620-290-9681

*This drawing does not constitute a monumented survey or a land survey plat.
This drawing is for construction purposes only.*

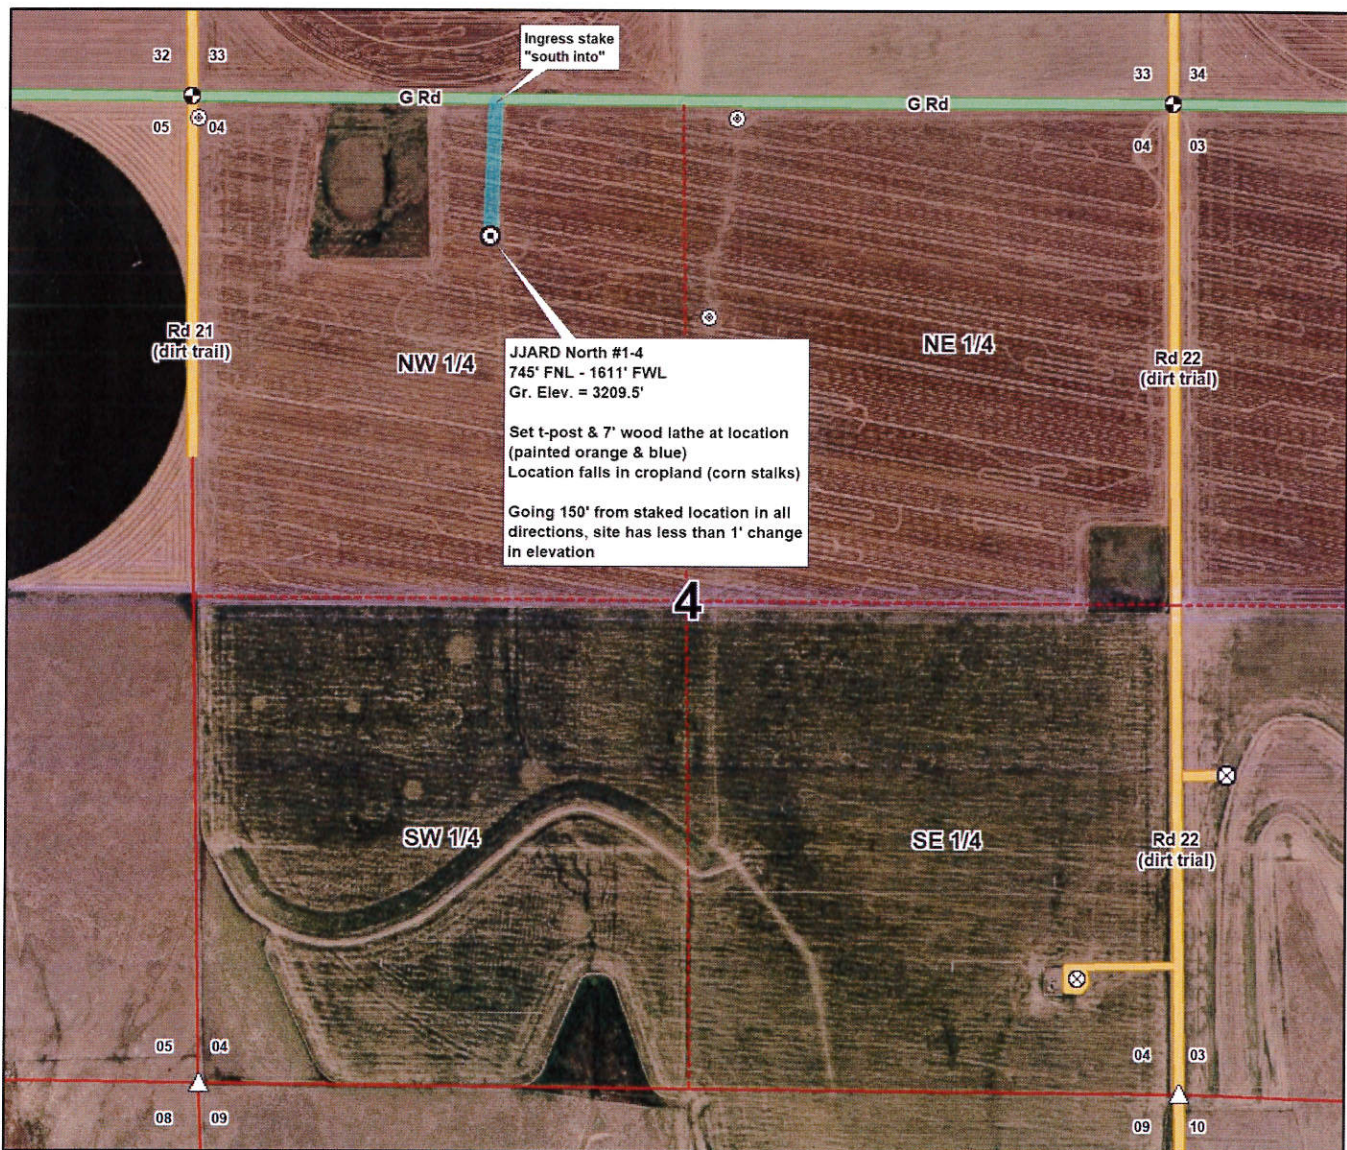



PETRA 2/11/2026 10:30:54 AM

Landmark Resources, Inc.

1-4 JJARD North

Section 4, T17S, R35W

Wichita Co., Kansas

WELL SYMBOLS

○ Location Only

● Oil Well

⊕ Dry Hole, With Show of Oil

● Filled Hexagon

0 1,000 2,000

FEET

February 11, 2026

Conservation Division
266 N. Main St., Ste. 220
Wichita, KS 67202-1513



Phone: 316-337-6200
Fax: 316-337-6211
<http://kcc.ks.gov/>

Andrew J. French, Chairperson
Dwight D. Keen, Commissioner
Annie Kuether, Commissioner

Laura Kelly, Governor

February 19, 2026

Jeff Wood
Landmark Resources, Inc.
4900 Woodway Dr
Suite 880
Houston, TX 77056-1881

Re: Drilling Pit Application
JJARD North 1-4
NW/4 Sec.04-17S-35W
Wichita County, Kansas

Dear Jeff Wood:

District staff has inspected the above referenced location and has determined that the reserve pit shall be constructed **without slots**, the bottom shall be flat and reasonably level, and the free fluids must be removed. The fluids are to be removed from the reserve pit within 96 hours of completion of drilling operations.

If production casing is set all completion fluids shall be removed from the working pits daily. NO completion fluids or non-exempt wastes shall be placed in the reserve pit.

The fluids should be taken to an authorized disposal well. Please call the District Office at (620) 682-7933 when the fluids have been removed. Please file form CDP-5 (August 2008), Exploration and Production Waste Transfer, through KOLAR within 30 days of fluid removal.

A copy of this letter should be posted in the doghouse along with the approved Intent to Drill. If you have any questions or concerns please feel free to contact the District Office at (620) 682-7933.