

WATER WELL RECORD (WWC-5)

Plugged

KOLAR DOC ID _____ WELL ID _____

LOCATION OF WATER WELL

County		Section		Township		Range	E W	Fraction	¼	¼	¼
Latitude		Longitude		Datum		Elevation					

WATER WELL OWNER

Name	
Business	
Address	
Well location at owner's address	

WELL WATER USE

--

WELL INFORMATION

Depth of well:	ft.
Dry well	
Static water level in well:	ft.
measured below land surface on (mm/dd/yy):	
measured above land surface on (mm/dd/yy):	

PERMIT & ID NUMBERS (AS REQUIRED)

DWR Application No.:	
KDHE / EPA Project Code:	
Site Name:	
KDHE UIC Class V Form Completed:	Yes No
County/Local Permit Required:	Yes No
Permit Obtained	Yes No Permit ID:
Lease Name & Well #:	
# of Bore Holes:	# of Dewatering Wells

CASING

Type of blank casing used:

Casing type details:

Blank casing diameter: _____ inches

Was casing removed? Yes No

Top of casing currently _____ ft. _____ ground

Reason required if top of casing is now less than 5 feet below ground surface for a hand dug well or less than 3 feet below ground surface for all other types of wells.

GROUT & PLUGGING MATERIALS

Grout or Plugging interval (ft.)		Material	Description
From	To		

COMMENTS

--


CONTRACTOR'S OR LANDOWNERS CERTIFICATION

This water well was plugged under my jurisdiction and was completed on (mm/dd/yyyy) _____ and this record is true to the best of my knowledge and belief. Kansas Water Well Contractor's License No. _____

This water well record was completed on (mm/dd/yyyy) _____ under the business name of _____

by (electronic signature)


Send one copy to WATER WELL OWNER and retain one for your records.

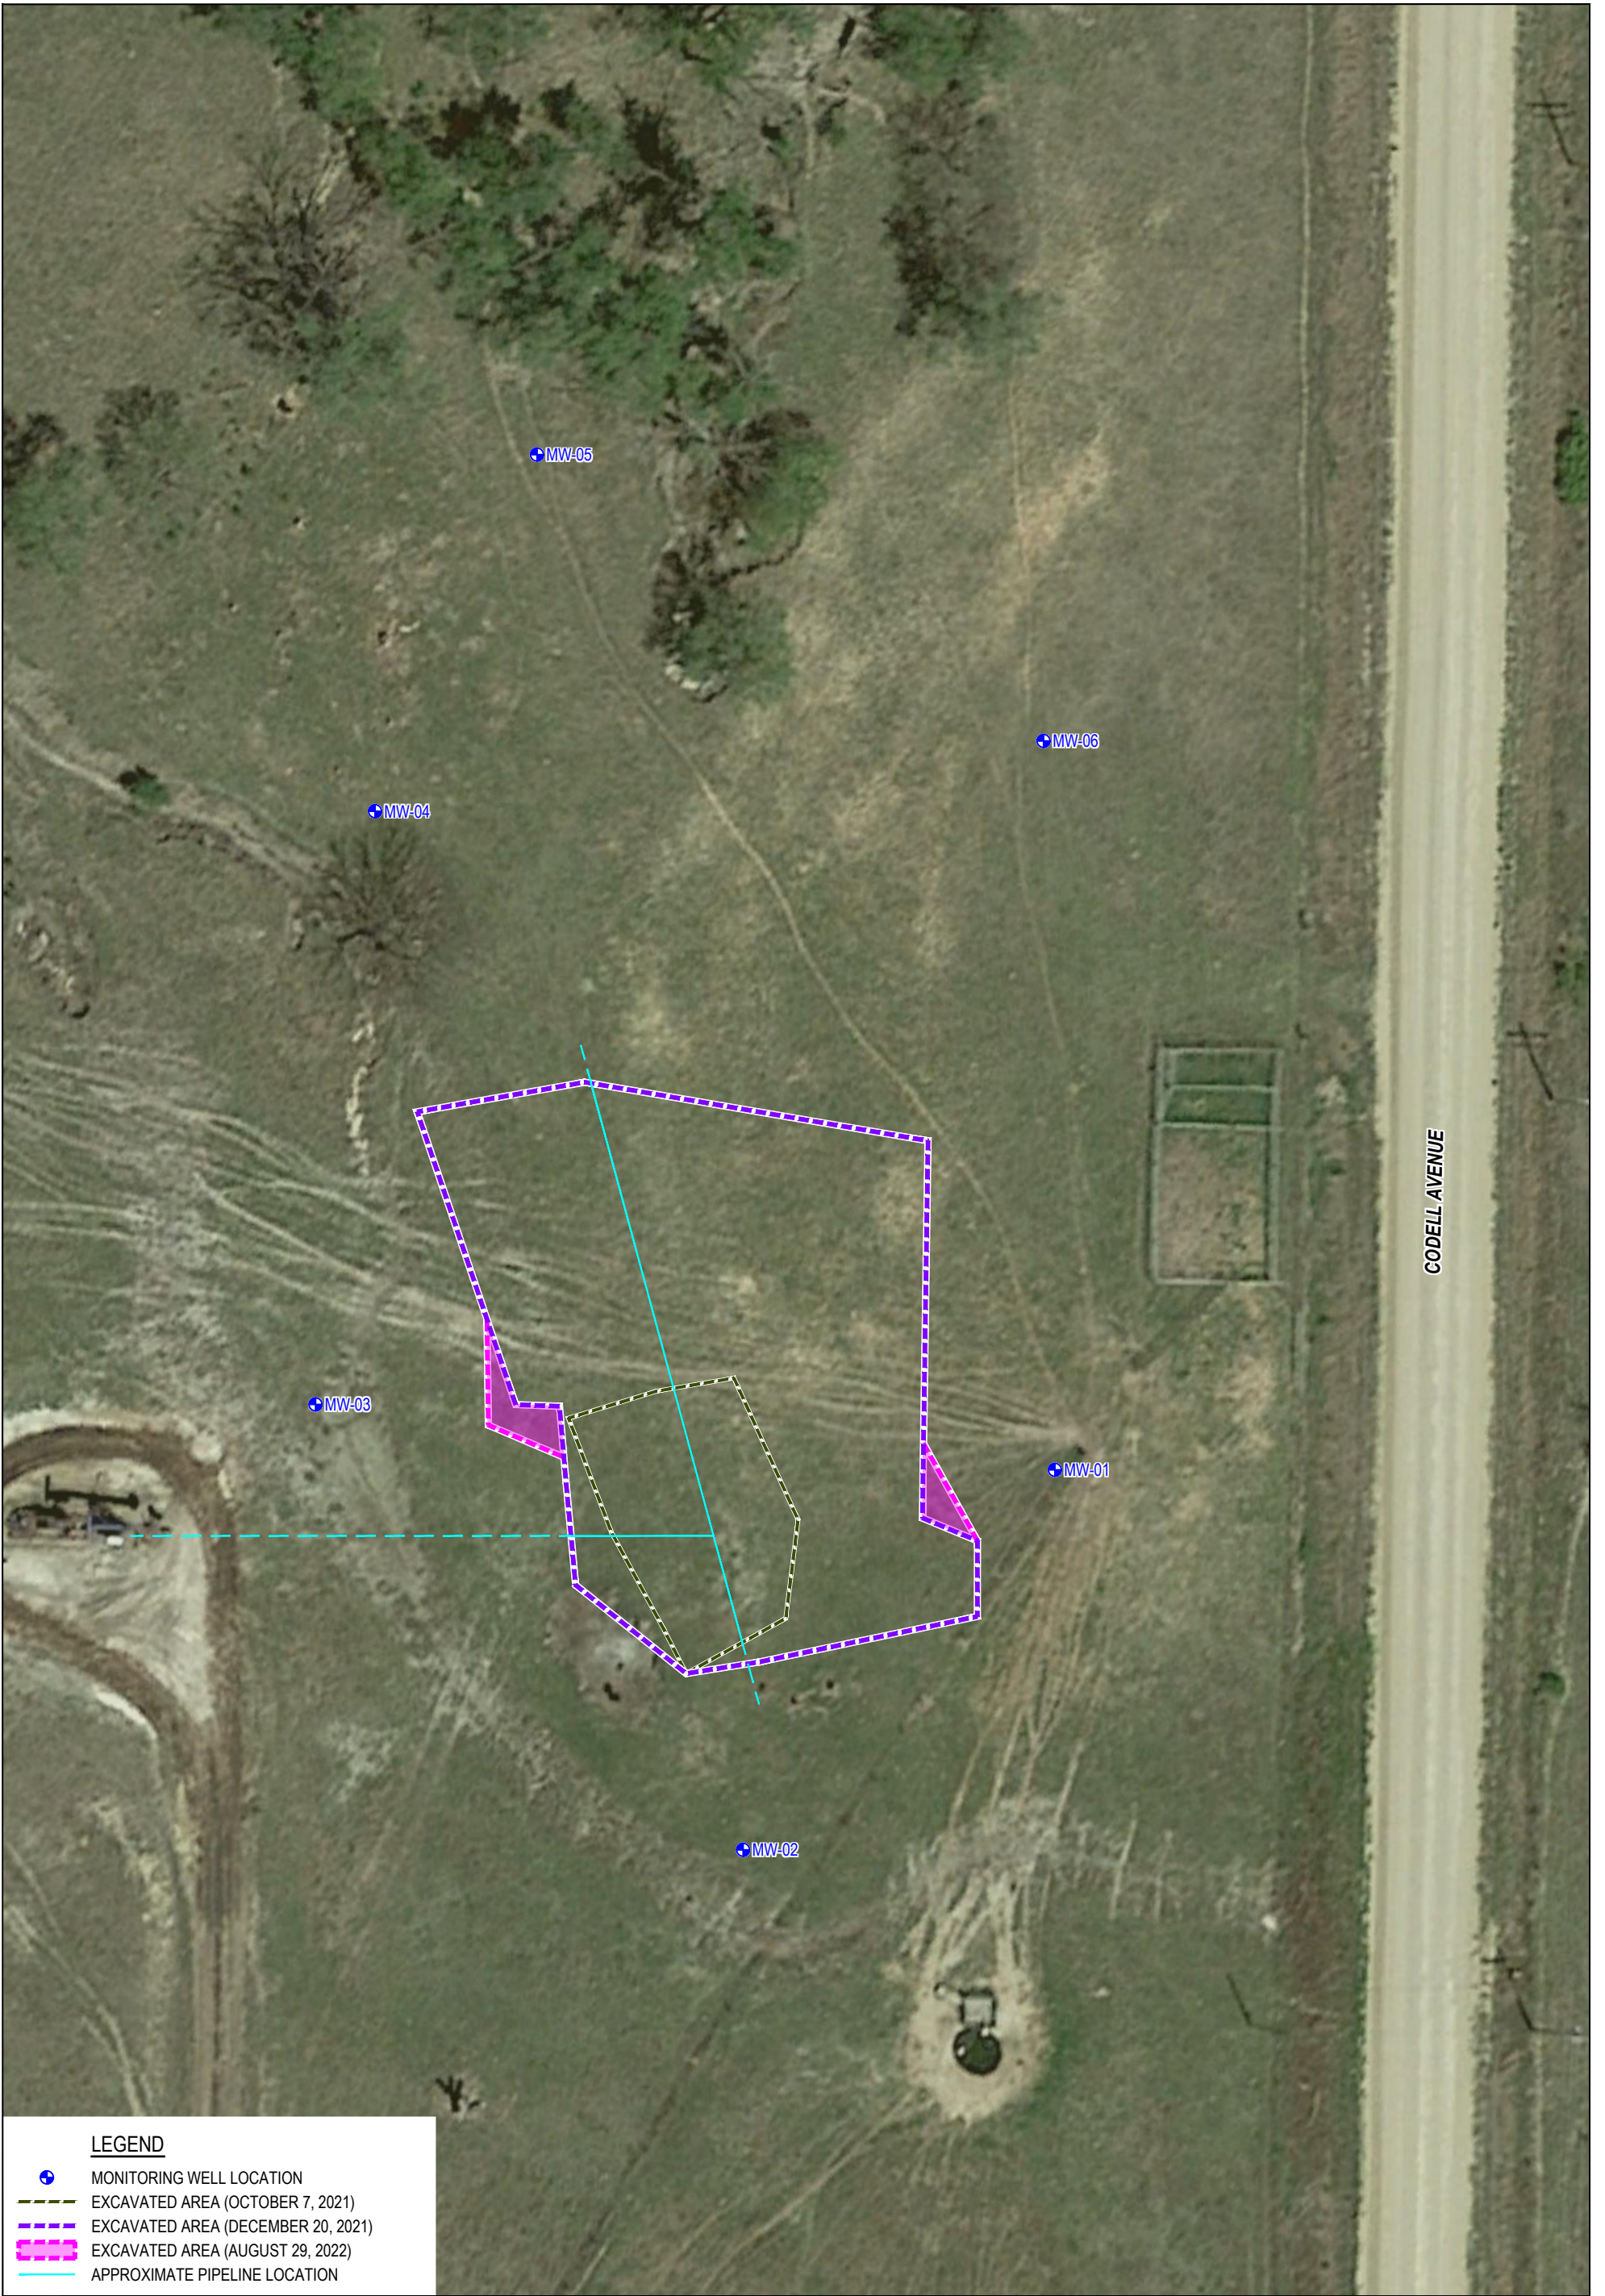

CODELL AVENUE

LEGEND

- ⊕ MONITORING WELL LOCATION
- EXCAVATED AREA (OCTOBER 7, 2021)
- EXCAVATED AREA (DECEMBER 20, 2021)
- EXCAVATED AREA (AUGUST 29, 2022)
- APPROXIMATE PIPELINE LOCATION

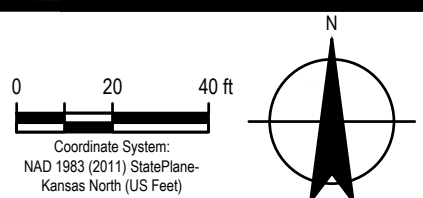

PLAINS
ELLIS COUNTY, KANSAS
PLAINS PIPELINE RELEASE

Project No. 12561410
Date December 2025

SITE MAP

FIGURE 2