

WATER WELL RECORD (WWC5.2)

Constructed

KOLAR DOC ID _____ WELL ID _____

LOCATION OF WATER WELL

County		Section		Township		Range		E W	Fraction	¼	¼	¼
Latitude		Longitude		Datum		Elevation						

WATER WELL LOCATION

at owner's address

WATER WELL OWNER

Name	
Business	
Address	

PERMIT & ID NUMBERS (AS REQUIRED)

DWR Application No.: _____

KDHE / EPA Project Code: _____

Site Name: _____

KDHE UIC Class V Form Completed: Yes No

County/Local Permit Required? Yes No

Permit Obtained? Yes No Permit ID: _____

Oil/Gas Lease Name & Well #: _____

CONSTRUCTION

Casing: Height above land surface: _____ in.

Is casing height less than 12 inches? Yes No

Blank Casing type: _____

1st interval: _____ ft. to _____ ft.; Diameter _____ in.

Casing Joint: : _____ Weight: _____ lbs/ft

Wall thickness or gauge no.: _____

2nd interval: _____ ft. to _____ ft.; Diameter _____ in.

Casing Joint: : _____ Weight: _____ lbs/ft

Wall thickness or gauge no.: _____

3rd interval: _____ ft. to _____ ft.; Diameter _____ in.

Casing Joint: : _____ Weight: _____ lbs/ft

Wall thickness or gauge no.: _____

Screen / Perforation material: _____

Specify if other: _____

Screen / Perforation openings: _____

1st interval _____ ft. to _____ ft. Slot Size _____

2nd interval _____ ft. to _____ ft. Slot Size _____

3rd interval _____ ft. to _____ ft. Slot Size _____

WELL WATER USE

Additional info if required:

of Boreholes

of Dewatering Wells

COMPLETION

Depth of completed well: _____ ft.

Depth(s) groundwater encountered: Dry Well

(1) _____ ft.; (2) _____ ft.; (3) _____ ft.;

Static water level in well: _____ ft.

Date measured: _____

Measured from: Top of Casing or Ground Surface

Measured: Above or Below Land Surface

Estimated yield: _____ gpm

Pump Test Date: Water level was:

_____ ft. after _____ hours pumping _____ gpm

_____ ft. after _____ hours pumping _____ gpm

Pump Information:

Pump Installed? Yes No Date: _____

Pump Type: Horsepower: Volts:

Drop Pipe Diameter: in. Drop Pipe Length: ft.

Water well disinfected? Yes No

Date disinfected (mm/dd/yy): _____

CONSTRUCTION**Borehole interval:**

from _____ to _____ ft.

from _____ to _____ ft.

from _____ to _____ ft..

Borehole diameter:

_____ in.

_____ in.

_____ in.

Grout:

1st Interval: _____ ft. to _____ ft. Grout material: _____

2nd Interval: _____ ft. to _____ ft. Grout material: _____

3rd Interval: _____ ft. to _____ ft. Grout material: _____

Gravel pack:

Not Used

1st Interval: _____ ft. to _____ ft. Gravel Size: _____

2nd Interval: _____ ft. to _____ ft. Gravel Size: _____

3rd Interval: _____ ft. to _____ ft. Gravel Size: _____

DESIGNATED PERSON**WELL COMPLETION DATE****CONTRACTOR BUSINESS NAME**

NOTE: Figures exhibited within this report are only to be used within the context of this report. Placement of property lines, wells, structures, and roads is based on the available information from county appraiser maps, surveys, site visits, and/or previous vendor reports and should be considered approximate.

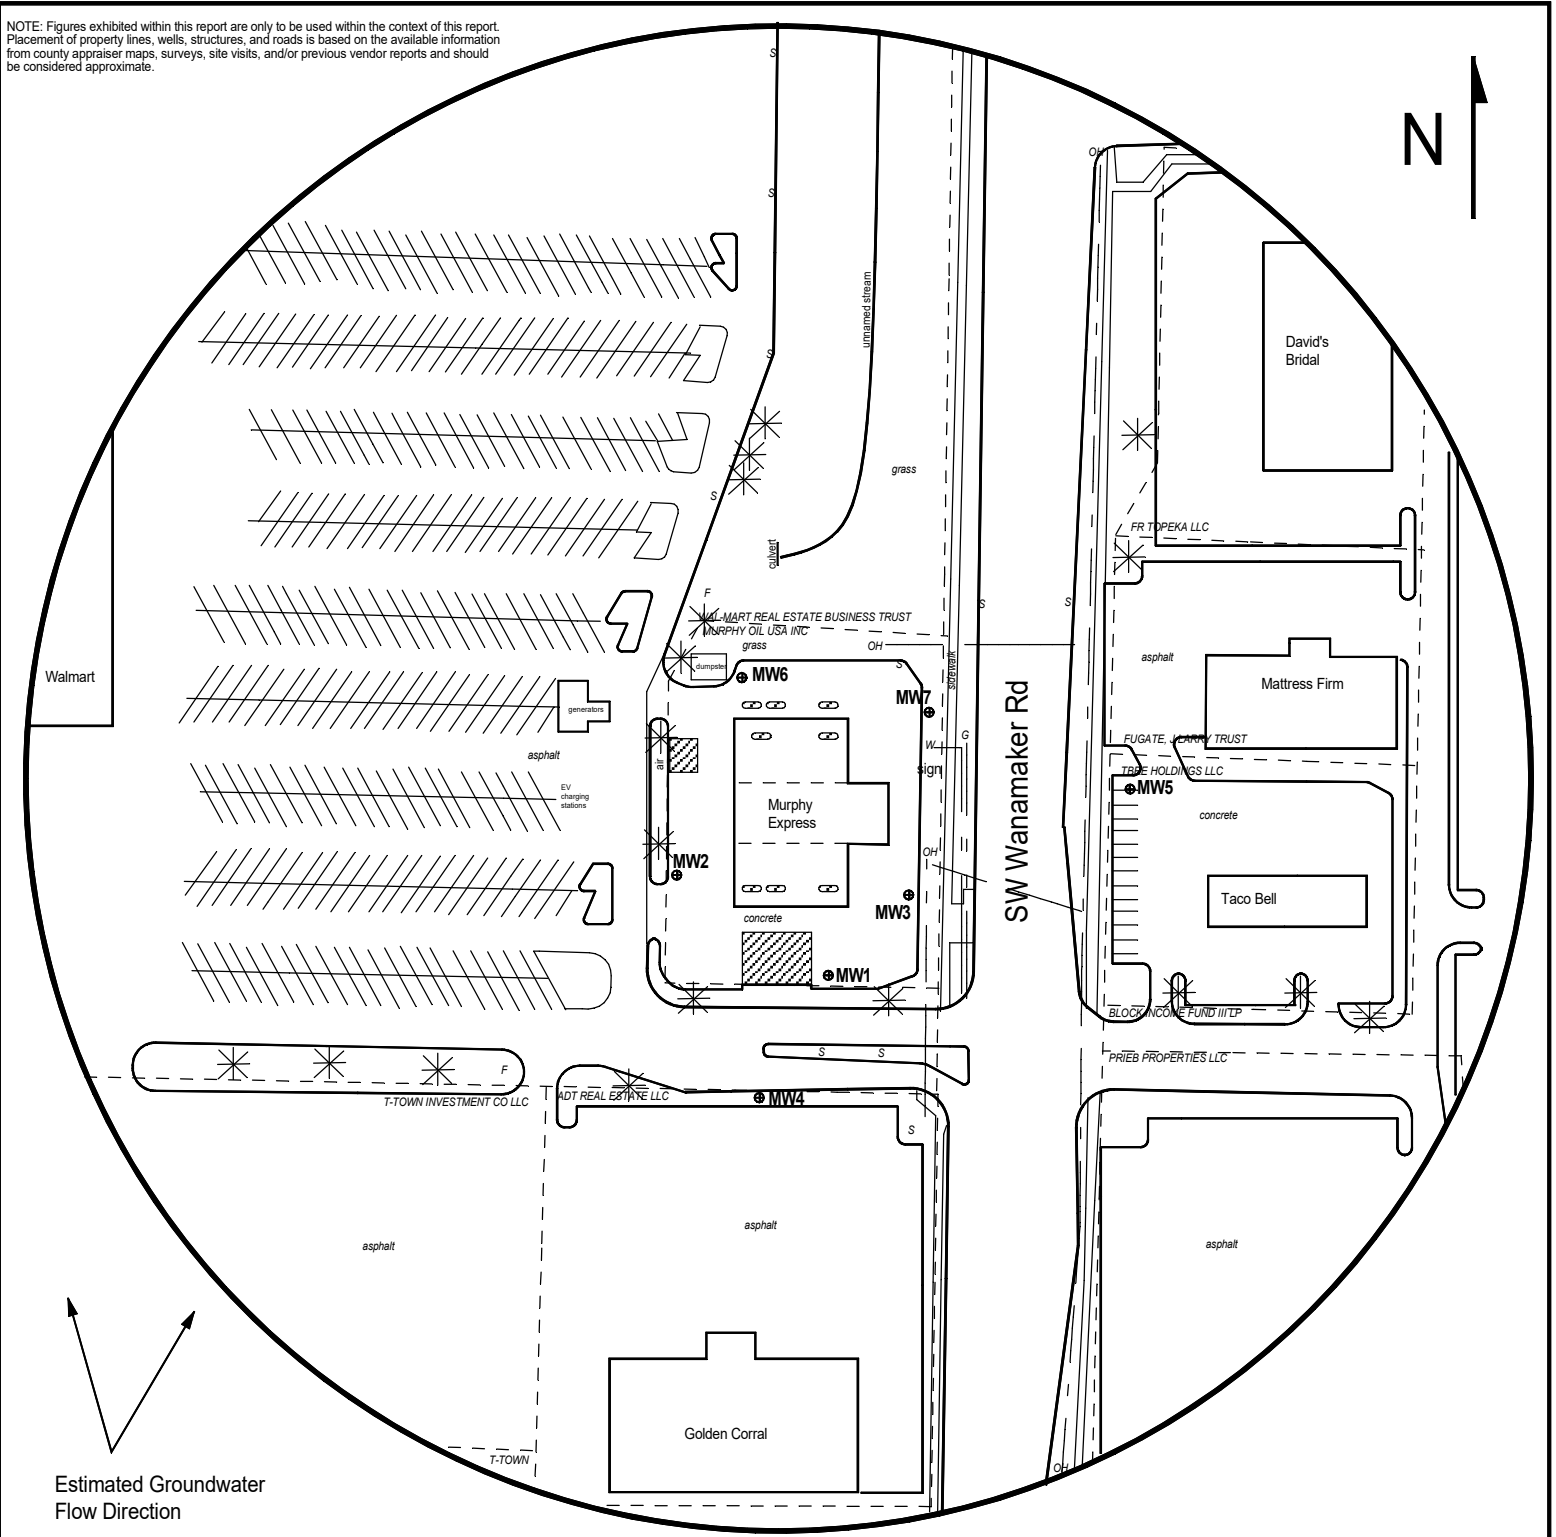


FIGURE 2.1 - 500 FT RADIUS AREA BASE MAP

LEGEND:

- Approximate Location of Active UST Basin and Pump Island
- New Monitoring Well (11/17-19/25)
- Soil Boring (Drilled 11/17,19/25)
- Overhead Lines (25-40 ft high)
- Sewer (2 - 6 ft BGS)
- Gas (2 - 6 ft BGS)
- Water (2 - 6 ft BGS)

NOTE: Utility depths, heights and locations are approximate.
NOTE: SB5 & SB6 were drilled to collect hydrologic samples.



PROJECT:

Murphy Express #8599
1531 SW Wanamaker Rd,
Topeka, KS
KDHE ID: U4-089-15582
Date: 11/20/25

0 100 feet

1311 E 25th St., Suite B, Lawrence, KS 66046
Office: (785) 841-8707

DENNIS L HANDKE

1820 NW 59th Terrace
TOPEKA, KANSAS 66618
785-286-4047 Home

Jess Chapman
Larsen & Assoc.
1311 E. 25th St., Suite B
Topeka, Kansas 66046

December 13, 2025

RE: Monitor Well Elevation Survey
1531 SW Wanamaker Rd. Topeka, Kansas

Proj. 25-00YY
Murphy Express #8599
KDHE ID U4-089-15582

Bench Mark: Chisled square on top of curbing of concrete storm inlet at the NE corner of parking lot.
Elev.: 947.72 North 3519.56 West 72.04 (from SE Cor. Sec. 5-12-15E)

MW-1	rim	948.90	North	3332.12	SE1/4,NE1/4,SE1/4,NE1/4
	top pipe	948.45	West	124.58	Lat = 39.03827 Long = 95.76232
MW-2	rim	952.79	North	3394.71	SE1/4,NE1/4,SE1/4,NE1/4
	top pipe	952.42	West	227.71	Lat = 39.03845 Long = 95.76268
MW-3	rim	948.35	North	3370.84	SE1/4,NE1/4,SE1/4,NE1/4
	top pipe	947.96	West	71.07	Lat = 39.03837 Long = 95.76213
MW-4	rim	551.24	North	3324.66	NE1/4,SE1/4,SE1/4,NE1/4
	top pipe	950.85	West	169.43	Lat = 39.03798 Long = 95.76249
MW-5	rim	948.23	North	3450.43	NW1/4,NW1/4,SW1/4,NW1/4 (Sec. 4-12-15E)
	top pipe	947.83	East	83.04	Lat = 39.03858 Long = 95.76158
MW-6	rim	950.90	North	3520.43	SE1/4,NE1/4,SE1/4,NE1/4
	top pipe	950.64	West	185.87	Lat = 39.03879 Long = 95.76252
MW-7	rim	947.69	North	3502.21	SE1/4,NE1/4,SE1/4,NE1/4
	top pipe	947.27	West	64.04	Lat = 39.03873 Long = 95.76209

Lat & Long derived from Silver Lake 7.5' quad map. WGS84.

Elevation derived from City of Topeka BM #108.2. NAVD 88.

If you have any questions, please feel free to call me. Thank you for the opportunity to be of service to you.

