

WATER WELL RECORD (WWC5.2)

Constructed

KOLAR DOC ID _____ WELL ID _____

LOCATION OF WATER WELL

County		Section		Township		Range		E W	Fraction	¼	¼	¼
Latitude		Longitude		Datum		Elevation						

WATER WELL LOCATION

at owner's address

WATER WELL OWNER

Name	
Business	
Address	

PERMIT & ID NUMBERS (AS REQUIRED)

DWR Application No.: _____
 KDHE / EPA Project Code: _____
 Site Name: _____
 KDHE UIC Class V Form Completed: Yes No
 County/Local Permit Required? Yes No
 Permit Obtained? Yes No Permit ID: _____
 Oil/Gas Lease Name & Well #: _____

CONSTRUCTION

Casing: Height above land surface: _____ in.
 Is casing height less than 12 inches? Yes No

Blank Casing type: _____
 1st interval: _____ ft. to _____ ft.; Diameter _____ in.
 Casing Joint: : _____ Weight: _____ lbs/ft
 Wall thickness or gauge no.: _____
 2nd interval: _____ ft. to _____ ft.; Diameter _____ in.
 Casing Joint: : _____ Weight: _____ lbs/ft
 Wall thickness or gauge no.: _____
 3rd interval: _____ ft. to _____ ft.; Diameter _____ in.
 Casing Joint: : _____ Weight: _____ lbs/ft
 Wall thickness or gauge no.: _____

Screen / Perforation material: _____

Specify if other: _____

Screen / Perforation openings: _____

1st interval _____ ft. to _____ ft. Slot Size _____

2nd interval _____ ft. to _____ ft. Slot Size _____

3rd interval _____ ft. to _____ ft. Slot Size _____

WELL WATER USE

Additional info if required:

of Boreholes

of Dewatering Wells

COMPLETION

Depth of completed well: _____ ft.

Depth(s) groundwater encountered: Dry Well

(1) _____ ft.; (2) _____ ft.; (3) _____ ft.;

Static water level in well: _____ ft.

Date measured: _____

Measured from: Top of Casing or Ground Surface

Measured: Above or Below Land Surface

Estimated yield: _____ gpm

Pump Test Date: Water level was:

_____ ft. after _____ hours pumping _____ gpm

_____ ft. after _____ hours pumping _____ gpm

Pump Information:

Pump Installed? Yes No Date: _____

Pump Type: Horsepower: Volts:

Drop Pipe Diameter: in. Drop Pipe Length: ft.

Water well disinfected? Yes No

Date disinfected (mm/dd/yy): _____

CONSTRUCTION**Borehole interval:**

from _____ to _____ ft.

from _____ to _____ ft.

from _____ to _____ ft..

Borehole diameter:

_____ in.

_____ in.

_____ in.

Grout:

1st Interval: _____ ft. to _____ ft. Grout material: _____

2nd Interval: _____ ft. to _____ ft. Grout material: _____

3rd Interval: _____ ft. to _____ ft. Grout material: _____

Gravel pack:

Not Used

1st Interval: _____ ft. to _____ ft. Gravel Size: _____

2nd Interval: _____ ft. to _____ ft. Gravel Size: _____

3rd Interval: _____ ft. to _____ ft. Gravel Size: _____

DESIGNATED PERSON**WELL COMPLETION DATE****CONTRACTOR BUSINESS NAME**

NOTE: Figures exhibited within this report are only to be used within the context of this report. Placement of property lines, wells, structures, and roads is based on the available information from county appraiser maps, surveys, site visits, and/or previous vendor reports and should be considered approximate.

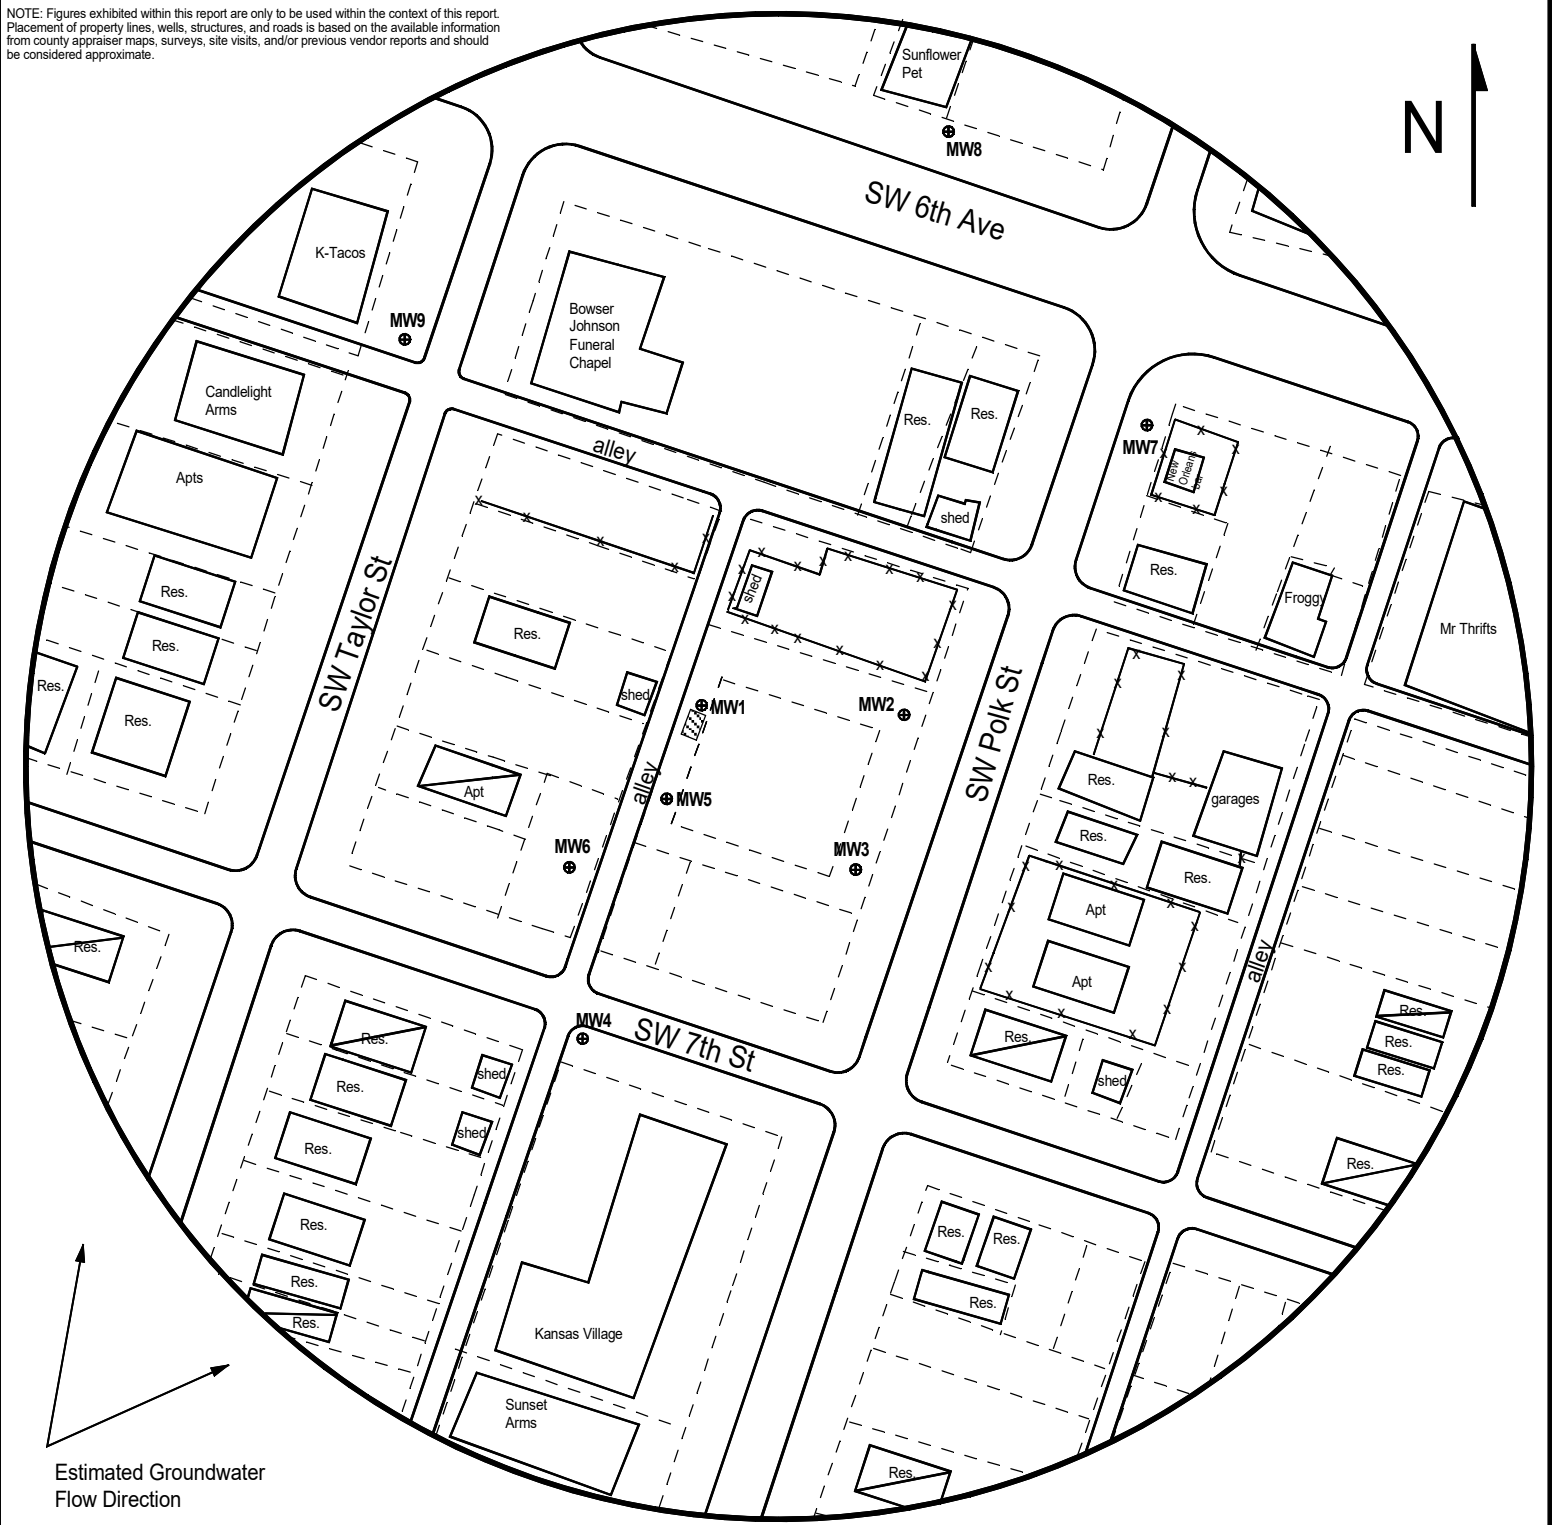


FIGURE 2 - 500 FT RADIUS AREA BASE MAP

LEGEND:

- Former UST Basin
- Building with Basement
- Proposed Monitoring Well
- Proposed Soil Boring
- Fire Hydrant
- Tree/Bush
- Overhead Lines (25-40 ft high)
- Sewer (2 - 6 ft BGS)
- Gas (2 - 6 ft BGS)
- Telephone (2 - 6 ft BGS)

NOTE: Utility depths and locations are approximate.
NOTE: SB5 & SB6 will be drilled to collect hydrologic samples.



PROJECT:

625 SW Polk Street
625 SW Polk Street,
Topeka, KS
KDHE ID: U4-089-15650
Date: 1/2/25

0 100 feet

A scale bar with markings at 0 and 100 feet.

1311 E 25th St., Suite B, Lawrence, KS 66046
Office: (785) 841-8707

DENNIS L HANDKE

1820 NW 59th Terrace
TOPEKA, KANSAS 66618
785-286-4047 Home

Jess Chapman
Larsen & Associates
1311 E. 25th Street, Suite B
Lawrence, Kansas 66046

December 12, 2025

RE: Monitor Well Elevation Survey
625 SW Polk St., Topeka, Kansas

Proj. 25-00XX
625 SW Polk
KDHE ID U4-089-15650

Bench Mark: Chisled "X" on Westerly top bolt of fire hydrant near the SE corner of property.

Elev: 924.81 North 3030.39 West 3754.11 (from SE Cor. Sec. 31-11-16E)

MW-1	rim	928.67	North	3261.32	NE1/4,SE1/4,SW1/4,NW1/4
	top pipe	928.20	West	3851.32	Lat = 39.05322 Long = 95.68290
MW-2	rim	923.85	North	3235.49	NW1/4,SW1/4,SE1/4,NW1/4
	top pipe	923.21	West	3748.23	Lat = 39.05315 Long = 95.68253
MW-3	rim	925.79	North	3160.77	NE1/4,SW1/4,SE1/4,NW1/4
	top pipe	925.51	West	3774.20	Lat = 39.05294 Long = 95.68262
MW-4	rim	925.73	North	3037.58	NE1/4,SE1/4,SW1/4,NW1/4
	top pipe	925.08	West	3924.51	Lat = 39.05261 Long = 95.68316
MW-5	rim	928.93	North	3196.88	NE1/4,SE1/4,SW1/4,NW1/4
	top pipe	928.41	West	3859.36	Lat = 39.05304 Long = 95.68291
MW-6	rim	928.13	North	3153.77	NE1/4,SE1/4,SW1/4,NW1/4
	top pipe	927.70	West	3930.93	Lat = 39.05293 Long = 95.68318
MW-7	rim	916.62	North	3426.95	SE1/4,NW1/4,SE1/4,NW1/4
	top pipe	916.33	West	3560.52	Lat = 39.05367 Long = 95.68187
MW-8	rim	918.39	North	3622.26	NW1/4,NW1/4,SE1/4,NW1/4
	top pipe	917.95	West	3678.30	Lat = 39.05421 Long = 95.68228
MW-9	rim	924.43	North	3487.92	SE1/4,NE1/4,SW1/4,NW1/4
	top pipe	923.96	West	4043.94	Lat = 39.05384 Long = 95.69357

Elevation derived from City of Topeka BM 192. NAVD 88

Lat & Long derived from Topeka 7.5 Quad Map WGS84

If you have any questions, please feel free to call me. Thank you for the opportunity to be

of services to you

Dennis L Handke RLS
LS-786

