

WATER WELL RECORD (WWC-5)

Plugged

KOLAR DOC ID _____ WELL ID _____

LOCATION OF WATER WELL

County		Section		Township		Range	E W	Fraction	¼	¼	¼
Latitude		Longitude		Datum		Elevation					

WATER WELL OWNER

Name	
Business	
Address	
Well location at owner's address	

WELL WATER USE

--

WELL INFORMATION

Depth of well:	ft.
Dry well	
Static water level in well:	ft.
measured below land surface on (mm/dd/yy):	
measured above land surface on (mm/dd/yy):	

PERMIT & ID NUMBERS (AS REQUIRED)

DWR Application No.:	
KDHE / EPA Project Code:	
Site Name:	
KDHE UIC Class V Form Completed:	Yes No
County/Local Permit Required:	Yes No
Permit Obtained	Yes No Permit ID:
Lease Name & Well #:	
# of Bore Holes:	# of Dewatering Wells

CASING

Type of blank casing used:		
Casing type details:		
Blank casing diameter:	inches	
Was casing removed?	Yes No	
Top of casing currently	ft.	ground
Reason required if top of casing is now less than 5 feet below ground surface for a hand dug well or less than 3 feet below ground surface for all other types of wells.		

GROUT & PLUGGING MATERIALS

Grout or Plugging interval (ft.)		Material	Description
From	To		

COMMENTS

--

CONTRACTOR'S OR LANDOWNERS CERTIFICATION

This water well was plugged under my jurisdiction and was completed on (mm/dd/yyyy) _____ my knowledge and belief. Kansas Water Well Contractor's License No. _____ This water well record was completed on (mm/dd/yyyy) _____ under the business name of _____ by (electronic signature) _____	and this record is true to the best of .
--	---

Send one copy to WATER WELL OWNER and retain one for your records.

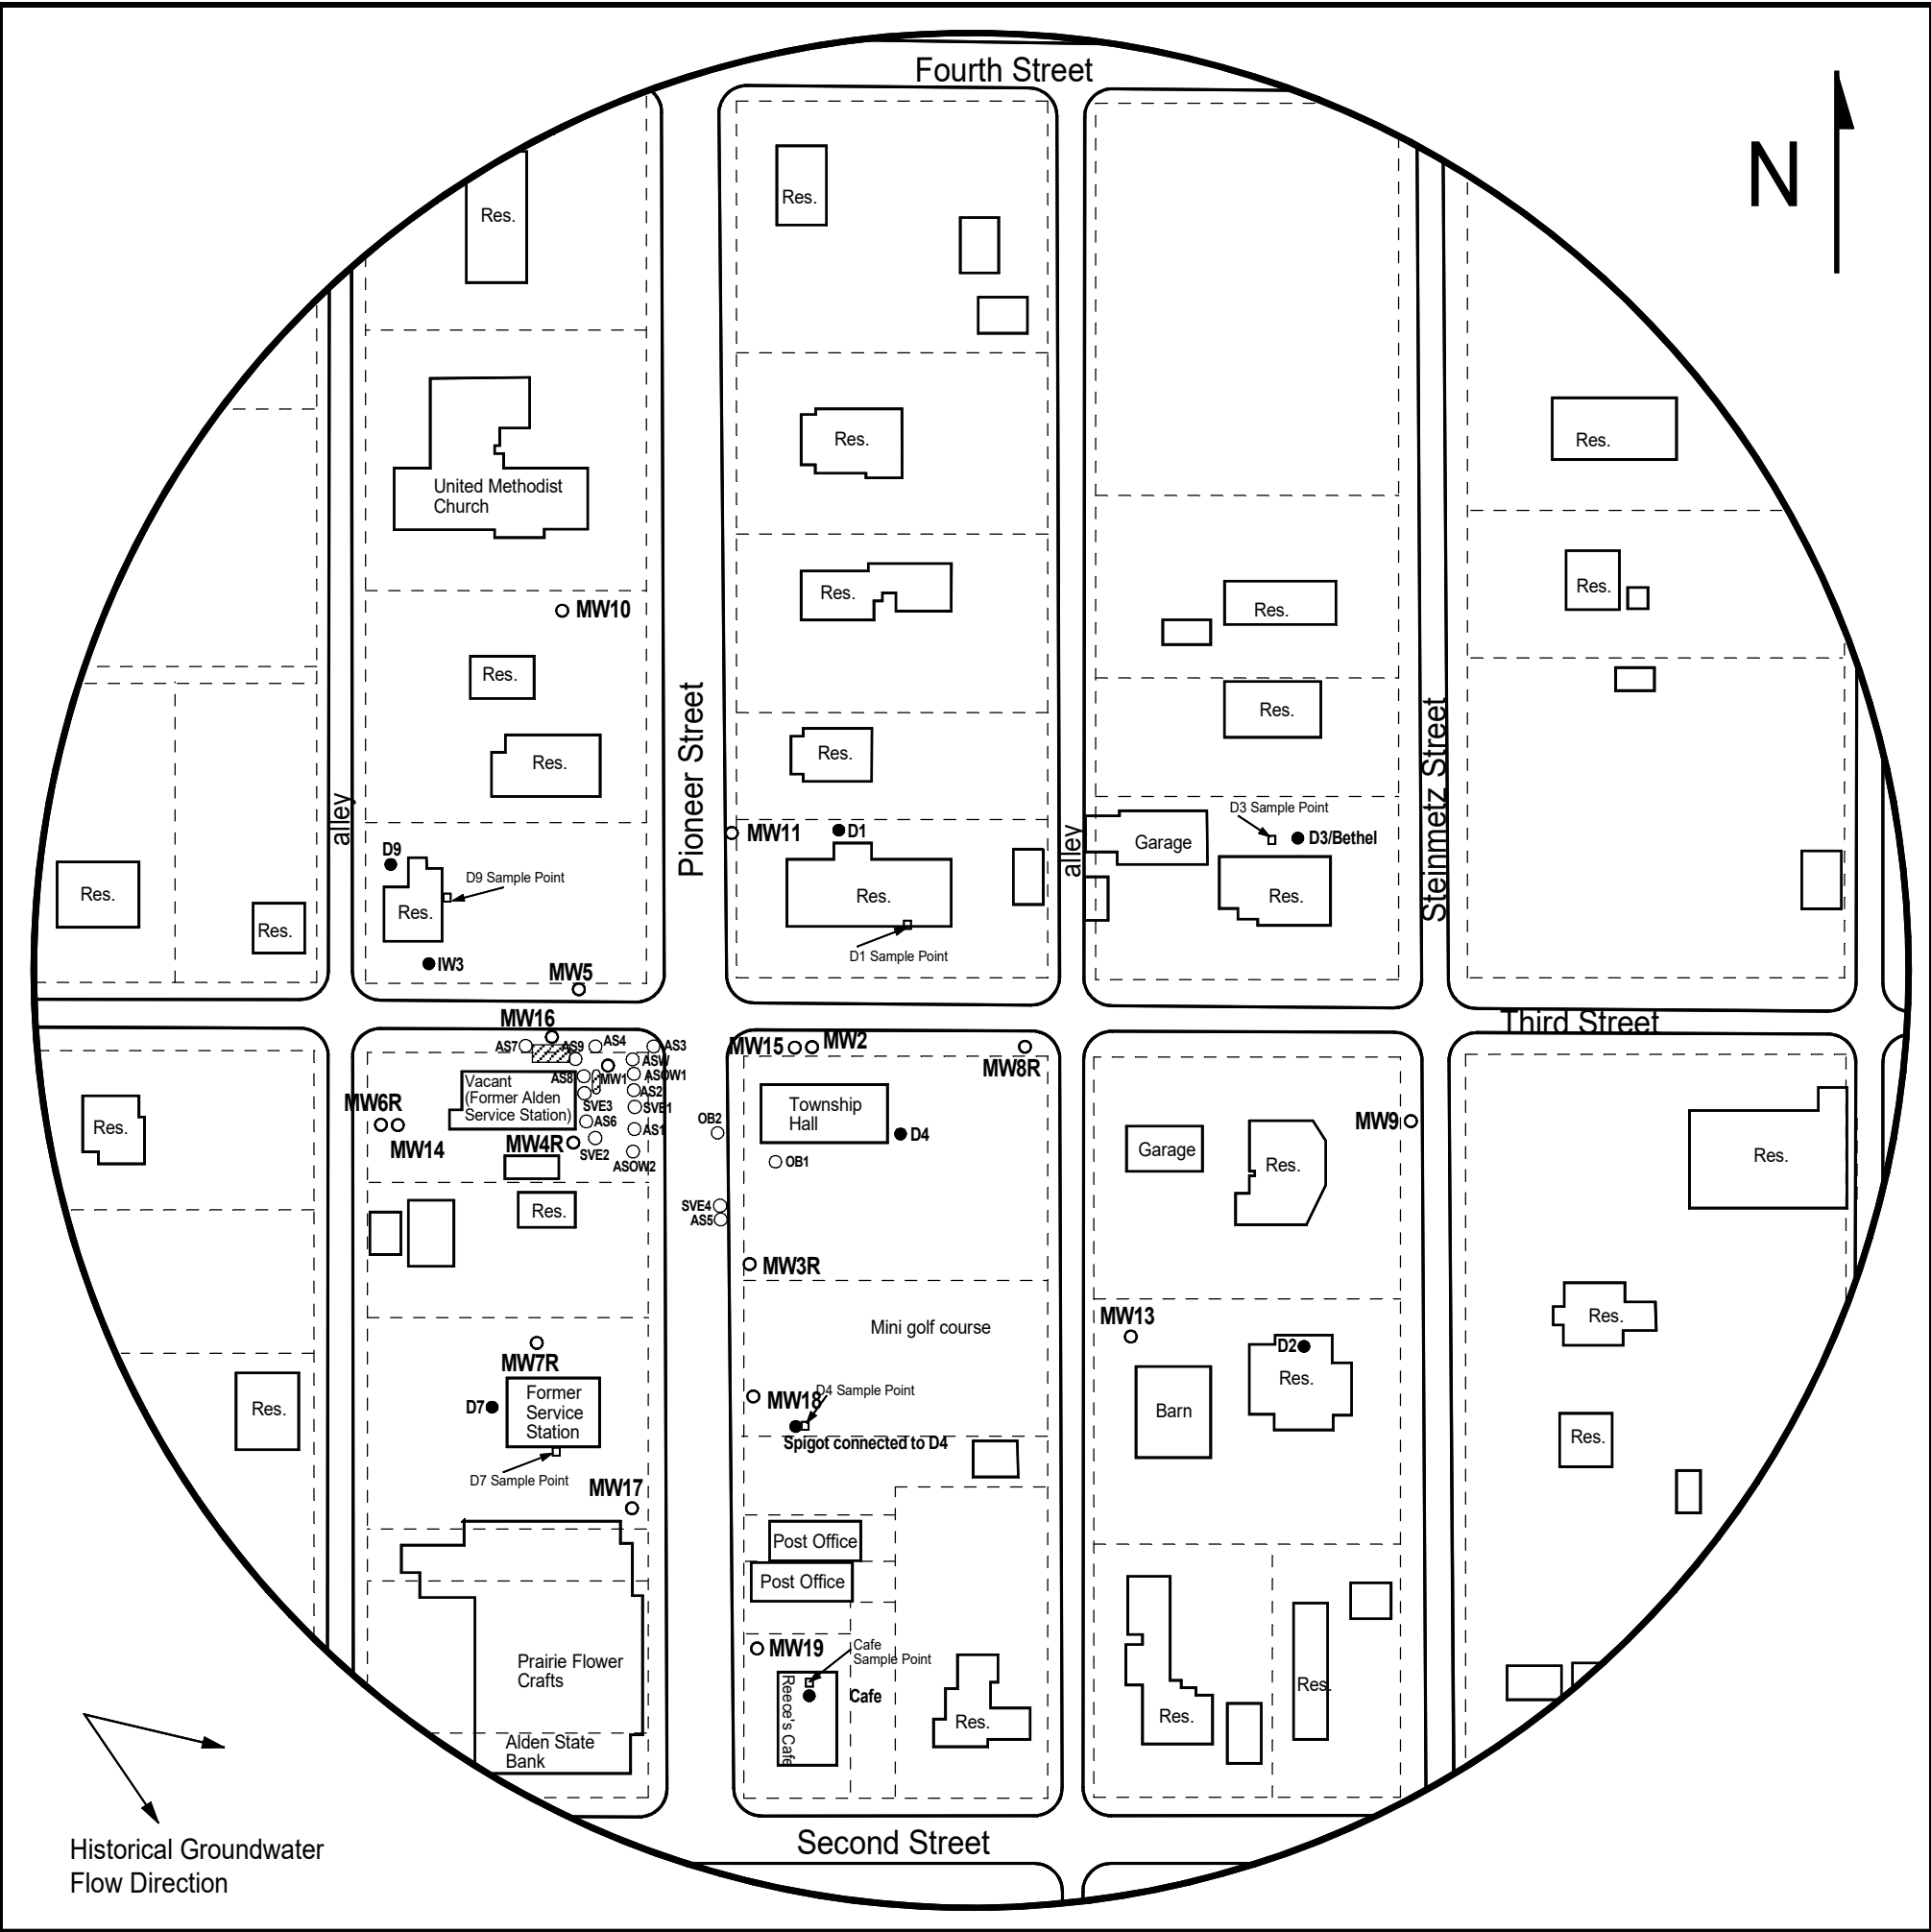


FIGURE 1 - 500 FT RADIUS AREA BASE MAP



larsen
& ASSOCIATES, INC.

1311 E 25th St., Suite B
Lawrence, KS 66046

(785) 841-8707 office
(785) 865-4282 fax

PROJECT:
Alden Service Station
213 N. Pioneer
Alden, KS
KDHE ID: U5-080-00291
Date: 12/8-9/25



- LEGEND**
- Approximate Location of Former UST Basin and Pump Island
 - Plugged Monitoring Well
 - SVE Well
 - Air Sparge Well
 - Domestic Well
 - Domestic Well Sample Collection Point (Faucet)
 - Observation Well
 - Approximate Location of Property Line