

**WATER WELL RECORD (WWC-5)**

Plugged

KOLAR DOC ID \_\_\_\_\_ WELL ID \_\_\_\_\_

**LOCATION OF WATER WELL**

|          |  |           |  |          |  |           |        |          |   |   |   |
|----------|--|-----------|--|----------|--|-----------|--------|----------|---|---|---|
| County   |  | Section   |  | Township |  | Range     | E<br>W | Fraction | ¼ | ¼ | ¼ |
| Latitude |  | Longitude |  | Datum    |  | Elevation |        |          |   |   |   |

**WATER WELL OWNER**

|                                     |  |
|-------------------------------------|--|
| Name                                |  |
| Business                            |  |
| Address                             |  |
| Well location<br>at owner's address |  |

**WELL WATER USE**

|  |
|--|
|  |
|--|

**WELL INFORMATION**

|                                            |     |
|--------------------------------------------|-----|
| Depth of well:                             | ft. |
| Dry well                                   |     |
| Static water level in well:                | ft. |
| measured below land surface on (mm/dd/yy): |     |
| measured above land surface on (mm/dd/yy): |     |

**PERMIT & ID NUMBERS (AS REQUIRED)**

|                                  |                       |
|----------------------------------|-----------------------|
| DWR Application No.:             |                       |
| KDHE / EPA Project Code:         |                       |
| Site Name:                       |                       |
| KDHE UIC Class V Form Completed: | Yes No                |
| County/Local Permit Required:    | Yes No                |
| Permit Obtained                  | Yes No Permit ID:     |
| Lease Name & Well #:             |                       |
| # of Bore Holes:                 | # of Dewatering Wells |

**CASING**

|   |            |
|---|------------|
| Type of blank casing used:   |            |
| Casing type details:   |            |
| Blank casing diameter:   | inches     |
| Was casing removed?   | Yes No     |
| Top of casing currently   | ft. ground |
| Reason required if top of casing is now less than 5 feet below ground surface for a hand dug well or less than 3 feet below ground surface for all other types of wells. |            |

**GROUT & PLUGGING MATERIALS**

| Grout or Plugging interval (ft.) |    | Material | Description |
|----------------------------------|----|----------|-------------|
| From                             | To |          |             |
|                                  |    |          |             |
|                                  |    |          |             |
**COMMENTS**

|  |
|--|
|  |
|--|

**CONTRACTOR'S OR LANDOWNERS CERTIFICATION**

|   |
|---|
| This water well was plugged under my jurisdiction and was completed on (mm/dd/yyyy) _____<br>and this record is true to the best of my knowledge and belief. Kansas Water Well Contractor's License No. _____<br><br>This water well record was completed on (mm/dd/yyyy) _____ under the business name of _____<br>by (electronic signature) _____ |
|---|

Send one copy to WATER WELL OWNER and retain one for your records.

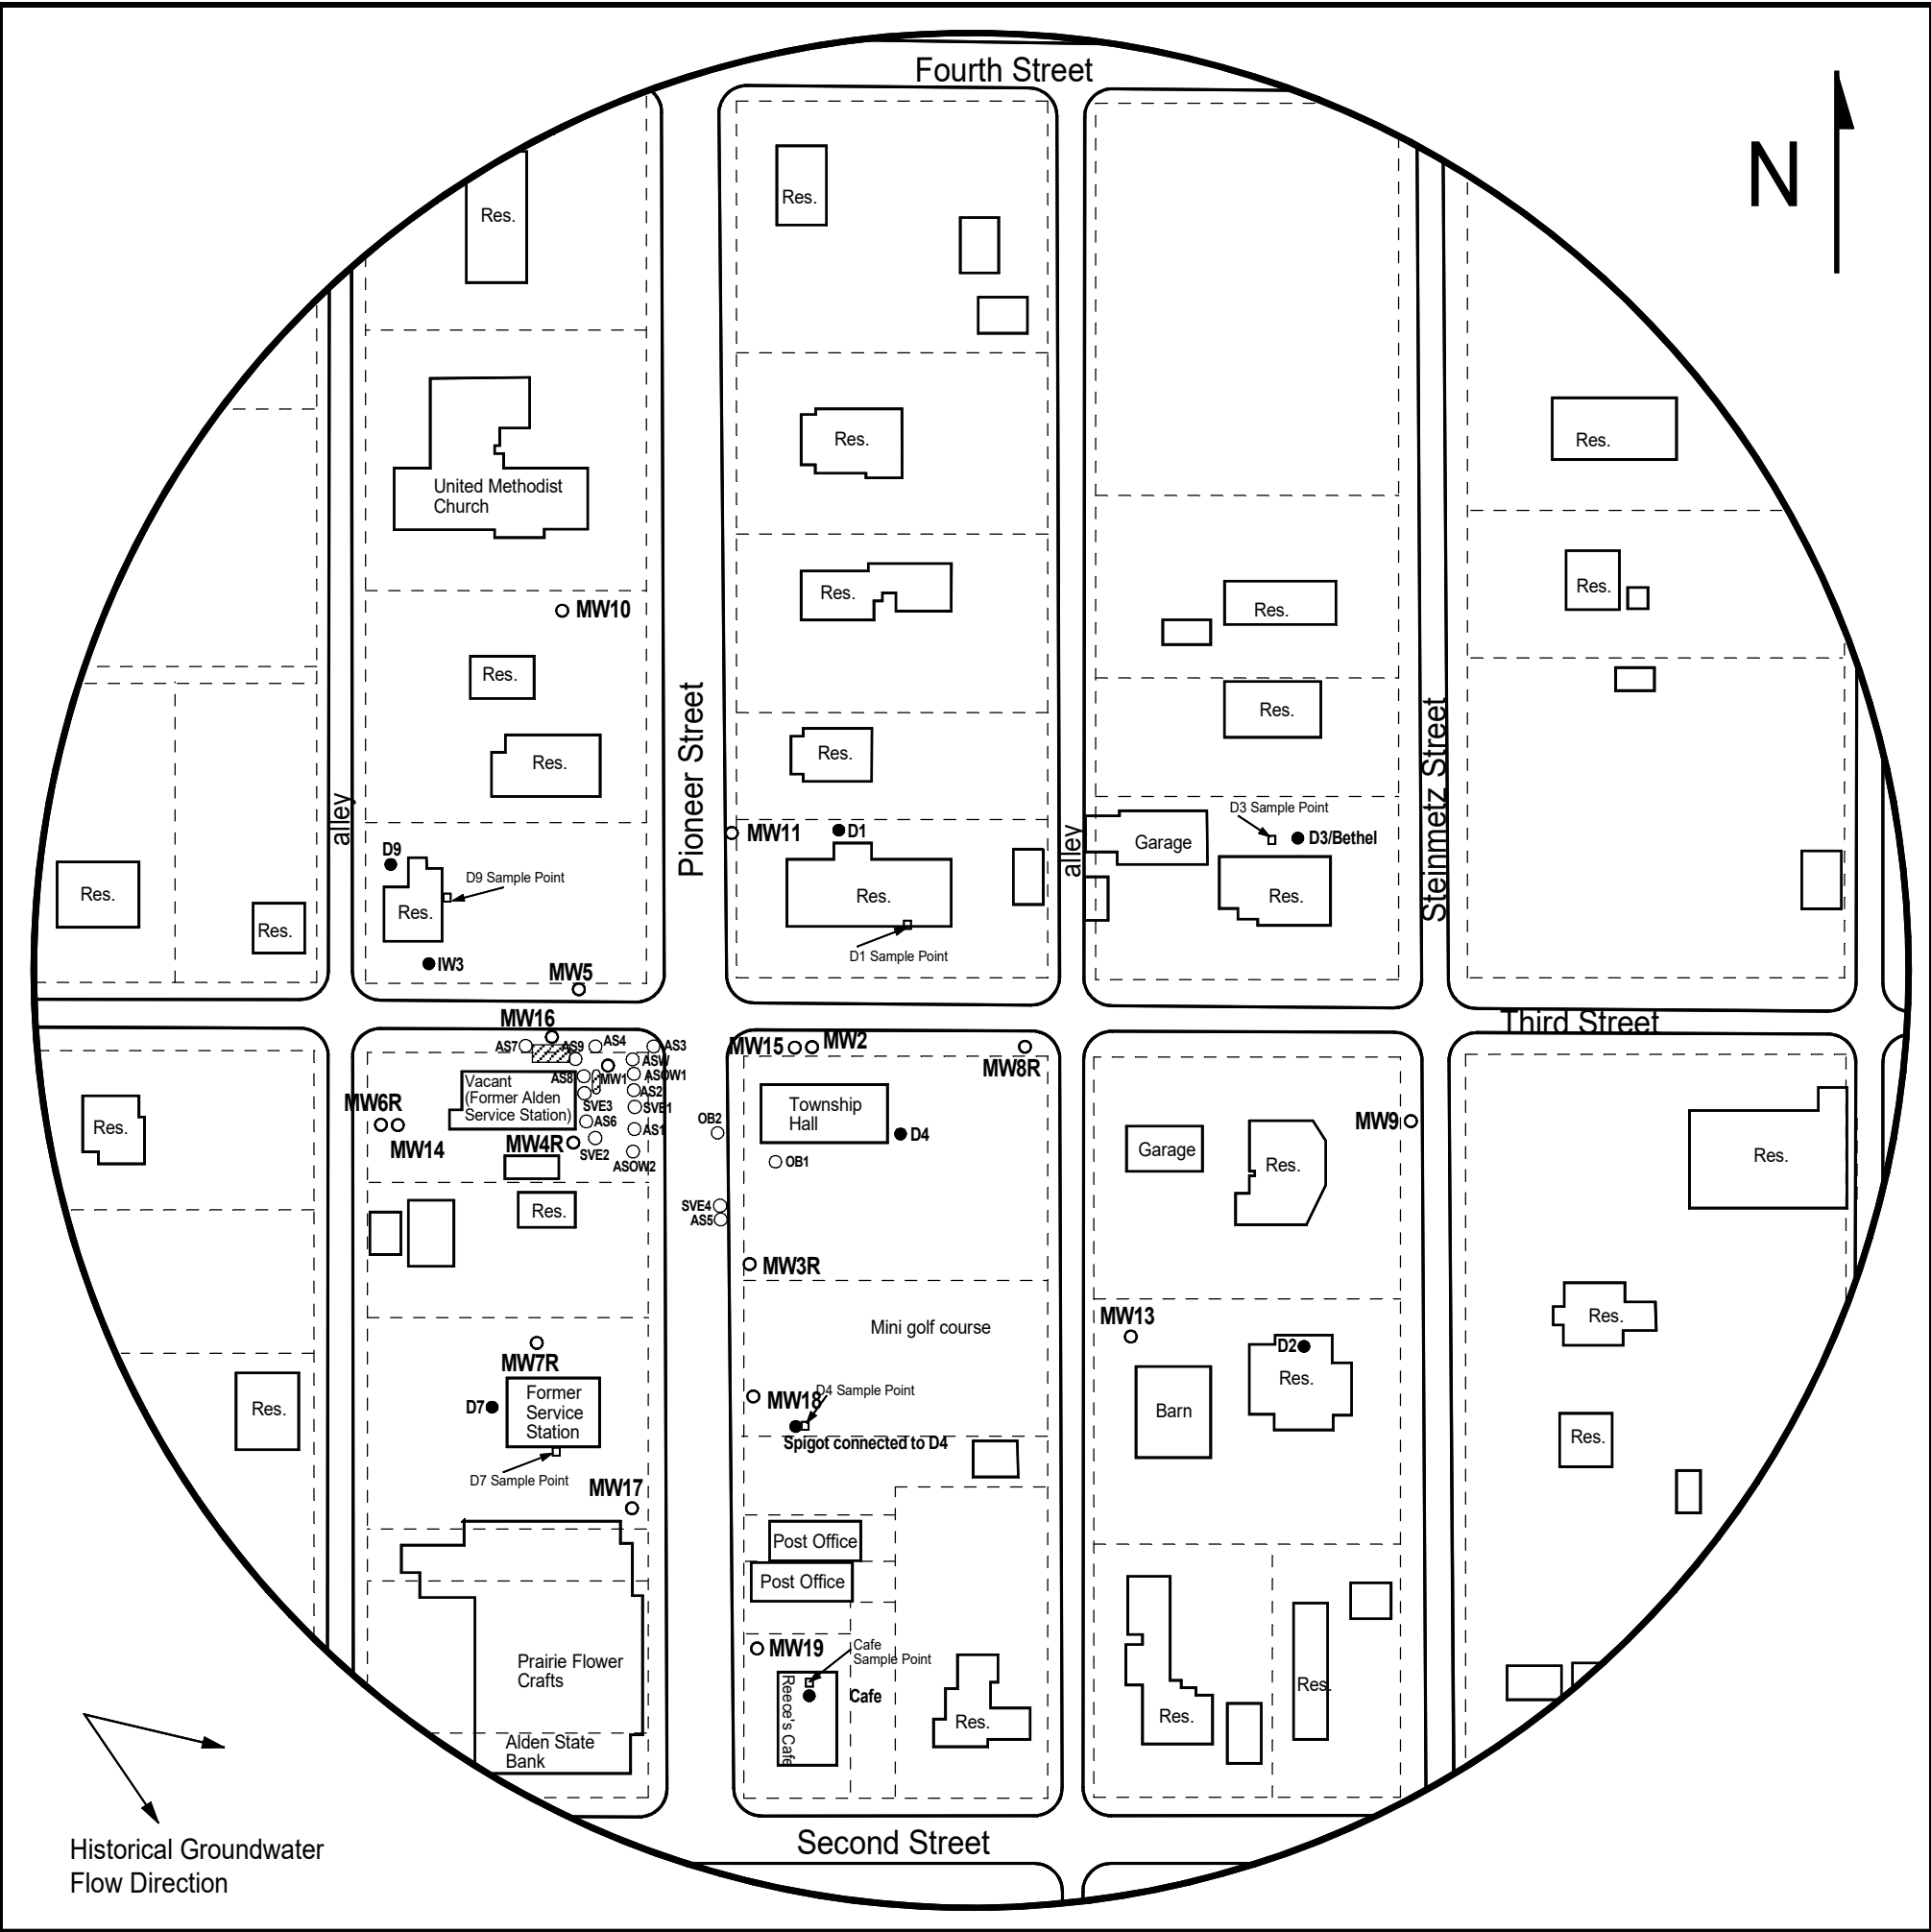


FIGURE 1 - 500 FT RADIUS AREA BASE MAP



**PROJECT:**  
Alden Service Station  
213 N. Pioneer  
Alden, KS  
KDHE ID: U5-080-00291  
Date: 12/8-9/25



- LEGEND**
- Approximate Location of Former UST Basin and Pump Island
  - Plugged Monitoring Well
  - SVE Well
  - Air Sparge Well
  - Domestic Well
  - Domestic Well Sample Collection Point (Faucet)
  - Observation Well
  - Approximate Location of Property Line

1311 E 25th St., Suite B  
Lawrence, KS 66046

(785) 841-8707 office  
(785) 865-4282 fax