

WATER WELL RECORD (WWC5.2)

Constructed

KOLAR DOC ID _____ WELL ID _____

LOCATION OF WATER WELL

County	Section	Township	Range	^E / _W Fraction	¼	¼	¼
Latitude	Longitude	Datum	Elevation				

WATER WELL LOCATION _____ at owner's address

WATER WELL OWNER

Name	
Business	
Address	

PERMIT & ID NUMBERS (AS REQUIRED)

DWR Application No.: _____
 KDHE / EPA Project Code: _____
 Site Name: _____
 KDHE UIC Class V Form Completed: Yes No
 County/Local Permit Required? Yes No
 Permit Obtained? Yes No Permit ID: _____
 Oil/Gas Lease Name & Well #: _____

CONSTRUCTION

Casing: Height above land surface: _____ in.
 Is casing height less than 12 inches? Yes No

Blank Casing type: _____
 1st interval: _____ ft. to _____ ft.; Diameter _____ in.
 Casing Joint: : _____ Weight: _____ lbs/ft
 Wall thickness or gauge no.: _____
 2nd interval: _____ ft. to _____ ft.; Diameter _____ in.
 Casing Joint: : _____ Weight: _____ lbs/ft
 Wall thickness or gauge no.: _____
 3rd interval: _____ ft. to _____ ft.; Diameter _____ in.
 Casing Joint: : _____ Weight: _____ lbs/ft
 Wall thickness or gauge no.: _____

Screen / Perforation material: _____
 Specify if other: _____
 Screen / Perforation openings: _____
 1st interval _____ ft. to _____ ft. Slot Size _____
 2nd interval _____ ft. to _____ ft. Slot Size _____
 3rd interval _____ ft. to _____ ft. Slot Size _____

DESIGNATED PERSON

CONTRACTOR BUSINESS NAME

WELL WATER USE

Additional info if required:
 # of Boreholes _____ # of Dewatering Wells _____

COMPLETION

Depth of completed well: _____ ft.
 Depth(s) groundwater encountered: Dry Well
 (1) _____ ft.; (2) _____ ft.; (3) _____ ft.;
 Static water level in well: _____ ft.
 Date measured: _____
 Measured from: Top of Casing or Ground Surface
 Measured: Above or Below Land Surface

Estimated yield: _____ gpm
 Pump Test Date: Water level was:
 _____ ft. after _____ hours pumping _____ gpm
 _____ ft. after _____ hours pumping _____ gpm

Pump Information:

Pump Installed? Yes No Date: _____
 Pump Type: _____ Horsepower: _____ Volts: _____
 Drop Pipe Diameter: _____ in. Drop Pipe Length: _____ ft.
 Water well disinfected? Yes No
 Date disinfected (mm/dd/yy): _____

CONSTRUCTION

Borehole interval: from _____ to _____ ft. from _____ to _____ ft. from _____ to _____ ft..	Borehole diameter: _____ in. _____ in. _____ in.
---	--


Grout:

1st Interval: _____ ft. to _____ ft. Grout material: _____
 2nd Interval: _____ ft. to _____ ft. Grout material: _____
 3rd Interval: _____ ft. to _____ ft. Grout material: _____

Gravel pack: _____ Not Used

1st Interval: _____ ft. to _____ ft. Gravel Size: _____
 2nd Interval: _____ ft. to _____ ft. Gravel Size: _____
 3rd Interval: _____ ft. to _____ ft. Gravel Size: _____

WELL COMPLETION DATE

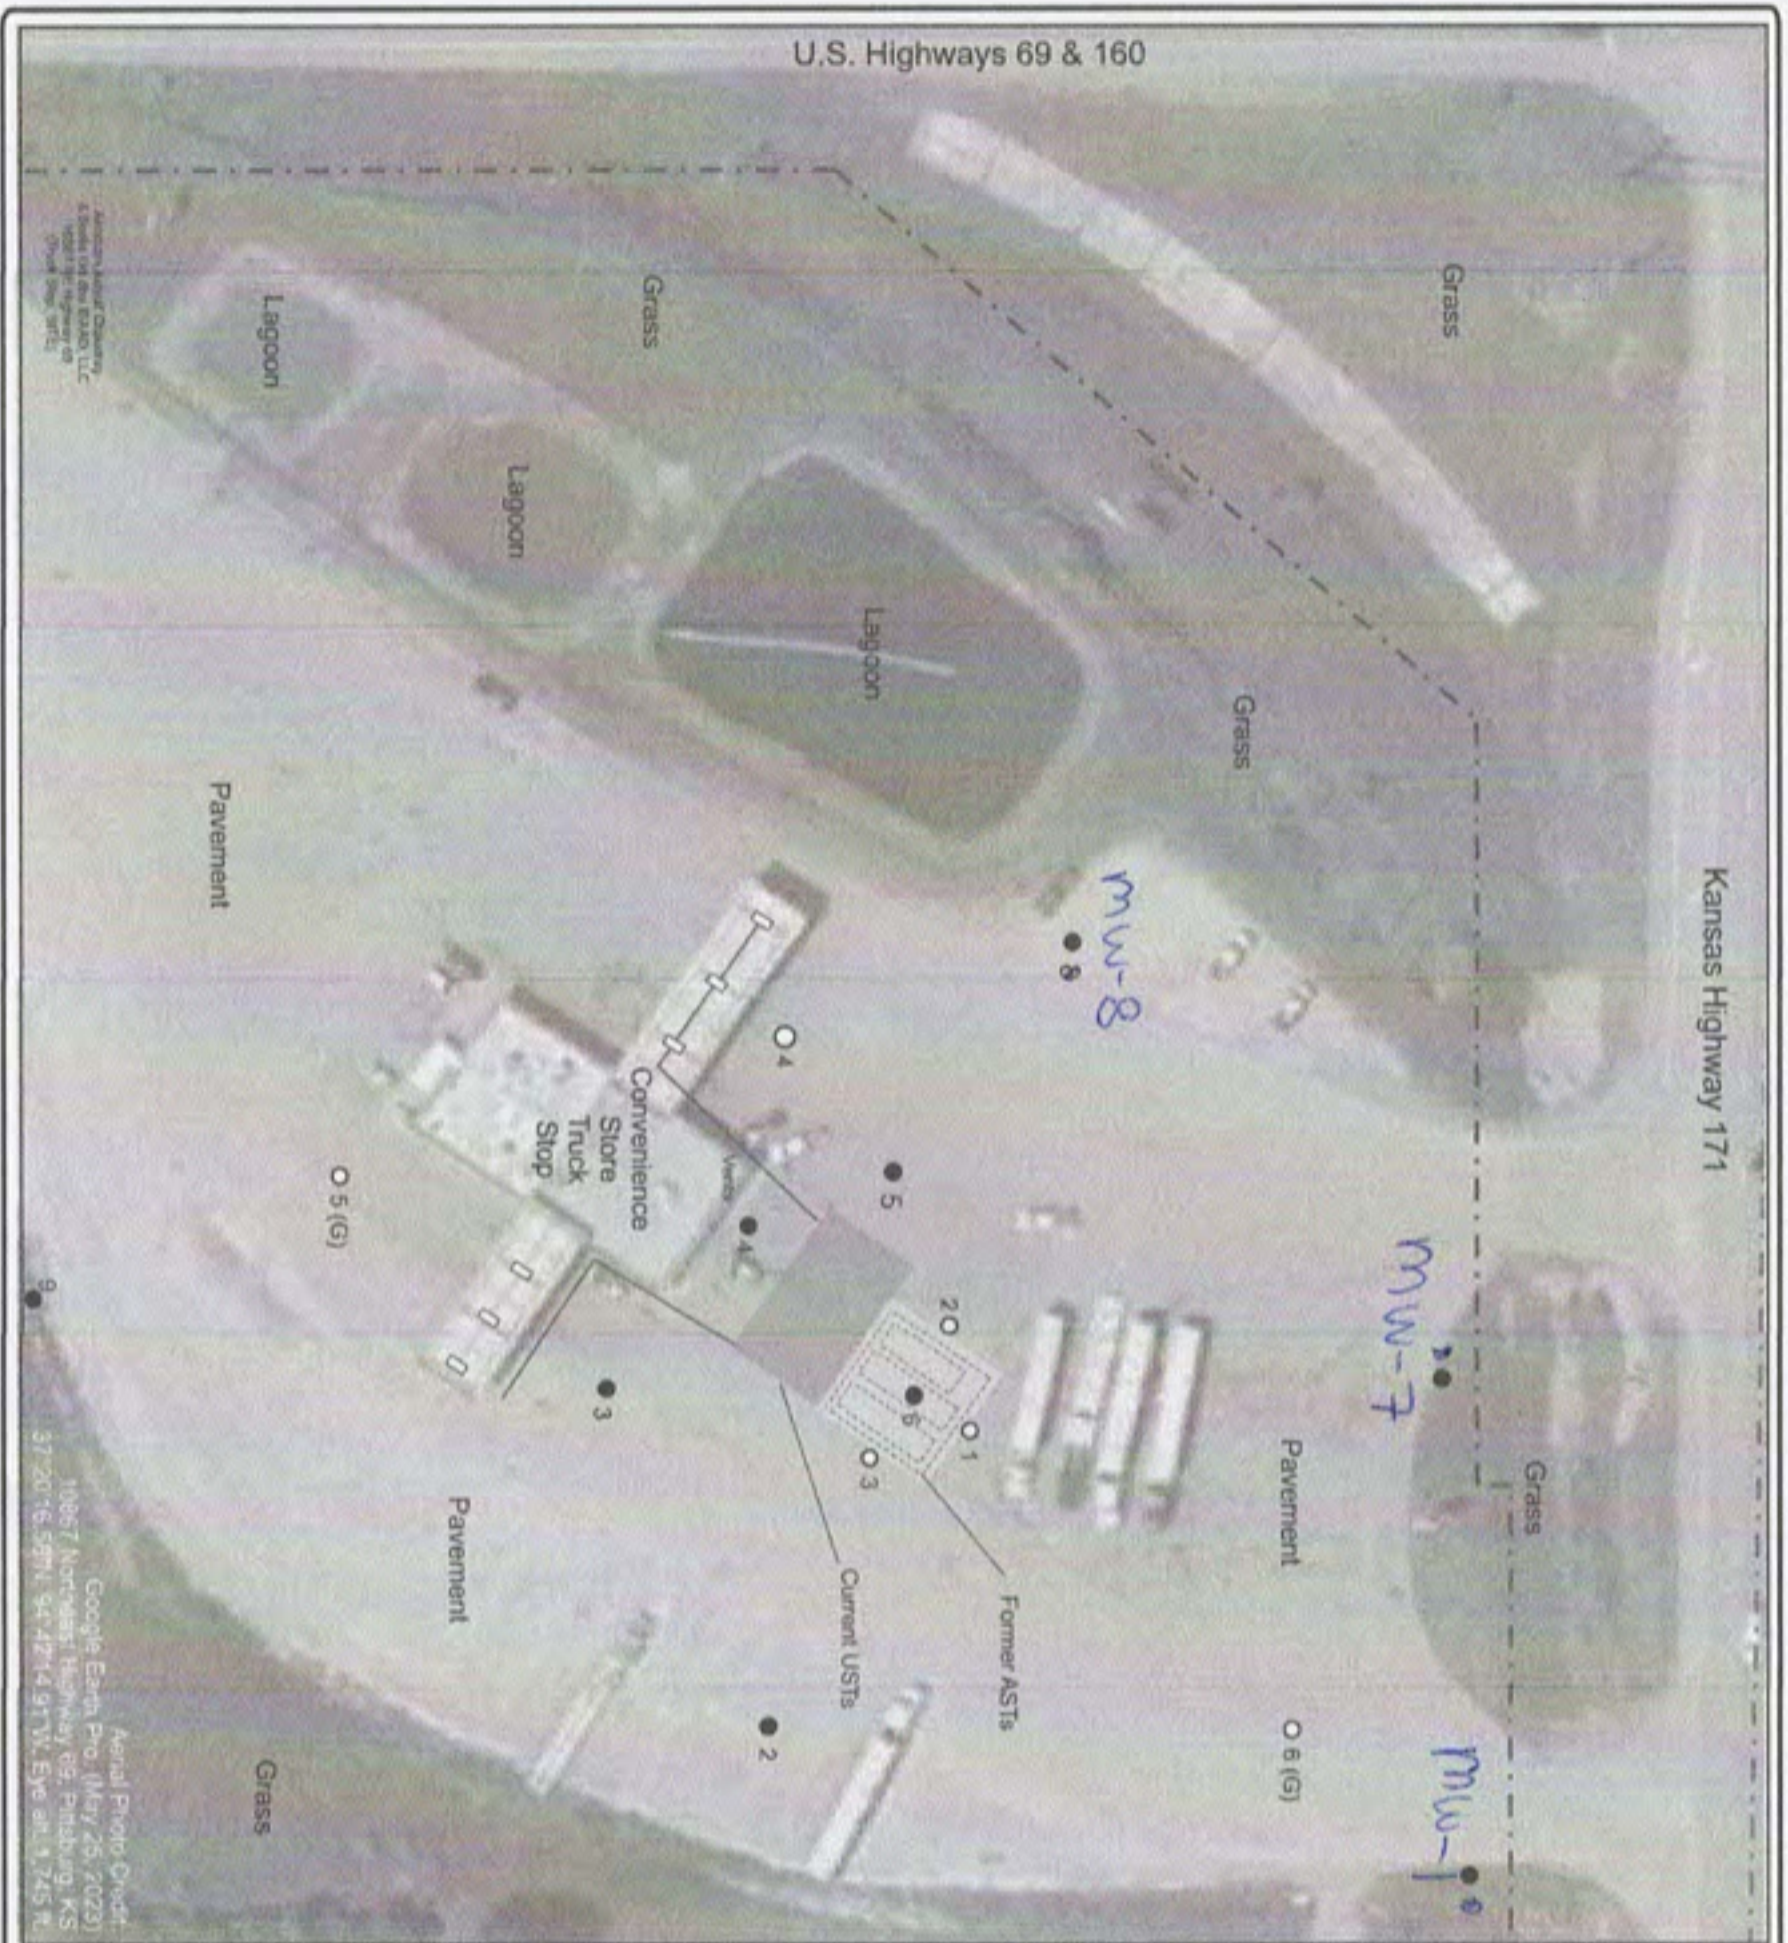

Aerial Photo Credit:


Inferred Groundwater Flow Direction
 (toward eastward flowing tributary of
 Cow Creek, approx. 350 feet north
 of site.)

Notes:

- Proposed Monitoring Well Location
- Proposed Soil Boring Location (borings denoted with (G) for hydrologic samples)
- Former AST Location
- Current UST Location
- Product Piping (approx.)
- Product Dispenser
- · - Property Boundary - Site
- (G) Geotechnical Soil Sampling Location



0
10
50
ft

Note: Scale Approximate

Figure 3

Pittsburg Truck and Travel
 10867 NE Highway 69
 Pittsburg, Kansas
 KDHE Project AS-011-40535



Keightley
 Environmental
 Incorporated
 Leavenworth, Kansas

KEI Job No.: 214-01
 Date: 12/22/25