

WATER WELL RECORD (WWC5.2)

Constructed

KOLAR DOC ID _____ WELL ID _____

LOCATION OF WATER WELL

County		Section		Township		Range		E W	Fraction	¼	¼	¼
Latitude		Longitude		Datum		Elevation						

WATER WELL LOCATION

at owner's address

WATER WELL OWNER

Name	
Business	
Address	

PERMIT & ID NUMBERS (AS REQUIRED)

DWR Application No.: _____
 KDHE / EPA Project Code: _____
 Site Name: _____
 KDHE UIC Class V Form Completed: Yes No
 County/Local Permit Required? Yes No
 Permit Obtained? Yes No Permit ID: _____
 Oil/Gas Lease Name & Well #: _____

CONSTRUCTION

Casing: Height above land surface: _____ in.
 Is casing height less than 12 inches? Yes No

Blank Casing type: _____
 1st interval: _____ ft. to _____ ft.; Diameter _____ in.
 Casing Joint: : _____ Weight: _____ lbs/ft
 Wall thickness or gauge no.: _____
 2nd interval: _____ ft. to _____ ft.; Diameter _____ in.
 Casing Joint: : _____ Weight: _____ lbs/ft
 Wall thickness or gauge no.: _____
 3rd interval: _____ ft. to _____ ft.; Diameter _____ in.
 Casing Joint: : _____ Weight: _____ lbs/ft
 Wall thickness or gauge no.: _____

Screen / Perforation material: _____

Specify if other: _____

Screen / Perforation openings: _____

1st interval _____ ft. to _____ ft. Slot Size _____
 2nd interval _____ ft. to _____ ft. Slot Size _____
 3rd interval _____ ft. to _____ ft. Slot Size _____

WELL WATER USE

Additional info if required:

of Boreholes # of Dewatering Wells

COMPLETION

Depth of completed well: _____ ft.

Depth(s) groundwater encountered: Dry Well

(1) _____ ft.; (2) _____ ft.; (3) _____ ft.;

Static water level in well: _____ ft.

Date measured: _____

Measured from: Top of Casing or Ground Surface

Measured: Above or Below Land Surface

Estimated yield: _____ gpm

Pump Test Date: Water level was:

_____ ft. after _____ hours pumping _____ gpm

_____ ft. after _____ hours pumping _____ gpm

Pump Information:

Pump Installed? Yes No Date: _____

Pump Type: Horsepower: Volts:

Drop Pipe Diameter: in. Drop Pipe Length: ft.

Water well disinfected? Yes No

Date disinfected (mm/dd/yy): _____

CONSTRUCTION**Borehole interval:**

from _____ to _____ ft.

from _____ to _____ ft.

from _____ to _____ ft..

Borehole diameter:

_____ in.

_____ in.

_____ in.

Grout:

1st Interval: _____ ft. to _____ ft. Grout material: _____

2nd Interval: _____ ft. to _____ ft. Grout material: _____

3rd Interval: _____ ft. to _____ ft. Grout material: _____

Gravel pack:


Not Used

1st Interval: _____ ft. to _____ ft. Gravel Size: _____

2nd Interval: _____ ft. to _____ ft. Gravel Size: _____

3rd Interval: _____ ft. to _____ ft. Gravel Size: _____

DESIGNATED PERSON**WELL COMPLETION DATE****CONTRACTOR BUSINESS NAME**

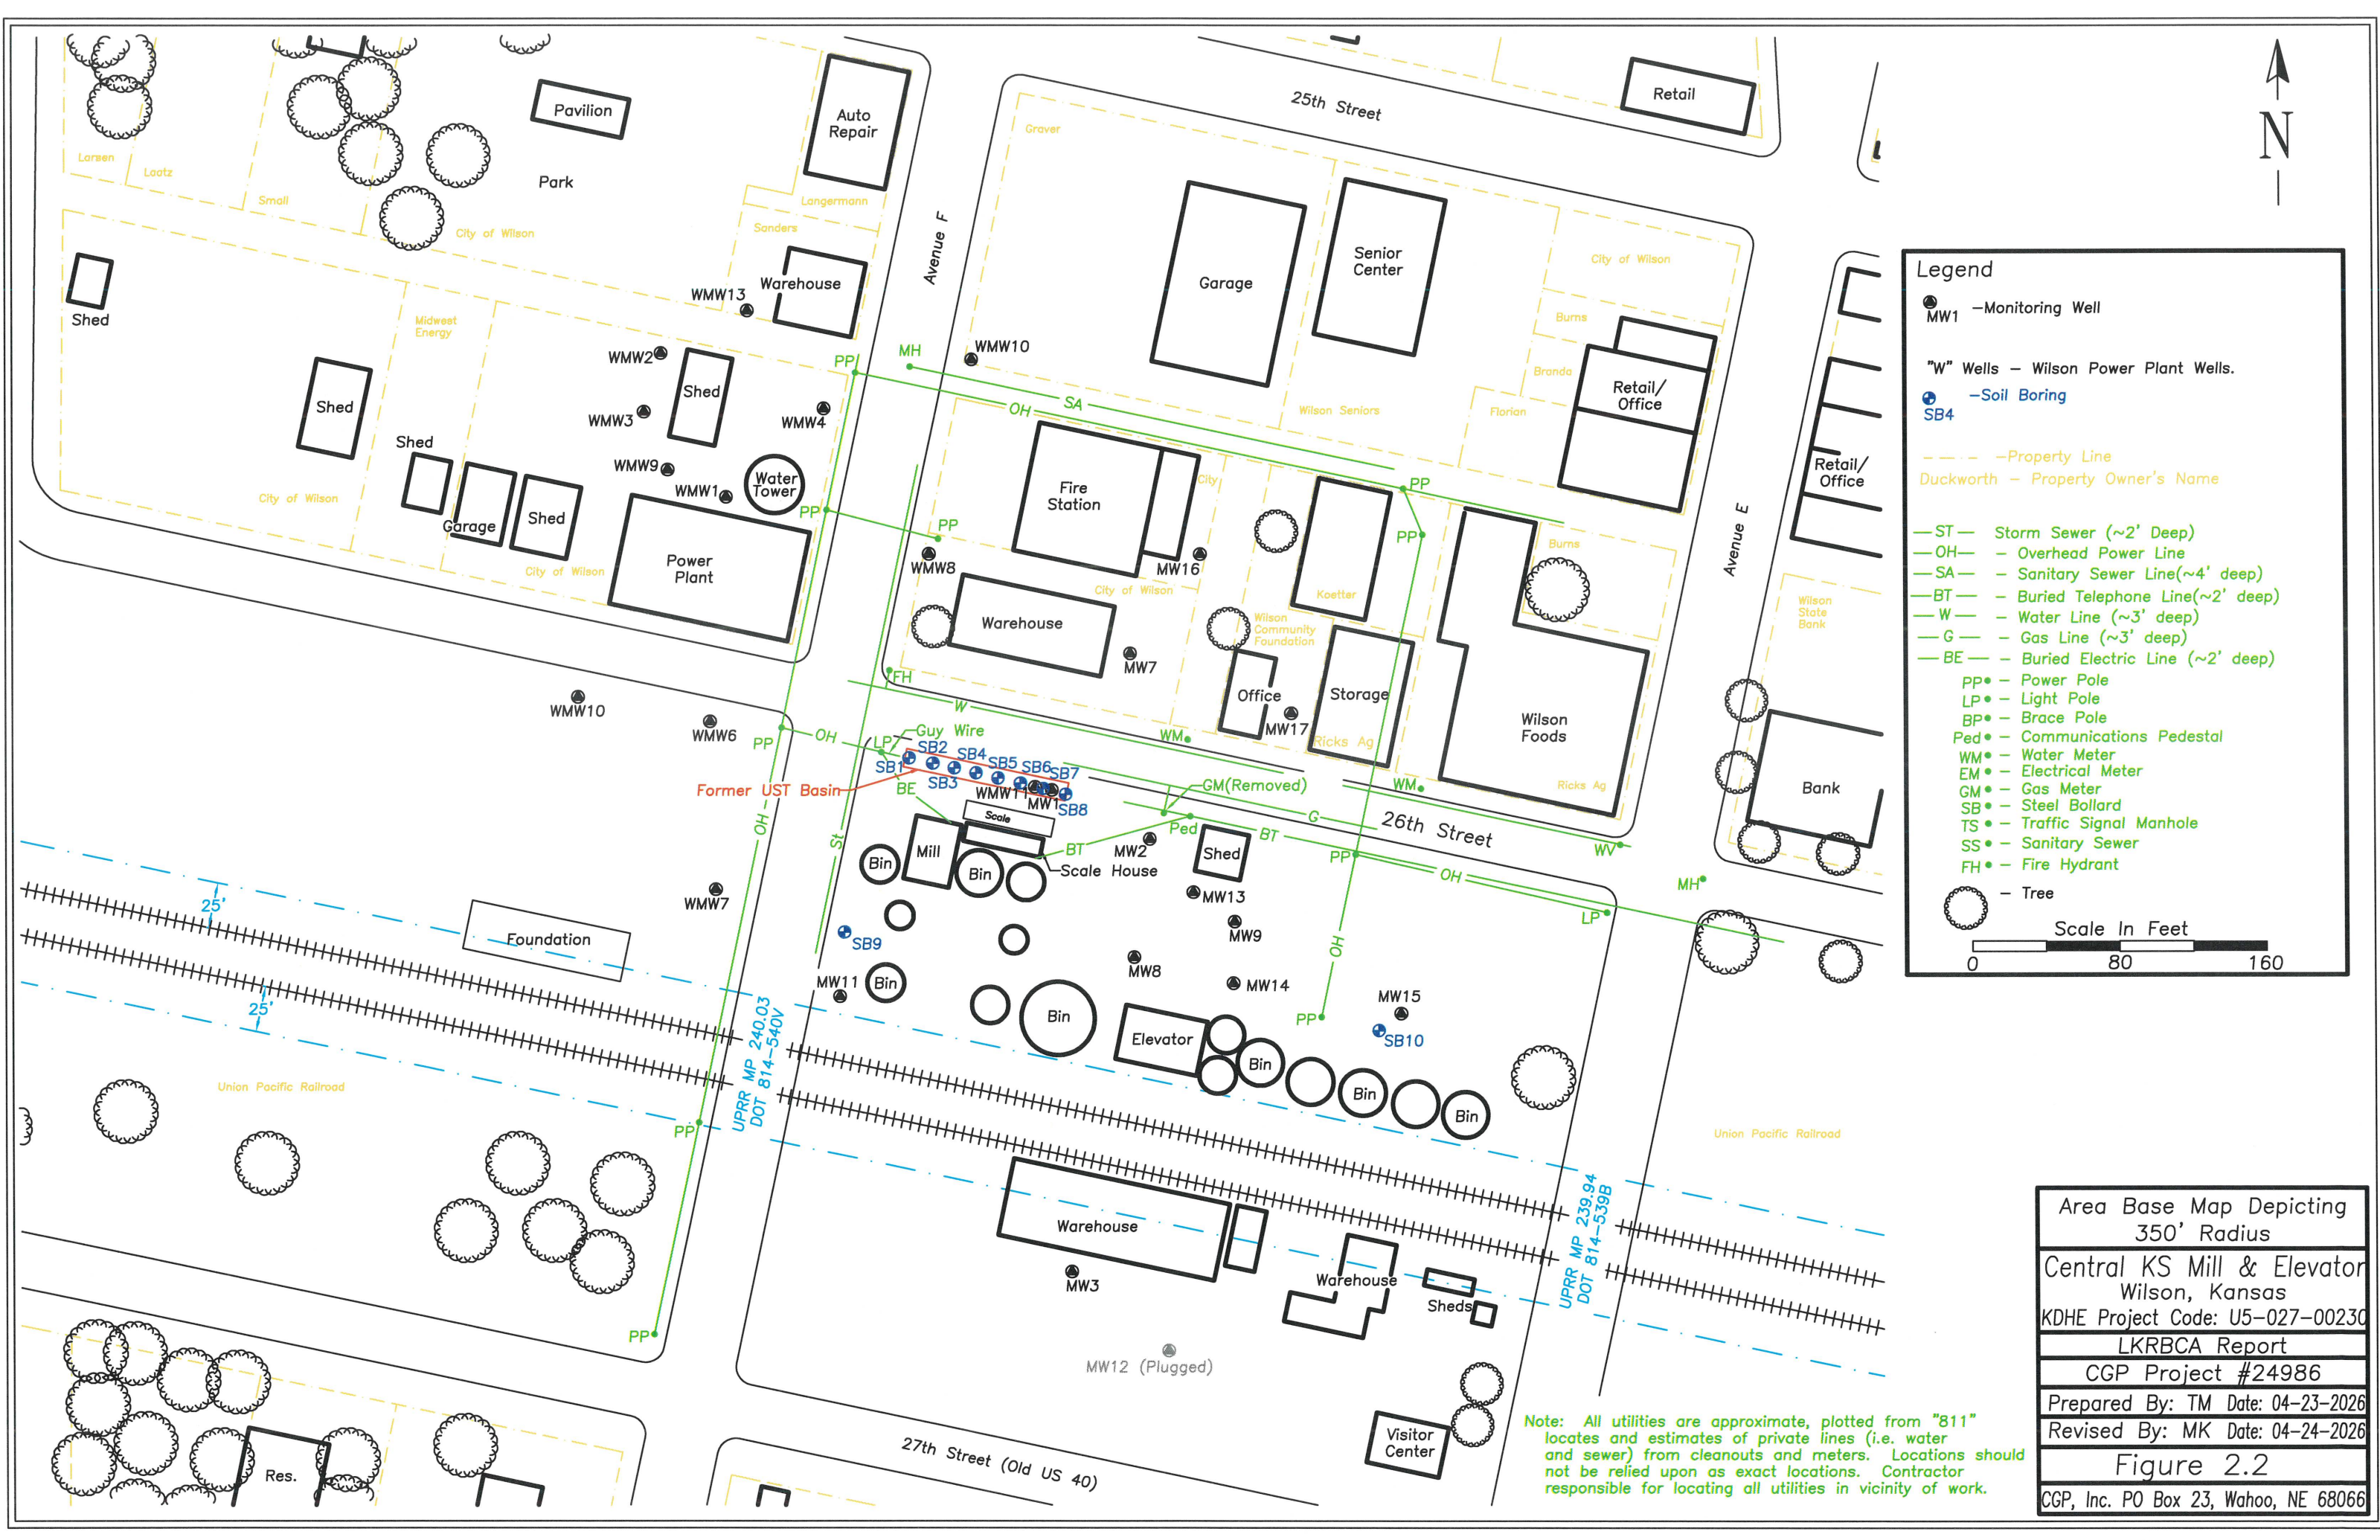

Legend

MW1

Monitoring Well

"W" Wells

Wilson Power Plant Wells.

SB4

Soil Boring

Property Line

Duckworth

Property Owner's Name

ST

Storm Sewer (~2' Deep)

OH

Overhead Power Line

SA

Sanitary Sewer Line(~4' deep)

BT

Buried Telephone Line(~2' deep)

W

Water Line (~3' deep)

G

Gas Line (~3' deep)

BE

Buried Electric Line (~2' deep)

PP

Power Pole

LP

Light Pole

BP

Brace Pole

Ped

Communications Pedestal

WM

Water Meter

EM

Electrical Meter

GM

Gas Meter

SB

Steel Bollard

TS

Traffic Signal Manhole

SS

Sanitary Sewer

FH

Fire Hydrant

Tree

Scale In Feet

0

80

160

Area Base Map Depicting
350' Radius

Central KS Mill & Elevator
Wilson, Kansas

KDHE Project Code: U5-027-00230

LKRBCA Report

CGP Project #24986

Prepared By: TM Date: 04-23-2026

Revised By: MK Date: 04-24-2026

Figure 2.2

CGP, Inc. PO Box 23, Wahoo, NE 68066



April 9 2026

Mathew M. Kralik, P.E.
Senior engineer
Coranco Great Plains, Inc.

RE: Project No. 2603-0123


Matt,

The following is the information requested for, Central Kansas Mill & Elevator, Willson,
Ellsworth County, Kansas

Point	North Coord	East Coord	Distance SE Cor. North	From Sec. West	Elev. Top of Rim or PK Nail	Elev. Top of PVC Pipe	Latitude North	Longitude West
SE Corner S.19- T14S-R10W	174938.73	1179077.25					38.81272	-98.4677
MW 16	179803.16	1177078.23	4864.43	1999.02	1689.81	1689.52	38.82604	-98.4748
MW 17	179715.21	1177128.99	4776.48	1948.26	1689.50	1689.13	38.8258	-98.4746
MW 15	179563.99	1177183.64	4625.26	1893.61	1688.34	1688.03	38.82539	-98.4744
Site BM	179651.3	1176987.6	4712.53	2089.62			SBM Elevation = 1689.48	

If you have any questions, please do not hesitate to give us a call.

Sincerely,

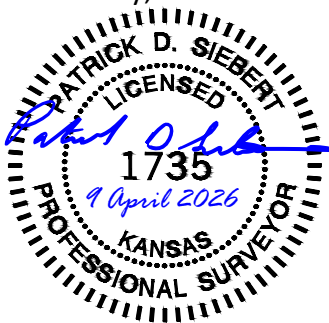

Patrick D. Siebert, PLS
SMH Consultants

MANHATTAN - HQ
2017 Vanesta Place, Suite 110
Manhattan, KS 66503
P: 785-776-0541

DODGE CITY
707 3rd Avenue, Suite A
Dodge City, KS 67801
P: 620-255-1952

KANSAS CITY
5201 Johnson Drive, Suite 405
Mission, KS 66205
P: 913-444-9615

COLORADO SPRINGS
620 N. Tejon Street, Suite 201
Colorado Springs, CO 80903
P: 719-465-2145