

WATER WELL RECORD (WWC5.2)

Constructed

KOLAR DOC ID _____ WELL ID _____

LOCATION OF WATER WELL

| | | | | | | | |
|----------|-----------|----------|-----------|--------------------------------------|---|---|---|
| County | Section | Township | Range | ^E / _W Fraction | ¼ | ¼ | ¼ |
| Latitude | Longitude | Datum | Elevation | | | | |

WATER WELL LOCATION _____ at owner's address

WATER WELL OWNER

| | |
|----------|--|
| Name | |
| Business | |
| Address | |

PERMIT & ID NUMBERS (AS REQUIRED)

DWR Application No.: _____
 KDHE / EPA Project Code: _____
 Site Name: _____
 KDHE UIC Class V Form Completed: Yes No
 County/Local Permit Required? Yes No
 Permit Obtained? Yes No Permit ID: _____
 Oil/Gas Lease Name & Well #: _____

CONSTRUCTION

Casing: Height above land surface: _____ in.
 Is casing height less than 12 inches? Yes No

Blank Casing type: _____
 1st interval: _____ ft. to _____ ft.; Diameter _____ in.
 Casing Joint: : _____ Weight: _____ lbs/ft
 Wall thickness or gauge no.: _____
 2nd interval: _____ ft. to _____ ft.; Diameter _____ in.
 Casing Joint: : _____ Weight: _____ lbs/ft
 Wall thickness or gauge no.: _____
 3rd interval: _____ ft. to _____ ft.; Diameter _____ in.
 Casing Joint: : _____ Weight: _____ lbs/ft
 Wall thickness or gauge no.: _____

Screen / Perforation material: _____
 Specify if other: _____
 Screen / Perforation openings: _____
 1st interval _____ ft. to _____ ft. Slot Size _____
 2nd interval _____ ft. to _____ ft. Slot Size _____
 3rd interval _____ ft. to _____ ft. Slot Size _____

DESIGNATED PERSON

CONTRACTOR BUSINESS NAME

WELL WATER USE

Additional info if required:
 # of Boreholes _____ # of Dewatering Wells _____

COMPLETION

Depth of completed well: _____ ft.
 Depth(s) groundwater encountered: Dry Well
 (1) _____ ft.; (2) _____ ft.; (3) _____ ft.;
 Static water level in well: _____ ft.
 Date measured: _____
 Measured from: Top of Casing or Ground Surface
 Measured: Above or Below Land Surface

Estimated yield: _____ gpm
 Pump Test Date: Water level was:
 _____ ft. after _____ hours pumping _____ gpm
 _____ ft. after _____ hours pumping _____ gpm

Pump Information:

Pump Installed? Yes No Date: _____
 Pump Type: _____ Horsepower: _____ Volts: _____
 Drop Pipe Diameter: _____ in. Drop Pipe Length: _____ ft.
 Water well disinfected? Yes No
 Date disinfected (mm/dd/yy): _____

CONSTRUCTION

| | |
|--|--|
| Borehole interval: from _____ to _____ ft. | Borehole diameter: _____ in. |
| from _____ to _____ ft. | |
| from _____ to _____ ft.. | |


Grout:

1st Interval: _____ ft. to _____ ft. Grout material: _____
 2nd Interval: _____ ft. to _____ ft. Grout material: _____
 3rd Interval: _____ ft. to _____ ft. Grout material: _____

Gravel pack: _____ Not Used

1st Interval: _____ ft. to _____ ft. Gravel Size: _____
 2nd Interval: _____ ft. to _____ ft. Gravel Size: _____
 3rd Interval: _____ ft. to _____ ft. Gravel Size: _____

WELL COMPLETION DATE

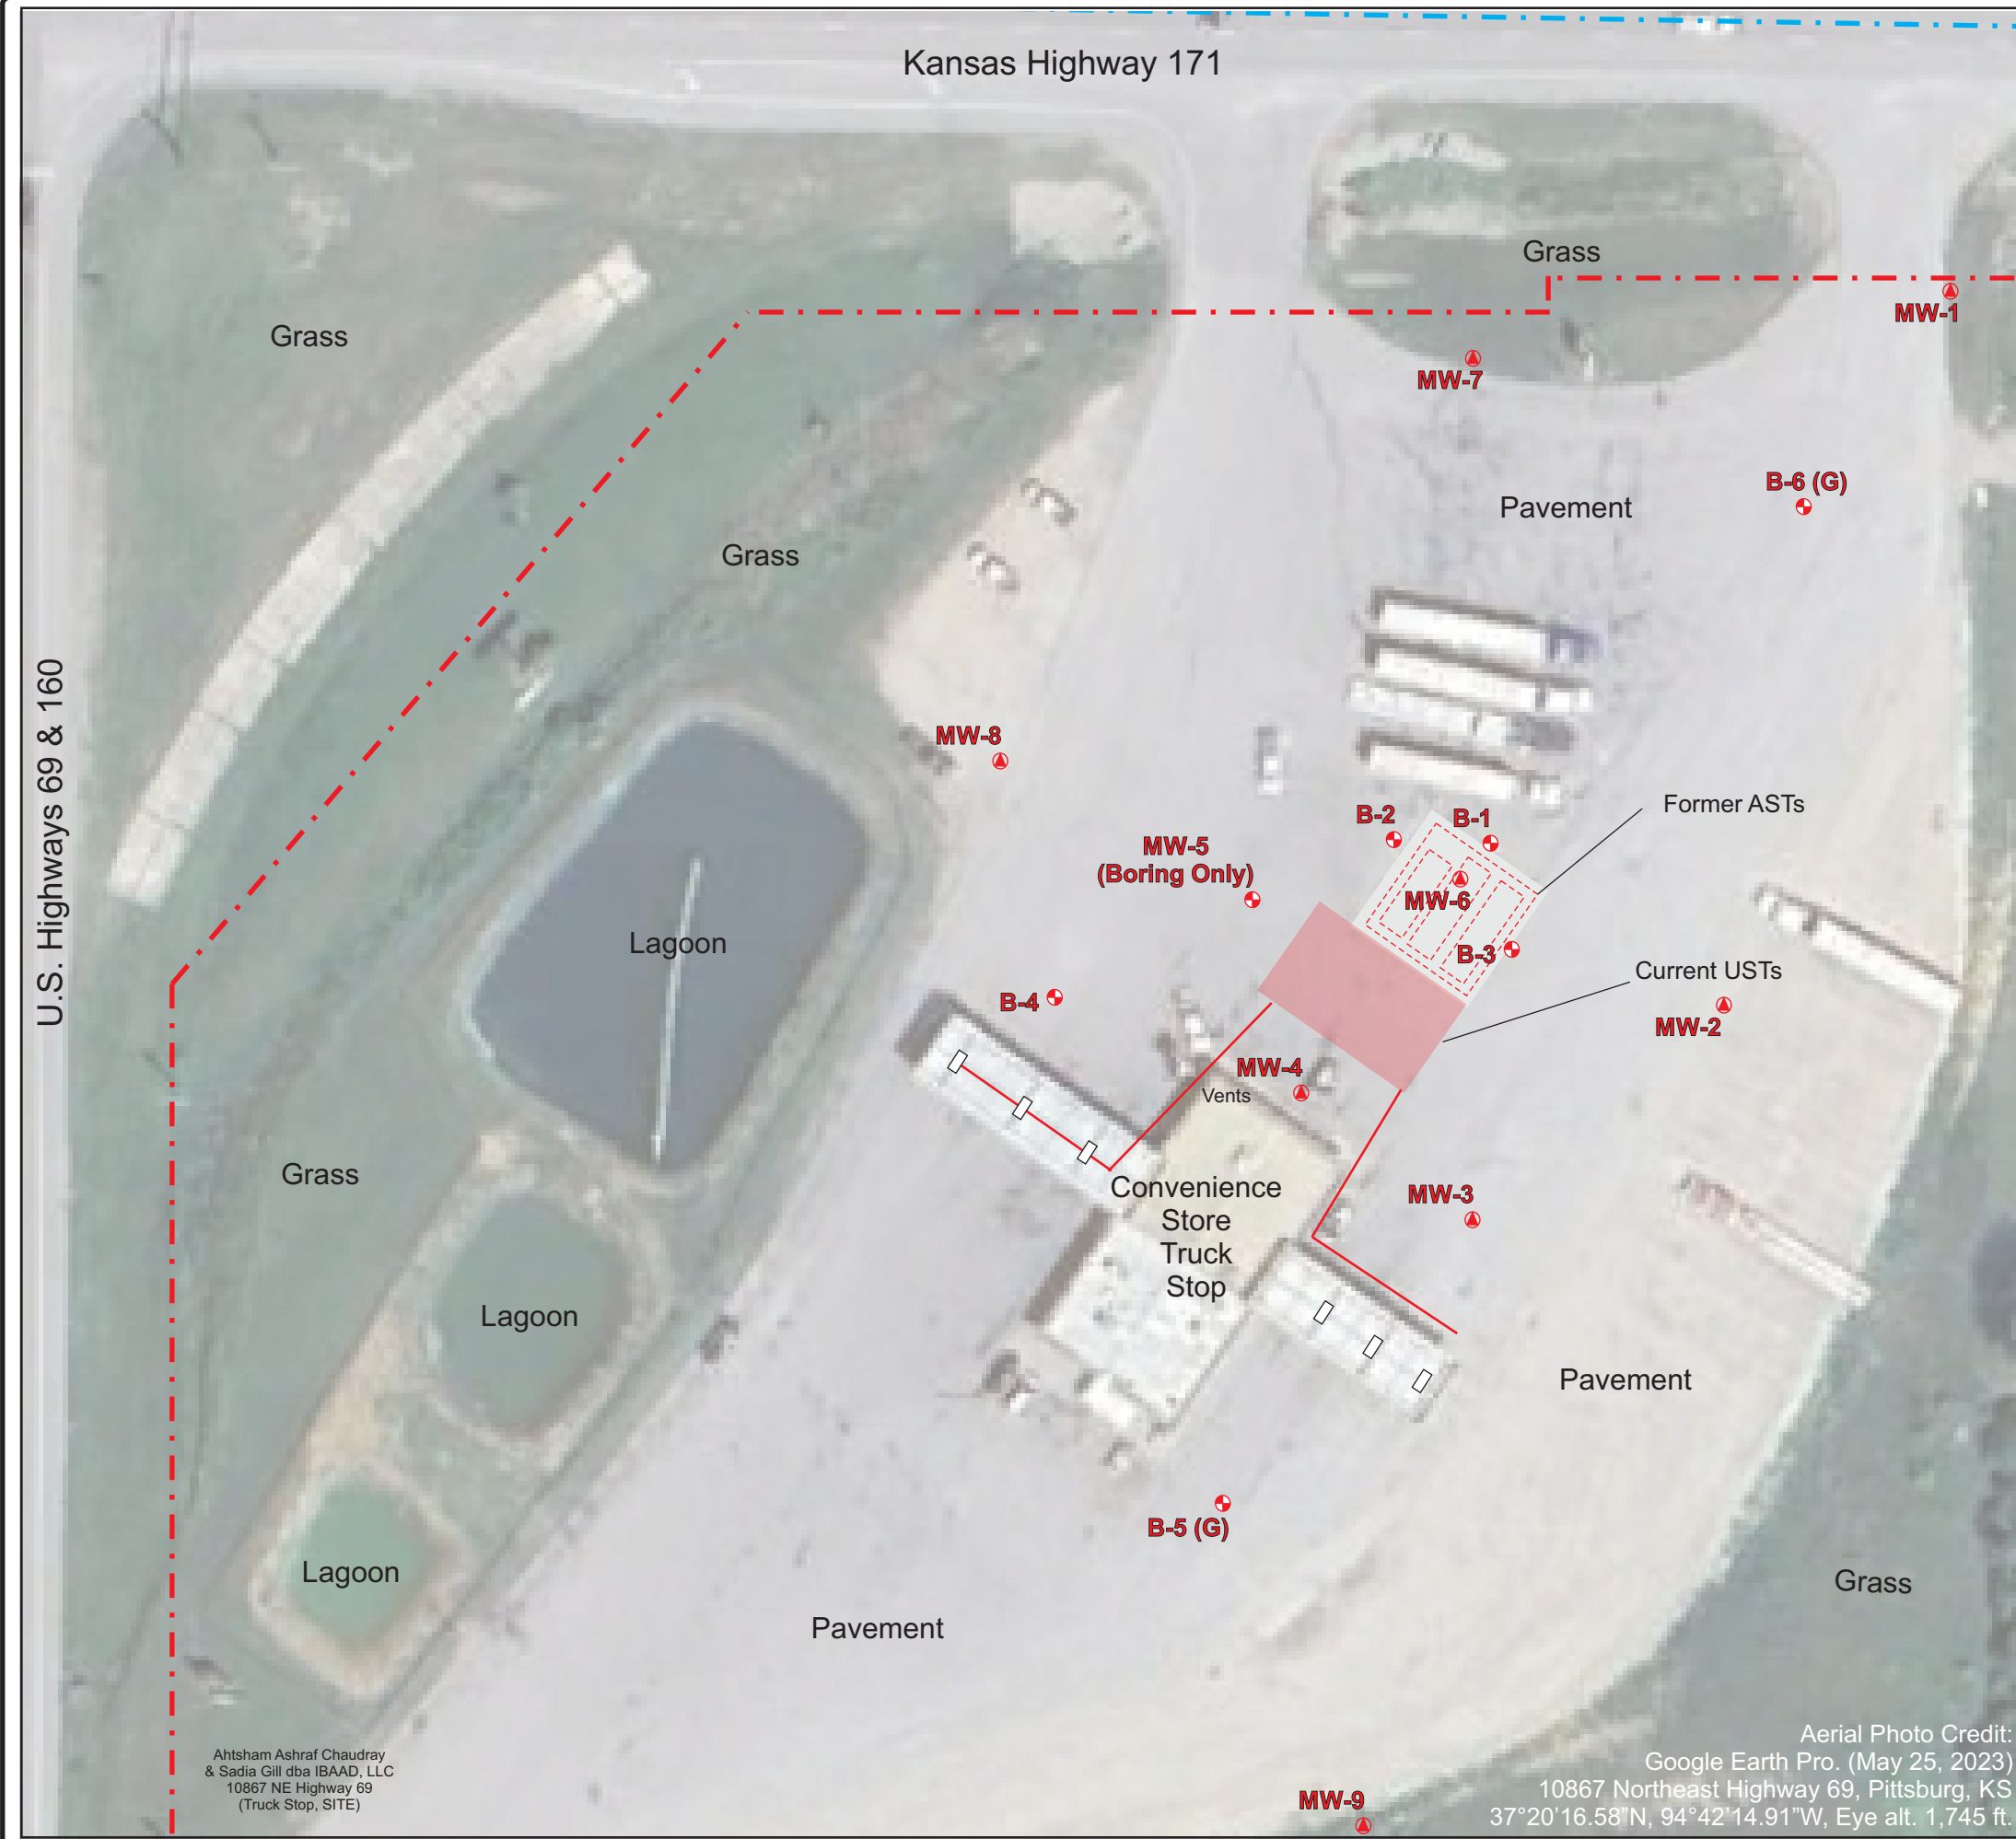


Inferred Groundwater Flow Direction
 (toward eastward flowing tributary of
 Cow Creek, approx. 950 feet north
 of site.)

Notes:

- Monitoring Well Location
- Soil Boring Location
- Former AST Location
- Current UST Location
- Product Piping (approx.)
- Product Dispenser
- Property Boundary - Site
- (G) Geotechnical Soil Sampling Location

Knightly Environmental Incorporated
 Lenexa, Kansas

KEI Job No.: 214-01
 Date: 5/19/26

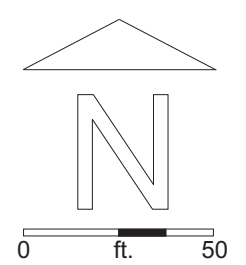

Note: Scale Approximate

Figure 1
Pittsburg Truck and Travel
 10867 NE Highway 69
 Pittsburg, Kansas
 KDHE Project A3-011-40535

Site Map

Ahtsham Ashraf Chaudray
 & Sadia Gill dba IBAAD, LLC
 10867 NE Highway 69
 (Truck Stop, SITE)

Aerial Photo Credit:
 Google Earth Pro. (May 25, 2023)
 10867 Northeast Highway 69, Pittsburg, KS
 37°20'16.58"N, 94°42'14.91"W, Eye alt. 1,745 ft.