

WATER WELL RECORD (WWC5.2)

Constructed

KOLAR DOC ID _____ WELL ID _____

LOCATION OF WATER WELL

County	Section	Township	Range	^E / _W Fraction	¼	¼	¼
Latitude	Longitude	Datum	Elevation				

WATER WELL LOCATION _____ at owner's address

WATER WELL OWNER

Name	
Business	
Address	

PERMIT & ID NUMBERS (AS REQUIRED)

DWR Application No.: _____
 KDHE / EPA Project Code: _____
 Site Name: _____
 KDHE UIC Class V Form Completed: Yes No
 County/Local Permit Required? Yes No
 Permit Obtained? Yes No Permit ID: _____
 Oil/Gas Lease Name & Well #: _____

CONSTRUCTION

Casing: Height above land surface: _____ in.
 Is casing height less than 12 inches? Yes No

Blank Casing type: _____
 1st interval: _____ ft. to _____ ft.; Diameter _____ in.
 Casing Joint: : _____ Weight: _____ lbs/ft
 Wall thickness or gauge no.: _____
 2nd interval: _____ ft. to _____ ft.; Diameter _____ in.
 Casing Joint: : _____ Weight: _____ lbs/ft
 Wall thickness or gauge no.: _____
 3rd interval: _____ ft. to _____ ft.; Diameter _____ in.
 Casing Joint: : _____ Weight: _____ lbs/ft
 Wall thickness or gauge no.: _____

Screen / Perforation material: _____
 Specify if other: _____
 Screen / Perforation openings: _____
 1st interval _____ ft. to _____ ft. Slot Size _____
 2nd interval _____ ft. to _____ ft. Slot Size _____
 3rd interval _____ ft. to _____ ft. Slot Size _____

DESIGNATED PERSON

CONTRACTOR BUSINESS NAME

WELL WATER USE

Additional info if required:
 # of Boreholes _____ # of Dewatering Wells _____

COMPLETION

Depth of completed well: _____ ft.
 Depth(s) groundwater encountered: Dry Well
 (1) _____ ft.; (2) _____ ft.; (3) _____ ft.;
 Static water level in well: _____ ft.
 Date measured: _____
 Measured from: Top of Casing or Ground Surface
 Measured: Above or Below Land Surface

Estimated yield: _____ gpm
 Pump Test Date: Water level was:
 _____ ft. after _____ hours pumping _____ gpm
 _____ ft. after _____ hours pumping _____ gpm

Pump Information:

Pump Installed? Yes No Date: _____
 Pump Type: _____ Horsepower: _____ Volts: _____
 Drop Pipe Diameter: _____ in. Drop Pipe Length: _____ ft.

Water well disinfected? Yes No
 Date disinfected (mm/dd/yy): _____

CONSTRUCTION

Borehole interval: from _____ to _____ ft. from _____ to _____ ft. from _____ to _____ ft..	Borehole diameter: _____ in. _____ in. _____ in.
---	--


Grout:

1st Interval: _____ ft. to _____ ft. Grout material: _____
 2nd Interval: _____ ft. to _____ ft. Grout material: _____
 3rd Interval: _____ ft. to _____ ft. Grout material: _____

Gravel pack: _____ Not Used

1st Interval: _____ ft. to _____ ft. Gravel Size: _____
 2nd Interval: _____ ft. to _____ ft. Gravel Size: _____
 3rd Interval: _____ ft. to _____ ft. Gravel Size: _____

WELL COMPLETION DATE

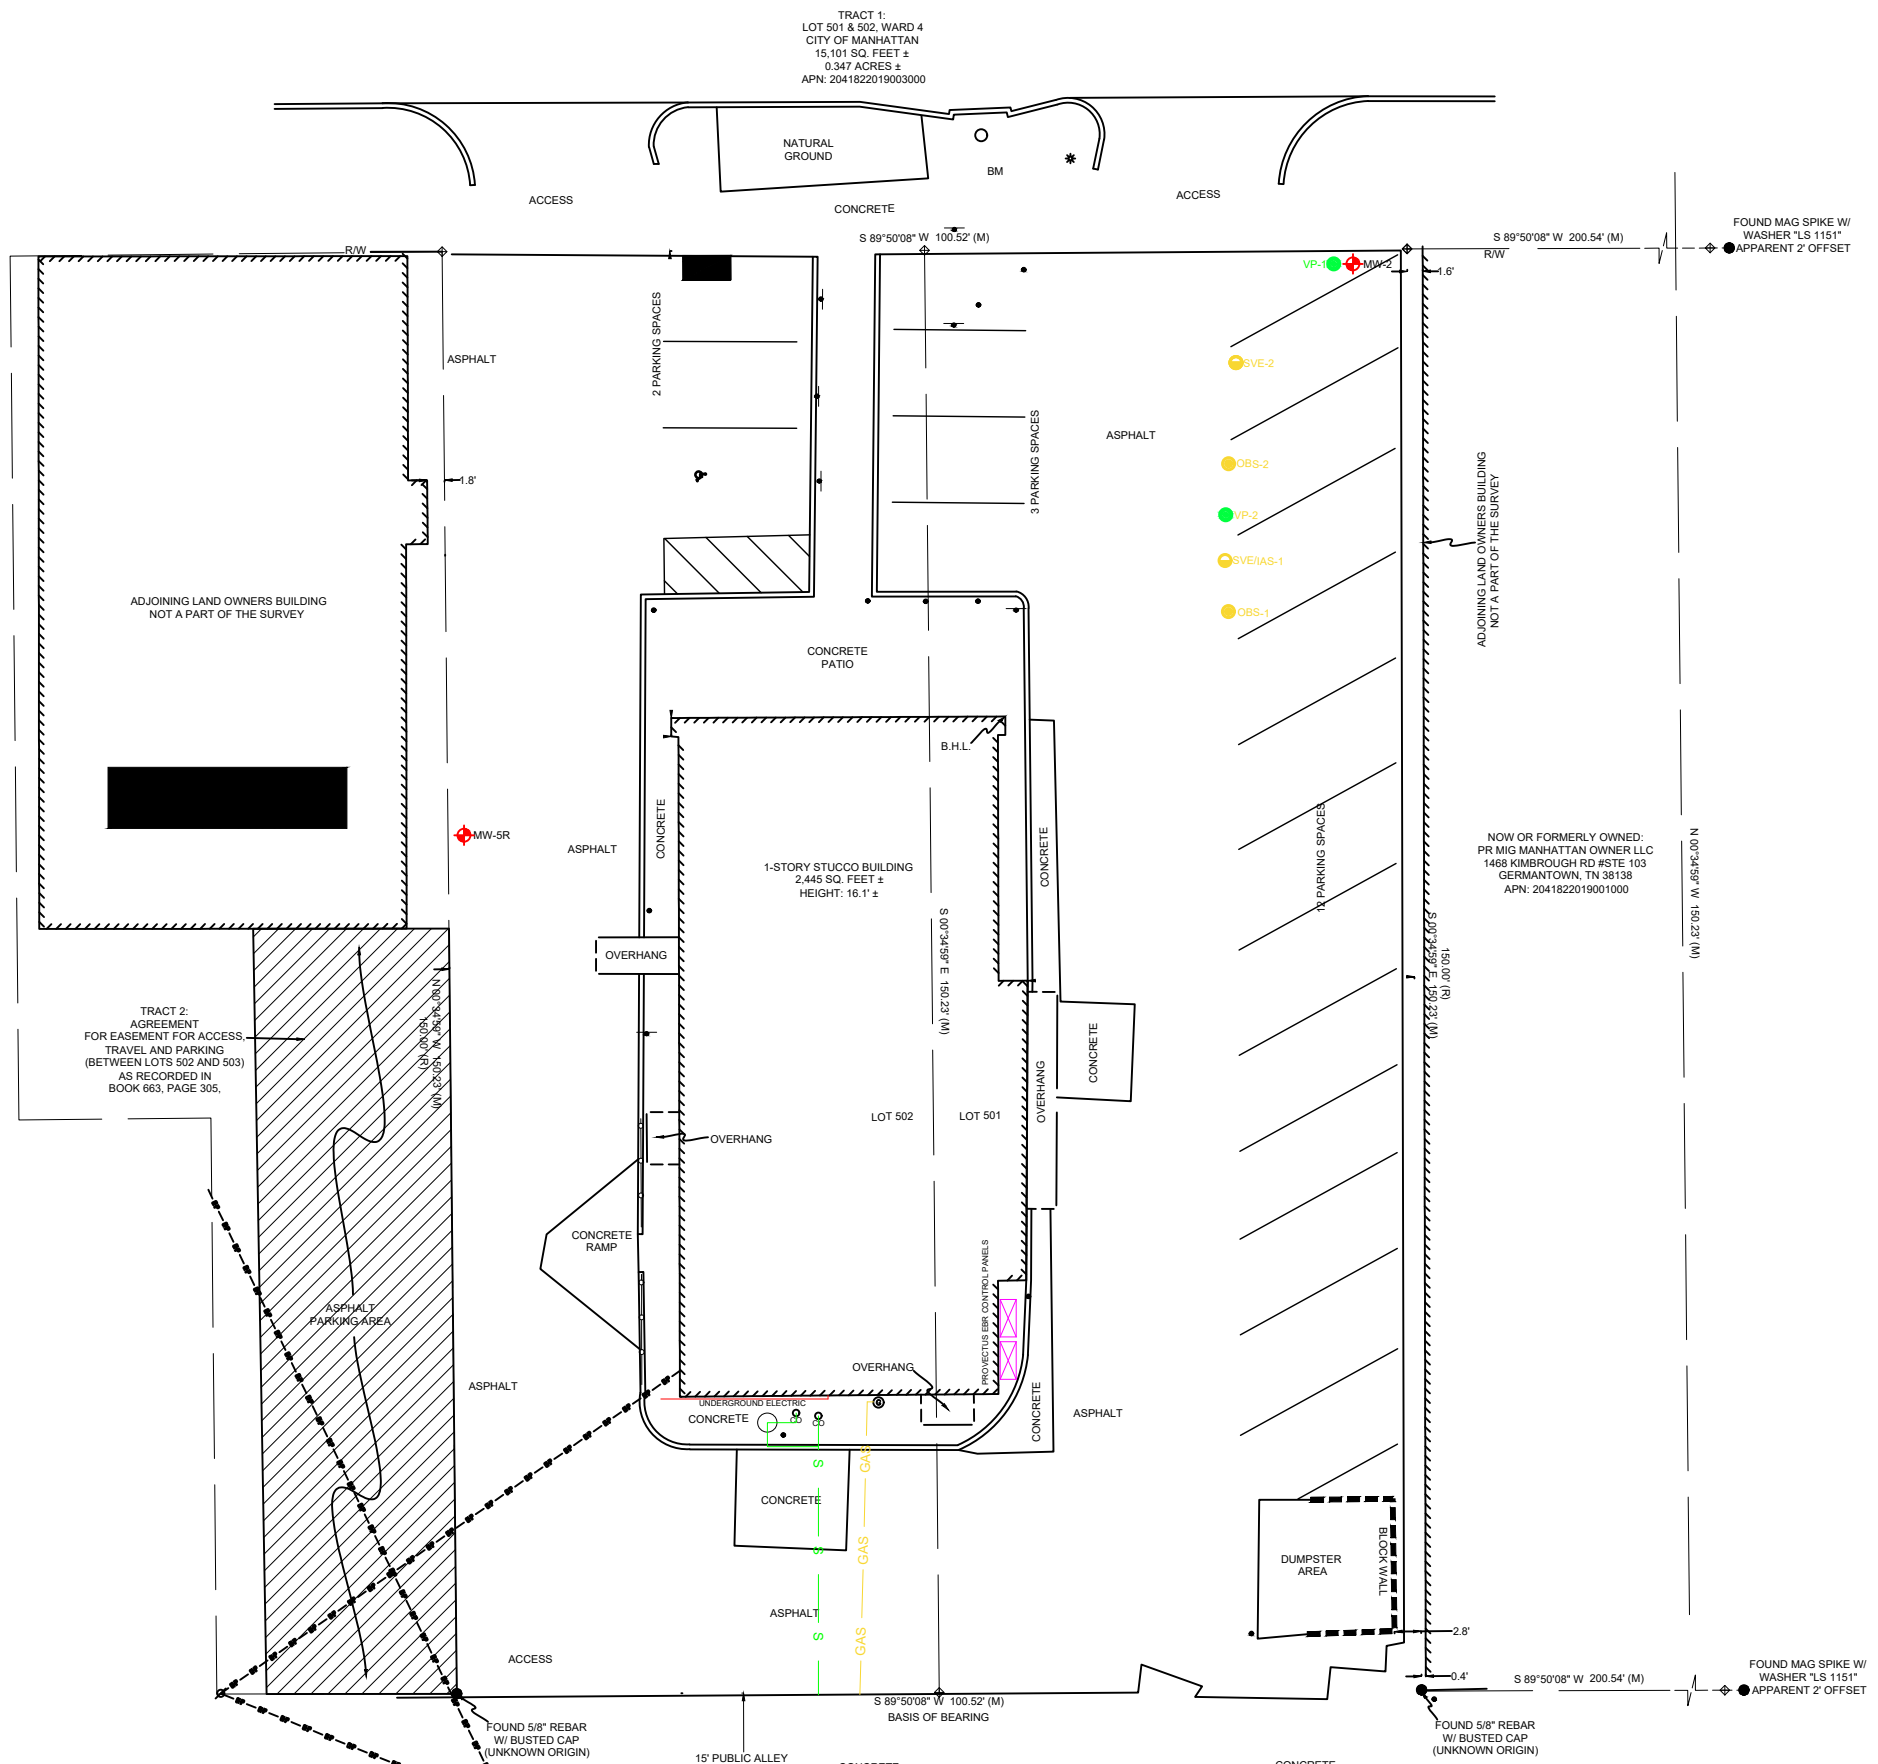

TRACT 1:
 LOT 501 & 502, WARD 4
 CITY OF MANHATTAN
 15,101 SQ. FEET ±
 0.347 ACRES ±
 APN: 2041822019003000

TRACT 2:
 AGREEMENT
 FOR EASEMENT FOR ACCESS,
 TRAVEL AND PARKING
 (BETWEEN LOTS 502 AND 503)
 AS RECORDED IN
 BOOK 663, PAGE 305,

NOW OR FORMERLY OWNED:
 PR MIG MANHATTAN OWNER LLC
 1468 KIMBROUGH RD #STE 103
 GERMANTOWN, TN 38138
 APN: 2041822019001000

Legend

- MONITORING WELL
- ABANDONED MONITORING WELL
- GROUNDWATER SAMPLE LOCATION - AUG, 2024
- SOIL VAPOR PIN LOCATION - OCT, 2024
- GROUNDWATER AND SOIL VAPOR LOCATION - NOV, 2024
- OBSERVATION WELL
- SVE/IAS TEST WELL
- SVE TEST WELL
- EAB TREATMENT CURTAINS
- FORMER CINDERELLA CLEANER
- STICKEL CLEANERS

ALL LOCATIONS AND BOUNDARIES ARE APPROXIMATE

FIGURE: 1
 DATE: 07/29/2025
 DRAWN BY: SGE

FIGURE NAME: Site Base Map
 PROJECT NUMBER: A23124.00122.005
 PROJECT MANAGER: SGE

Cinderella Cleaners & Stickel Cleaners
 1227 Bluemont Avenue & 714 N 12th St.
 Manhattan, KS
 KDHE Project Codes: C5-081-70782 & C5-081-71238

