

WATER WELL RECORD (WWC5.2)

Constructed

KOLAR DOC ID _____ WELL ID _____

LOCATION OF WATER WELL

County		Section		Township		Range	$\frac{E}{W}$	Fraction	$\frac{1}{4}$	$\frac{1}{4}$	$\frac{1}{4}$
Latitude		Longitude		Datum		Elevation					

WATER WELL LOCATION

at owner's address

WATER WELL OWNER

Name	
Business	
Address	

PERMIT & ID NUMBERS (AS REQUIRED)

DWR Application No.: _____

KDHE / EPA Project Code: _____

Site Name: _____

KDHE UIC Class V Form Completed: Yes No

County/Local Permit Required? Yes No

Permit Obtained? Yes No Permit ID: _____

Oil/Gas Lease Name & Well #: _____

CONSTRUCTION

Casing: Height above land surface: _____ in.

Is casing height less than 12 inches? Yes No

Blank Casing type: _____

1st interval: _____ ft. to _____ ft.; Diameter _____ in.

Casing Joint: : _____ Weight: _____ lbs/ft

Wall thickness or gauge no.: _____

2nd interval: _____ ft. to _____ ft.; Diameter _____ in.

Casing Joint: : _____ Weight: _____ lbs/ft

Wall thickness or gauge no.: _____

3rd interval: _____ ft. to _____ ft.; Diameter _____ in.

Casing Joint: : _____ Weight: _____ lbs/ft

Wall thickness or gauge no.: _____

Screen / Perforation material: _____

Specify if other: _____

Screen / Perforation openings: _____

1st interval _____ ft. to _____ ft. Slot Size _____

2nd interval _____ ft. to _____ ft. Slot Size _____

3rd interval _____ ft. to _____ ft. Slot Size _____

WELL WATER USE

Additional info if required:

of Boreholes

of Dewatering Wells

COMPLETION

Depth of completed well: _____ ft.

Depth(s) groundwater encountered: Dry Well

(1) _____ ft.; (2) _____ ft.; (3) _____ ft.;

Static water level in well: _____ ft.

Date measured: _____

Measured from: Top of Casing or Ground Surface

Measured: Above or Below Land Surface

Estimated yield: _____ gpm

Pump Test Date: Water level was:

_____ ft. after _____ hours pumping _____ gpm

_____ ft. after _____ hours pumping _____ gpm

Pump Information:

Pump Installed? Yes No Date: _____

Pump Type: Horsepower: Volts:

Drop Pipe Diameter: in. Drop Pipe Length: ft.

Water well disinfected? Yes No

Date disinfected (mm/dd/yy): _____

CONSTRUCTION**Borehole interval:**

from _____ to _____ ft.

from _____ to _____ ft.

from _____ to _____ ft..

Borehole diameter:

_____ in.

_____ in.

_____ in.

Grout:

1st Interval: _____ ft. to _____ ft. Grout material: _____

2nd Interval: _____ ft. to _____ ft. Grout material: _____

3rd Interval: _____ ft. to _____ ft. Grout material: _____

Gravel pack:

Not Used


1st Interval: _____ ft. to _____ ft. Gravel Size: _____

2nd Interval: _____ ft. to _____ ft. Gravel Size: _____

3rd Interval: _____ ft. to _____ ft. Gravel Size: _____

DESIGNATED PERSON**WELL COMPLETION DATE****CONTRACTOR BUSINESS NAME**

NIC: NMW-44DR Replacement Well Location; Former El Paso Refinery Site

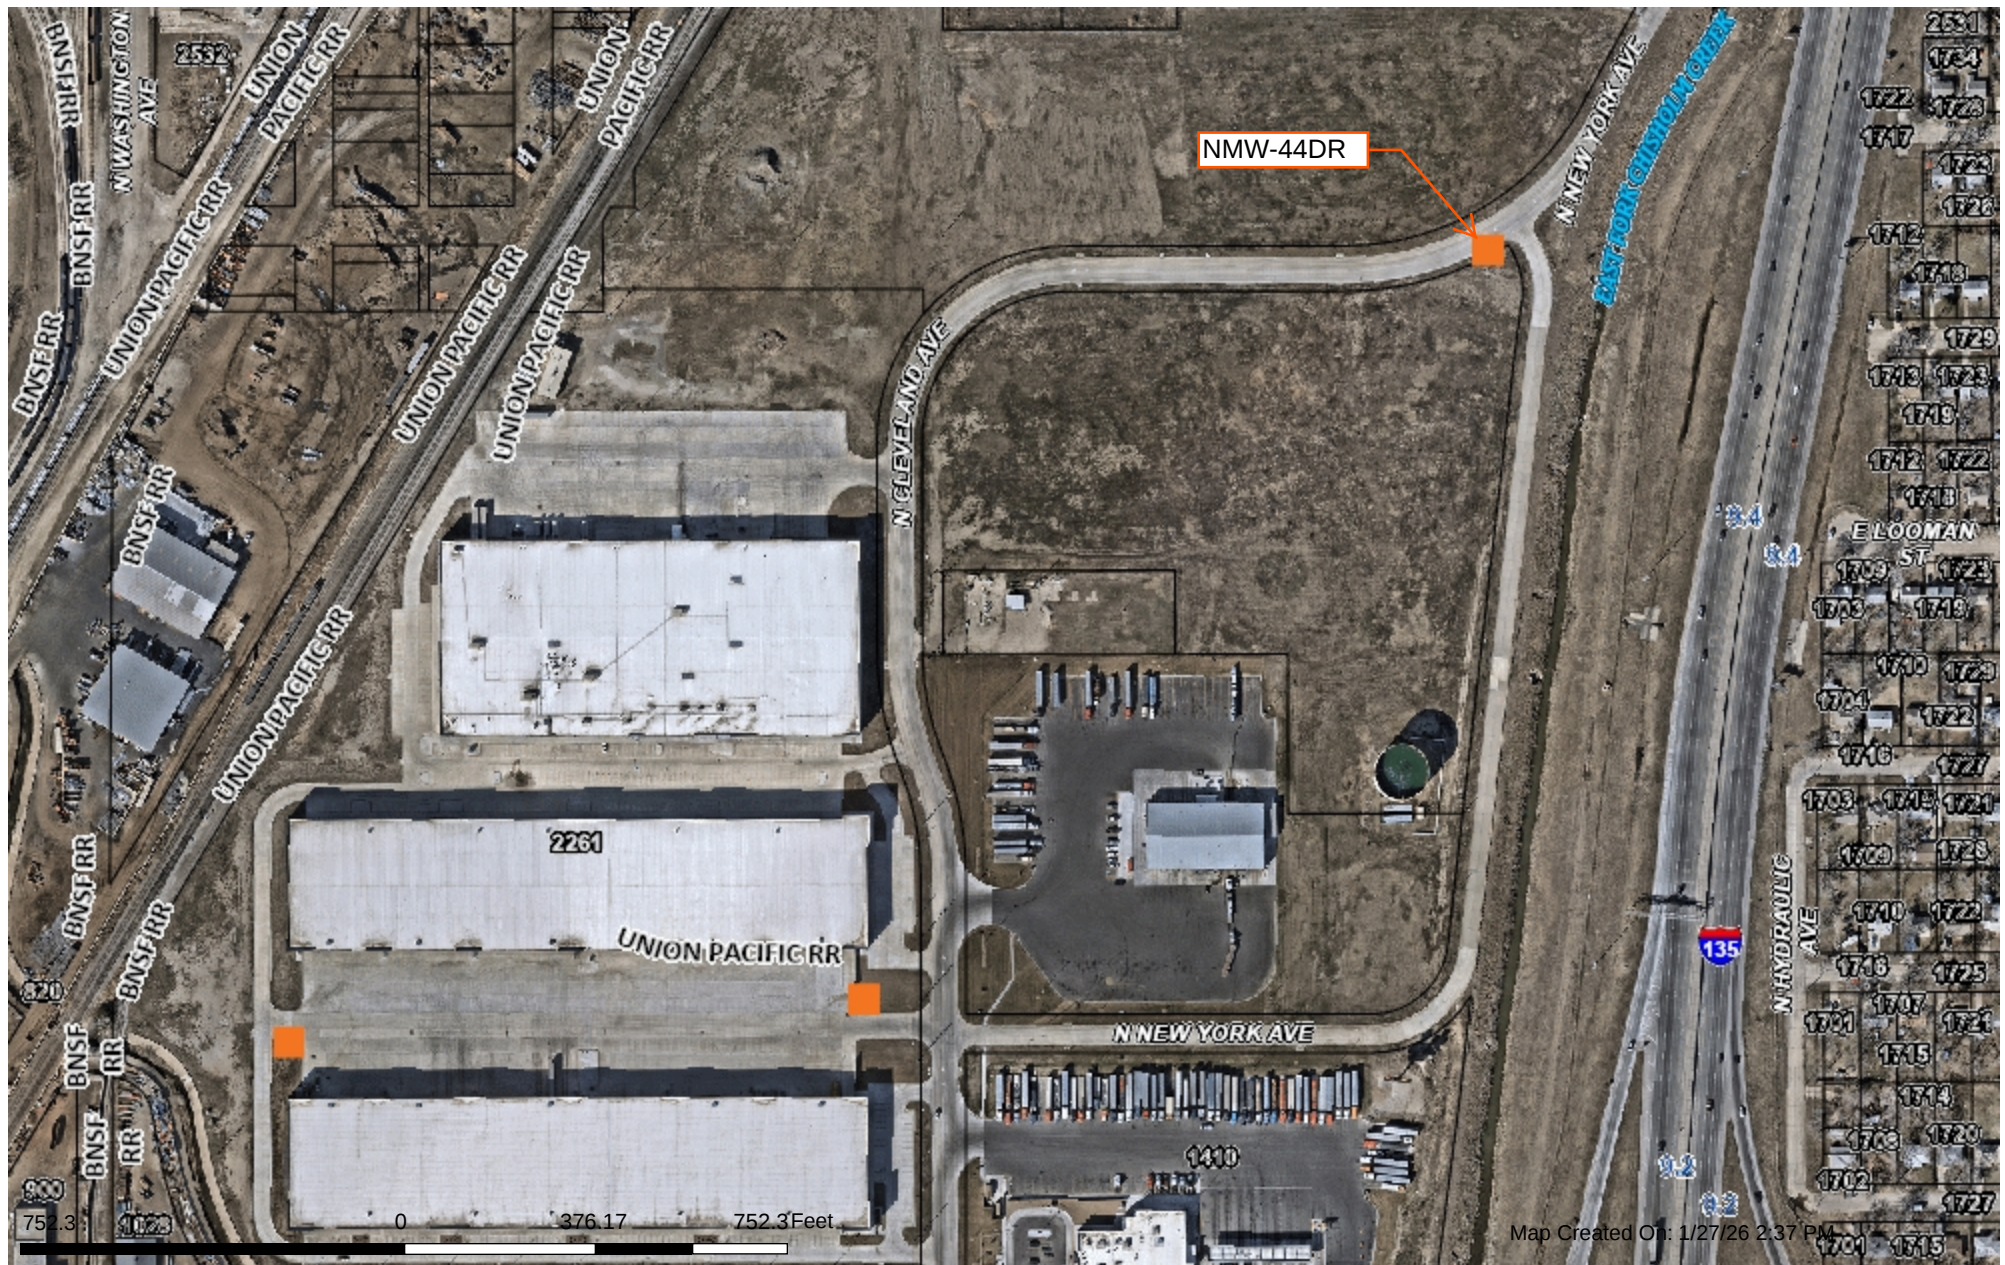

This information is not an official record, and cannot be used as such. The user should rely only upon official records available from the custodian of records in the appropriate City and/or County department. Some data provided here and used for the preparation of these maps has been obtained from public records not created or maintained by the City of Wichita.

1: 4,514



Division of Environment
Curtis State Office Building
1000 SW Jackson St., Suite 400
Topeka, KS 66612-1367



Phone: 785-296-1535
Fax: 785-559-4264
www.kdheks.gov

Janet Stanek, Secretary

Laura Kelly, Governor

May 8, 2026

VIA ELECTRONIC COMMUNICATIONS

Subject: Approval of Variance for Direct-Push Small Diameter Monitoring Wells. North Industrial Corridor (NIC) Site (KDHE Project Code C2-087-70150). Located in SE, Sec. 4, T. 27S, R.1E, Wichita, SG County, KS.

Mike Ocsody, P.G., Ks WWC Lic. 710
Below Ground Surface, Inc.
8110 Cole Parkway
Shawnee, KS 66227
midwestbgs@sbcglobal.net

Dear Mr. Ocsody,

On May 4, 2026, the Kansas Department of Health & Environment, Bureau of Water, Geology & Well Technology Unit, Water Well Program (KDHE), received your variance request to construct three (3) flush-mount, small diameter monitoring wells using direct-push technology (DPT), at the above referenced area under contract with the City of Wichita. The request is to replace three (3) monitoring wells (NMWs 43DR2, 44DR, and 45DR) at the Former El Paso Refinery Site, all to be constructed with less than the required minimum annular space as per K.A.R. 28-30-6(b)(2).

KDHE considers the method of construction described in the request, and method of grouting as proposed in and approved for previous Below Ground Surface variance requests at this site to be adequate.

This letter provides notice of approval to construct three (3) small diameter monitoring wells within the subject area described above. Please comply with KDHE regulations in K.A.R. 28-30-6(s) for flush-mount well completion.

Please contact me at 785-296-3565 (o), 785-224-5259 (c), or Pam.Chaffee@ks.gov if you have questions.

Sincerely,

Pamela Chaffee, P.G., Water Well Program
Geology & Well Technology Unit/Bureau of Water/KDHE

Copy via email: Brooklyn Armijo, KDHE/BOW/GWTU Brooklyn.Armijo@ks.gov
Shreeya Kaphle, KDHE/BOW/GWTU Shreeya.Kaphle@ks.gov

Copy to file: KDHE/BOW/GWTU, Sedgwick County File