

**WATER WELL RECORD (WWC-5)**

Plugged

KOLAR DOC ID \_\_\_\_\_ WELL ID \_\_\_\_\_

**LOCATION OF WATER WELL**

County		Section		Township		Range	E W	Fraction	¼	¼	¼
Latitude		Longitude		Datum		Elevation					

**WATER WELL OWNER**

Name	
Business	
Address	
Well location at owner's address	

**WELL WATER USE**

--

**WELL INFORMATION**

Depth of well:	ft.
Dry well	
Static water level in well:	ft.
measured below land surface on (mm/dd/yy):	
measured above land surface on (mm/dd/yy):	

**PERMIT & ID NUMBERS (AS REQUIRED)**

DWR Application No.:	
KDHE / EPA Project Code:	
Site Name:	
KDHE UIC Class V Form Completed:	Yes No
County/Local Permit Required:	Yes No
Permit Obtained	Yes No Permit ID:
Lease Name & Well #:	
# of Bore Holes:	# of Dewatering Wells

**CASING**

Type of blank casing used:

Casing type details:

Blank casing diameter: \_\_\_\_\_ inches

Was casing removed? Yes No

Top of casing currently \_\_\_\_\_ ft. \_\_\_\_\_ ground

Reason required if top of casing is now less than 5 feet below ground surface for a hand dug well or less than 3 feet below ground surface for all other types of wells.

**GROUT & PLUGGING MATERIALS**

Grout or Plugging interval (ft.)		Material	Description
From	To		

**COMMENTS**

--

**CONTRACTOR'S OR LANDOWNERS CERTIFICATION**

This water well was plugged under my jurisdiction and was completed on (mm/dd/yyyy) \_\_\_\_\_ and this record is true to the best of my knowledge and belief. Kansas Water Well Contractor's License No. \_\_\_\_\_

This water well record was completed on (mm/dd/yyyy) \_\_\_\_\_ under the business name of \_\_\_\_\_

by (electronic signature)

Send one copy to WATER WELL OWNER and retain one for your records.

PLOTTED: 1/5/2023 10:05 AM    SAVED: 1/5/2023 10:01 AM    G:\Projects\278\278-P\278-P1-04\Quarterly\Figure 3.1.dwg




**LEGEND**

- = MONITORING WELL
- = ABANDONED/DESTROYED WELL
- = FORMER & PUMP ISLAND & FUEL LINE LOCATION
- = FORMER UNDERGROUND STORAGE TANKS
- = APPROXIMATE ROW LINES
- (39.98) = BTEX CONCENTRATION, ppb
- = BTEX CONTOUR

**Sampling Date:  
December 6, 2022**

NOTE:  
REMEDIAL WELLS AND WELLS LOCATED SOUTH OF RAILROAD STREET WERE NOT GAUGED OR SAMPLED

PWS-2 = ND;  
PWS-2 IS LOCATED APPROXIMATELY 1000 FEET NE OF THE SITE

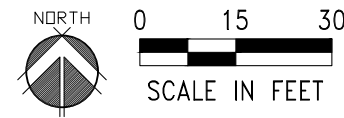

REVISIONS	BY

**MILCO**  
Environmental Services, Inc.  
Kearney, NE (308) 237-5923  
McCook, NE (308) 345-4741  
Colby, KS (785) 460-1956

KENSINGTON COOPERATIVE ASSN.  
**TOTAL BTEX ISOCONCENTRATION MAP**  
 KENSINGTON, KANSAS U6-092-00406

SCALE:	1"=30'
PROJECT NO.	M278-P1-04
DATE:	JANUARY, 2023
FIELD BOOK	M&A DWG NO.
NA	
DRAWN BY:	APR'VD BY:
BSF	
SHEET	

**FIGURE 3.1**

This document, and the ideas and designs incorporated herein, as an instrument of professional service, is the property of MILCO and is not to be used in whole or in part, for any other project without the written authorization of © 2019 MILCO.