

WATER WELL RECORD (WWC5.2)

Constructed

KOLAR DOC ID _____ WELL ID _____

LOCATION OF WATER WELL

County		Section		Township		Range		E W	Fraction	¼	¼	¼
Latitude		Longitude				Datum			Elevation			

WATER WELL LOCATION

at owner's address

WATER WELL OWNER

Name	
Business	
Address	

PERMIT & ID NUMBERS (AS REQUIRED)

DWR Application No.: _____
 KDHE / EPA Project Code: _____
 Site Name: _____
 KDHE UIC Class V Form Completed: Yes No
 County/Local Permit Required? Yes No
 Permit Obtained? Yes No Permit ID: _____
 Oil/Gas Lease Name & Well #: _____

CONSTRUCTION

Casing: Height above land surface: _____ in.
 Is casing height less than 12 inches? Yes No

Blank Casing type: _____
 1st interval: _____ ft. to _____ ft.; Diameter _____ in.
 Casing Joint: : _____ Weight: _____ lbs/ft
 Wall thickness or gauge no.: _____
 2nd interval: _____ ft. to _____ ft.; Diameter _____ in.
 Casing Joint: : _____ Weight: _____ lbs/ft
 Wall thickness or gauge no.: _____
 3rd interval: _____ ft. to _____ ft.; Diameter _____ in.
 Casing Joint: : _____ Weight: _____ lbs/ft
 Wall thickness or gauge no.: _____

Screen / Perforation material: _____

Specify if other: _____

Screen / Perforation openings: _____

1st interval _____ ft. to _____ ft. Slot Size _____

2nd interval _____ ft. to _____ ft. Slot Size _____

3rd interval _____ ft. to _____ ft. Slot Size _____

WELL WATER USE

Additional info if required:

of Boreholes

of Dewatering Wells

COMPLETION

Depth of completed well: _____ ft.

Depth(s) groundwater encountered: Dry Well

(1) _____ ft.; (2) _____ ft.; (3) _____ ft.;

Static water level in well: _____ ft.

Date measured: _____

Measured from: Top of Casing or Ground Surface

Measured: Above or Below Land Surface

Estimated yield: _____ gpm

Pump Test Date: Water level was:

_____ ft. after _____ hours pumping _____ gpm

_____ ft. after _____ hours pumping _____ gpm

Pump Information:

Pump Installed? Yes No Date: _____

Pump Type: Horsepower: Volts:

Drop Pipe Diameter: in. Drop Pipe Length: ft.

Water well disinfected? Yes No

Date disinfected (mm/dd/yy): _____

CONSTRUCTION**Borehole interval:**

from _____ to _____ ft.

from _____ to _____ ft.

from _____ to _____ ft..

Borehole diameter:

_____ in.

_____ in.

_____ in.

Grout:

1st Interval: _____ ft. to _____ ft. Grout material: _____

2nd Interval: _____ ft. to _____ ft. Grout material: _____

3rd Interval: _____ ft. to _____ ft. Grout material: _____

Gravel pack:

Not Used

1st Interval: _____ ft. to _____ ft. Gravel Size: _____

2nd Interval: _____ ft. to _____ ft. Gravel Size: _____

3rd Interval: _____ ft. to _____ ft. Gravel Size: _____

DESIGNATED PERSON**WELL COMPLETION DATE****CONTRACTOR BUSINESS NAME**



ENVIRONMENTAL WORKS
OUR EXPERTISE. YOUR SUCCESS.


ENVIRONMENTAL WORKS INC.

1731 Locust Street
Kansas City, Missouri 64108
Phone: 816-285-8410 Fax: 816-285-8409
www.environmentalworks.com

Project : Capital Railroads
Location : 220, 600, & 180W Front St.
City/State : Bonner Springs, Wyandotte County, Kansas
Drilled By : Mike Gagnon & William Walker
Logged By : Teresa Beck
Drilling Method: Geoprobe - 3230DT
Sampling Method : 5' Continuous Sampler

Project Number : 221672.01
Date Drilled : 5/2/2024
Inspected by : Jake Pfannenstiel
Drafted by : Tab Wyckoff
Boring Depth : 30 ft bgs
Static Water Level : 12 ft bgs
Boring Number: SB-6/MW-6

Legend

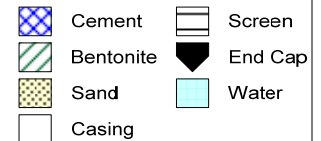


DEPTH BELOW	LITHOLOGIC SYMBOL	LITHOLOGY	SAMPLING AND WELL DATA						
			PID Value	PID (ppm)			Recovery	Sample Interval	Well Construction
		GEOLOGIC DESCRIPTION OF SOIL	0	750	1500				Remarks
0		GRASS, topsoil							0930: Begin drilling
1		SILT, with clay, moist, soft, medium plasticity, dark brown (7.5YR 3/2)	0.1						
2			0.1				4.1 / 5.0		
3			0.0						
4		CLAY, with silt, moist, medium/stiff, high plasticity, brown (7.5YR 4/3)	0.0						
5			0.0						
6		CLAY, little silt, moist/damp, stiff, high plasticity, brown (7.5YR 4/3)	0.0						
7			0.0				6.0 / 5.0		
8			0.0						
9			0.0						
10		Becomes moist, medium consistency	0.0						
11		CLAY, little silt, very moist, soft-medium, high plasticity, brown (7.5YR 4/4)	1.2					SB-6/M W-6: 10-11' @ 1015	
12		Becomes wet	0.1				6.0 / 5.0		
13			0.0						
14		CLAY, little silt, some fine sand nodules, moist, medium consistency, high plasticity, (5Y 5/2) with brown mottling	0.0						
15									

Notes :

Drilled By : Mike Gagnon & William Walker
 Logged By : Teresa Beck
 Drilling Method: Geoprobe - 3230DT
 Sampling Method : 5' Continuous Sampler

Drafted by : Tab Wyckoff
 Boring Depth : 30 ft bgs
 Static Water Level : 12 ft bgs
 Boring Number: SB-6/MW-6

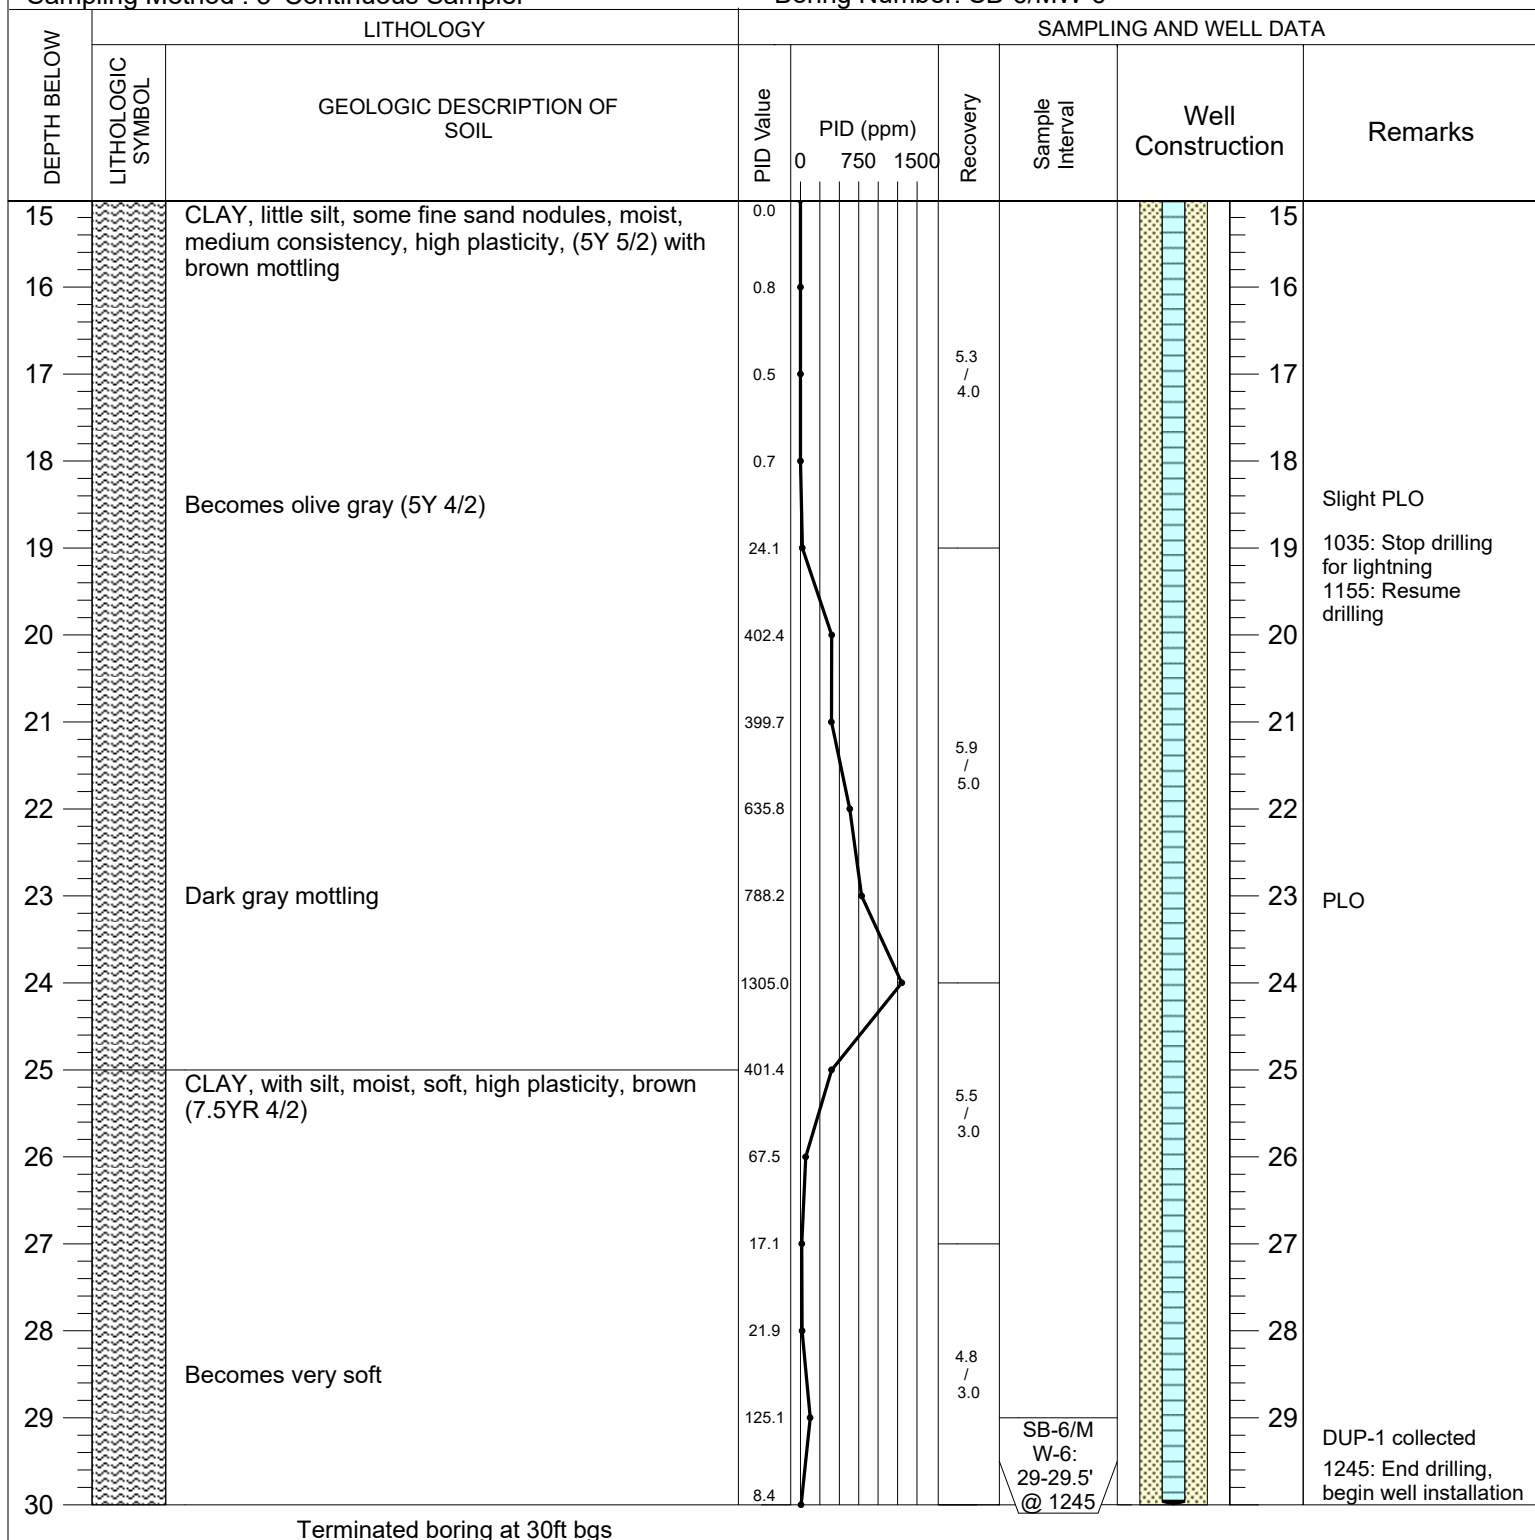

Notes :