

**WATER WELL RECORD (WWC5.2)**

Constructed

KOLAR DOC ID \_\_\_\_\_ WELL ID \_\_\_\_\_

**LOCATION OF WATER WELL**

|          |  |           |  |          |  |       |  |        |           |   |   |   |
|----------|--|-----------|--|----------|--|-------|--|--------|-----------|---|---|---|
| County   |  | Section   |  | Township |  | Range |  | E<br>W | Fraction  | ¼ | ¼ | ¼ |
| Latitude |  | Longitude |  |          |  | Datum |  |        | Elevation |   |   |   |

**WATER WELL LOCATION**

at owner's address

**WATER WELL OWNER**

|          |  |
|----------|--|
| Name     |  |
| Business |  |
| Address  |  |

**PERMIT & ID NUMBERS (AS REQUIRED)**

DWR Application No.: \_\_\_\_\_  
 KDHE / EPA Project Code: \_\_\_\_\_  
 Site Name: \_\_\_\_\_  
 KDHE UIC Class V Form Completed: Yes No  
 County/Local Permit Required? Yes No  
 Permit Obtained? Yes No Permit ID: \_\_\_\_\_  
 Oil/Gas Lease Name & Well #: \_\_\_\_\_

**CONSTRUCTION**

**Casing:** Height above land surface: \_\_\_\_\_ in.  
 Is casing height less than 12 inches? Yes No

Blank Casing type: \_\_\_\_\_  
 1st interval: \_\_\_\_\_ ft. to \_\_\_\_\_ ft.; Diameter \_\_\_\_\_ in.  
 Casing Joint: : \_\_\_\_\_ Weight: \_\_\_\_\_ lbs/ft  
 Wall thickness or gauge no.: \_\_\_\_\_  
 2nd interval: \_\_\_\_\_ ft. to \_\_\_\_\_ ft.; Diameter \_\_\_\_\_ in.  
 Casing Joint: : \_\_\_\_\_ Weight: \_\_\_\_\_ lbs/ft  
 Wall thickness or gauge no.: \_\_\_\_\_  
 3rd interval: \_\_\_\_\_ ft. to \_\_\_\_\_ ft.; Diameter \_\_\_\_\_ in.  
 Casing Joint: : \_\_\_\_\_ Weight: \_\_\_\_\_ lbs/ft  
 Wall thickness or gauge no.: \_\_\_\_\_

**Screen / Perforation material:** \_\_\_\_\_

Specify if other: \_\_\_\_\_

Screen / Perforation openings: \_\_\_\_\_

1st interval \_\_\_\_\_ ft. to \_\_\_\_\_ ft. Slot Size \_\_\_\_\_

2nd interval \_\_\_\_\_ ft. to \_\_\_\_\_ ft. Slot Size \_\_\_\_\_

3rd interval \_\_\_\_\_ ft. to \_\_\_\_\_ ft. Slot Size \_\_\_\_\_

**WELL WATER USE**

Additional info if required:

# of Boreholes

# of Dewatering Wells

**COMPLETION**

Depth of completed well: \_\_\_\_\_ ft.

Depth(s) groundwater encountered: Dry Well

(1) \_\_\_\_\_ ft.; (2) \_\_\_\_\_ ft.; (3) \_\_\_\_\_ ft.;

Static water level in well: \_\_\_\_\_ ft.

Date measured: \_\_\_\_\_

Measured from: Top of Casing or Ground Surface

Measured: Above or Below Land Surface

Estimated yield: \_\_\_\_\_ gpm

Pump Test Date: Water level was:

\_\_\_\_\_ ft. after \_\_\_\_\_ hours pumping \_\_\_\_\_ gpm

\_\_\_\_\_ ft. after \_\_\_\_\_ hours pumping \_\_\_\_\_ gpm

**Pump Information:**

Pump Installed? Yes No Date: \_\_\_\_\_

Pump Type: Horsepower: Volts:

Drop Pipe Diameter: in. Drop Pipe Length: ft.

Water well disinfected? Yes No

Date disinfected (mm/dd/yy): \_\_\_\_\_

**CONSTRUCTION****Borehole interval:**

from \_\_\_\_\_ to \_\_\_\_\_ ft.

from \_\_\_\_\_ to \_\_\_\_\_ ft.

from \_\_\_\_\_ to \_\_\_\_\_ ft..

**Borehole diameter:**

\_\_\_\_\_ in.

\_\_\_\_\_ in.

\_\_\_\_\_ in.

**Grout:**

1st Interval: \_\_\_\_\_ ft. to \_\_\_\_\_ ft. Grout material: \_\_\_\_\_

2nd Interval: \_\_\_\_\_ ft. to \_\_\_\_\_ ft. Grout material: \_\_\_\_\_

3rd Interval: \_\_\_\_\_ ft. to \_\_\_\_\_ ft. Grout material: \_\_\_\_\_

**Gravel pack:**

Not Used

1st Interval: \_\_\_\_\_ ft. to \_\_\_\_\_ ft. Gravel Size: \_\_\_\_\_

2nd Interval: \_\_\_\_\_ ft. to \_\_\_\_\_ ft. Gravel Size: \_\_\_\_\_

3rd Interval: \_\_\_\_\_ ft. to \_\_\_\_\_ ft. Gravel Size: \_\_\_\_\_

**DESIGNATED PERSON****WELL COMPLETION DATE****CONTRACTOR BUSINESS NAME**

### LOCATION OF WATER WELL

|            |  |           |  |                     |       |       |               |           |               |               |               |
|------------|--|-----------|--|---------------------|-------|-------|---------------|-----------|---------------|---------------|---------------|
| County     |  | Section   |  | Township            |       | Range | $\frac{E}{W}$ | Fraction  | $\frac{1}{4}$ | $\frac{1}{4}$ | $\frac{1}{4}$ |
| Latitude   |  | Longitude |  |                     | Datum |       |               | Elevation |               |               |               |
| Well Owner |  |           |  | Well Owner Business |       |       |               |           |               |               |               |

|                                                  |    |                                                     |
|--------------------------------------------------|----|-----------------------------------------------------|
| <b>NEAREST SOURCE OF POTENTIAL CONTAMINATION</b> | or | No potential source of contamination within 100 ft. |
|--------------------------------------------------|----|-----------------------------------------------------|

|                                        |     |                      |  |                                        |     |                      |  |
|----------------------------------------|-----|----------------------|--|----------------------------------------|-----|----------------------|--|
| Source:                                |     |                      |  | Source:                                |     |                      |  |
| Distance from well (ft):               |     | Direction from well: |  | Distance from well (ft):               |     | Direction from well: |  |
| Source description:                    |     |                      |  | Source description:                    |     |                      |  |
| Required information for local entity? | Yes | No                   |  | Required information for local entity? | Yes | No                   |  |

## LITHOLOGIC LOG


**AQUIFER, if known**[illegible]

## COMMENTS

This water well was constructed/reconstructed pursuant to the stated water well contractor's license and was completed on \_\_\_\_\_.

I certify that this record is true to the best of my knowledge and belief. This water well record was completed on \_\_\_\_\_ under the business name of \_\_\_\_\_, KS Water Well Contractor's License No. \_\_\_\_\_ under the authority of the designated person as defined in K.A.R. 28-30-2(j) and signed and certified by the electronic signature of the designated person at its submittal: \_\_\_\_\_.

Send one copy to the water well owner and the contractor should retain one copy.

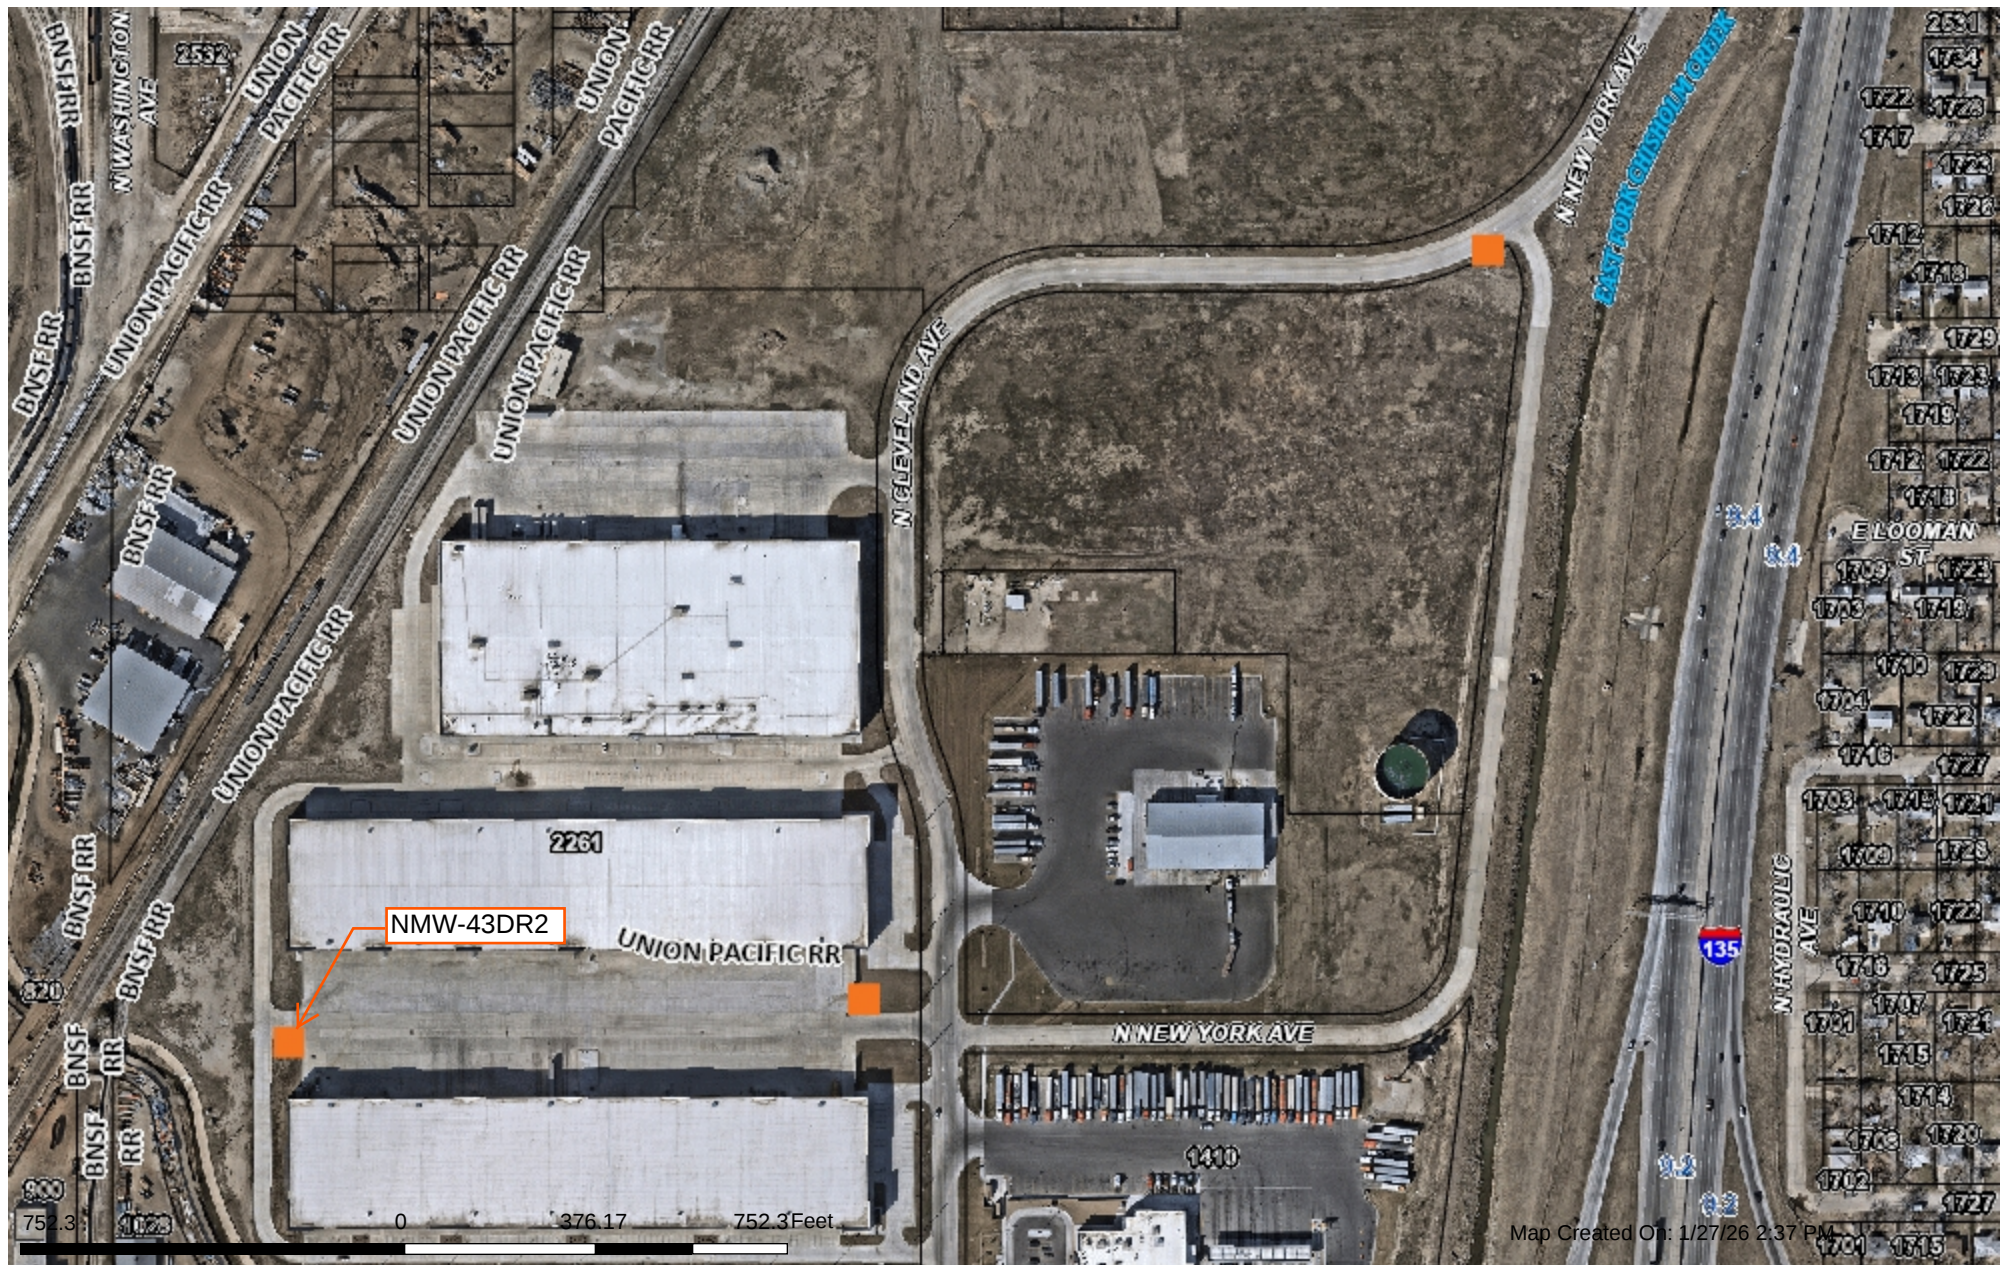

This information is not an official record, and cannot be used as such. The user should rely only upon official records available from the custodian of records in the appropriate City and/or County department. Some data provided here and used for the preparation of these maps has been obtained from public records not created or maintained by the City of Wichita.

1: 4,514



Division of Environment  
Curtis State Office Building  
1000 SW Jackson St., Suite 400  
Topeka, KS 66612-1367



Phone: 785-296-1535  
Fax: 785-559-4264  
[www.kdheks.gov](http://www.kdheks.gov)

Janet Stanek, Secretary

Laura Kelly, Governor

May 8, 2026

VIA ELECTRONIC COMMUNICATIONS

Subject: Approval of Variance for Direct-Push Small Diameter Monitoring Wells. North Industrial Corridor (NIC) Site (KDHE Project Code C2-087-70150). Located in SE, Sec. 4, T. 27S, R.1E, Wichita, SG County, KS.

Mike Ocsody, P.G., Ks WWC Lic. 710  
Below Ground Surface, Inc.  
8110 Cole Parkway  
Shawnee, KS 66227  
[midwestbgs@sbcglobal.net](mailto:midwestbgs@sbcglobal.net)

Dear Mr. Ocsody,

On May 4, 2026, the Kansas Department of Health & Environment, Bureau of Water, Geology & Well Technology Unit, Water Well Program (KDHE), received your variance request to construct three (3) flush-mount, small diameter monitoring wells using direct-push technology (DPT), at the above referenced area under contract with the City of Wichita. The request is to replace three (3) monitoring wells (NMWs 43DR2, 44DR, and 45DR) at the Former El Paso Refinery Site, all to be constructed with less than the required minimum annular space as per K.A.R. 28-30-6(b)(2).

KDHE considers the method of construction described in the request, and method of grouting as proposed in and approved for previous Below Ground Surface variance requests at this site to be adequate.

This letter provides notice of approval to construct three (3) small diameter monitoring wells within the subject area described above. Please comply with KDHE regulations in K.A.R. 28-30-6(s) for flush-mount well completion.

Please contact me at 785-296-3565 (o), 785-224-5259 (c), or [Pam.Chaffee@ks.gov](mailto:Pam.Chaffee@ks.gov) if you have questions.

Sincerely,

Pamela Chaffee, P.G., Water Well Program  
Geology & Well Technology Unit/Bureau of Water/KDHE

Copy via email: Brooklyn Armijo, KDHE/BOW/GWTU [Brooklyn.Armijo@ks.gov](mailto:Brooklyn.Armijo@ks.gov)  
Shreeya Kaphle, KDHE/BOW/GWTU [Shreeya.Kaphle@ks.gov](mailto:Shreeya.Kaphle@ks.gov)

Copy to file: KDHE/BOW/GWTU, Sedgwick County File