WATER WELL RECORD (WWC5.2)

Constructed

KOLAR DOC ID 1970657 WELL ID ARM Well W4-15

LOCATION OF WATER WELL

County	Wyandotte	Section	10	Township	11	Range	25	✓E W	Fraction	SE ¼	SW ¼	SE ¼	
Latitude	39.102747	Longitude	-94.61729	Datum	WGS84	Elevation	745						

WATER WELL LOCATION

☐ at owner's address

Well W-4-15 is located 168 feet N of CL of Central Ave , and 258 feet Southwest of Kansas River.

WATER WELL OWNER

Name	
Business	KAW Valley Drainage District
Address	719 Osage Ave Kansas City KS 66105

PERMIT & ID NUMBERS (AS REQUIRED)

DWR Application No.:

KDHE / EPA Project Code:

Site Name:

KDHE UIC Class V Form Completed: ☐ Yes ☐ No

County/Local Permit Required? ☐ Yes ☐ No

Permit Obtained? ☐ Yes ☐ No Permit ID:

Oil/Gas Lease Name & Well #:

CONSTRUCTION

Casing: Height above land surface: 12 in.

Is casing height less than 12 inches? ☐ Yes ☑ No

Blank Casing type: StainlessSteel

1st interval: 0 ft. to 48.6 ft.; Diameter 12.75 in.

Casing Joint: : Splines Weight: 49.50 lbs/ft

Wall thickness or gauge no.: Sch 40

2nd interval: ____ ft. to ____ ft.; Diameter ____ in.

Casing Joint: : ____ Weight: ____ lbs/ft

Wall thickness or gauge no.: ____

3rd interval: ____ ft. to ____ ft.; Diameter ____ in.

Casing Joint: : ____ Weight: ____ lbs/ft

Wall thickness or gauge no.: ____

Screen / Perforation material: Stainless steel

Specify if other:

Screen / Perforation openings: Wire wrapped

1st interval 48.6 ft. to 64.6 ft. Slot Size .04 inches

2nd interval ____ ft. to ____ ft. Slot Size ____ ____

3rd interval ____ ft. to ____ ft. Slot Size ____ ____

WELL WATER USE

Other Levee Pressure Relief Well

Additional info if required: Levee Pressure Relief Well

# of Boreholes # of Dewatering Wells

COMPLETION

Depth of completed well: 64.6 ft.

Depth(s) groundwater encountered: ☐ Dry Well

(1) 33.5 ft.; (2) ____ ft.; (3) ____ ft.;

Static water level in well: 33.5 ft.

Date measured: 03/19/2026

Measured from: ✓ Top of Casing or ☐ Ground Surface

Measured: ☐ Above or ☑ Below Land Surface

Estimated yield: 466 gpm

Pump Test Date: Water level was:

48.4 ft. after 2.7 hours pumping ____ gpm

____ ft. after ____ hours pumping ____ gpm

Pump Information:

Pump Installed? ☐ Yes ☑ No Date:

Pump Type: Horsepower: Volts:

Drop Pipe Diameter: in. Drop Pipe Length: ft.

Water well disinfected? ✓ Yes ☐ No

Date disinfected (mm/dd/yy): 03/23/2026

CONSTRUCTION

Borehole interval:

from 0 to 64.6 ft.

from ____ to ____ ft.

from ____ to ____ ft..

Borehole diameter:

24 in.

____ in.

____ in.

Grout:

1st Interval: 1 ft. to 21 ft. Grout material: Neat Cement

2nd Interval: ____ ft. to ____ ft. Grout material:

3rd Interval: ____ ft. to ____ ft. Grout material:

Gravel pack: Not Used

1st Interval: 21 ft. to 64.6 ft. Gravel Size: 0.2 ☐

2nd Interval: ____ ft. to ____ ft. Gravel Size: ____ ☐

3rd Interval: ____ ft. to ____ ft. Gravel Size: ____ ☐

DESIGNATED PERSON Stephen Seliga

WELL COMPLETION DATE 03/23/2026

CONTRACTOR BUSINESS NAME Griffin Dewatering, LLC

KANSAS DEPARTMENT OF HEALTH AND ENVIRONMENT
Bureau of Water, Geology Section, 1000 SW Jackson St., Suite 420, Topeka KS 66612-1367

WATER WELL RECORD (WWC-5) Constructed KOLAR DOC ID 1970657 WELL ID ARM Well W4-15

LOCATION OF WATER WELL

County	Wyandotte	Section	10	Township	11	Range	25	☑E ☐W	Fraction	SE ¼ SW ¼ SE ¼		
Latitude	39.102747	Longitude	-94.61729			Datum	WGS84		Elevation	745		
Well Owner				Well Owner Business		KAW Valley Drainage District						

NEAREST SOURCE OF POTENTIAL CONTAMINATION or ✓ No potential source of contamination within 100 ft.

Source:	Source:
Distance from well (ft): Direction from well:	Distance from well (ft): Direction from well:
Source description:	Source description:
Required information for local entity? ☐ Yes ☐ No	Required information for local entity? ☐ Yes ☐ No

LITHOLOGIC LOG **AQUIFER, if known** Alluvial

FROM	TO	LITHOLOGY
0	1	fill (man-made material),very fine,clayey,dark,brown,dry,loose
1	7	fill (man-made material),very fine,silty,dark,blueish,gray,dry,soft
7	12.5	silt,very fine,clayey,dark,blueish,gray,dry,firm
12.5	14	clay,very fine,dark,grayish,gray,dry,firm
14	20	sand,fine,clayey,light,yellowish,brown,dry,firm
20	25	sand,fine,clayey,light,yellowish,brown,dry,firm
25	32	sand,fine,clayey,dark,yellowish,brown,very moist
32	35	sand,fine,clayey,dark,yellowish,brown,saturated
35	42	clay,very fine,sandy,dark,grayish,brown,saturated
42	48	sand,fine,clayey,dark,grayish,brown,saturated
48	52	clay,very fine,sandy,dark,grayish,gray,saturated
52	67	sand,fine to medium,silty,dark,grayish,gray,saturated

COMMENTS

Referenced elevations are from TOC EL of 745.0, TOC elevation is ~ 0.5' feet below TO manhole lid at EL. 745.5 amsl. A 34" casing was used and removed.

This water well was constructed ☐ reconstructed pursuant to the stated water well contractor's license and was completed on 03/23/2026 . I certify that this record is true to the best of my knowledge and belief. This water well rcord was completed on 06/29/2026 under the business name of Griffin Dewatering, LLC , KS Water Well Contractor's License No. 509 under the authority of the designated person as defined in K.A.R. 28-30-2(j) and signed and certified by the electronic signature of the designated person at its submittal: Stephen Seliga . Send one copy to the water well owner and the contractor should retain one copy.

FINAL

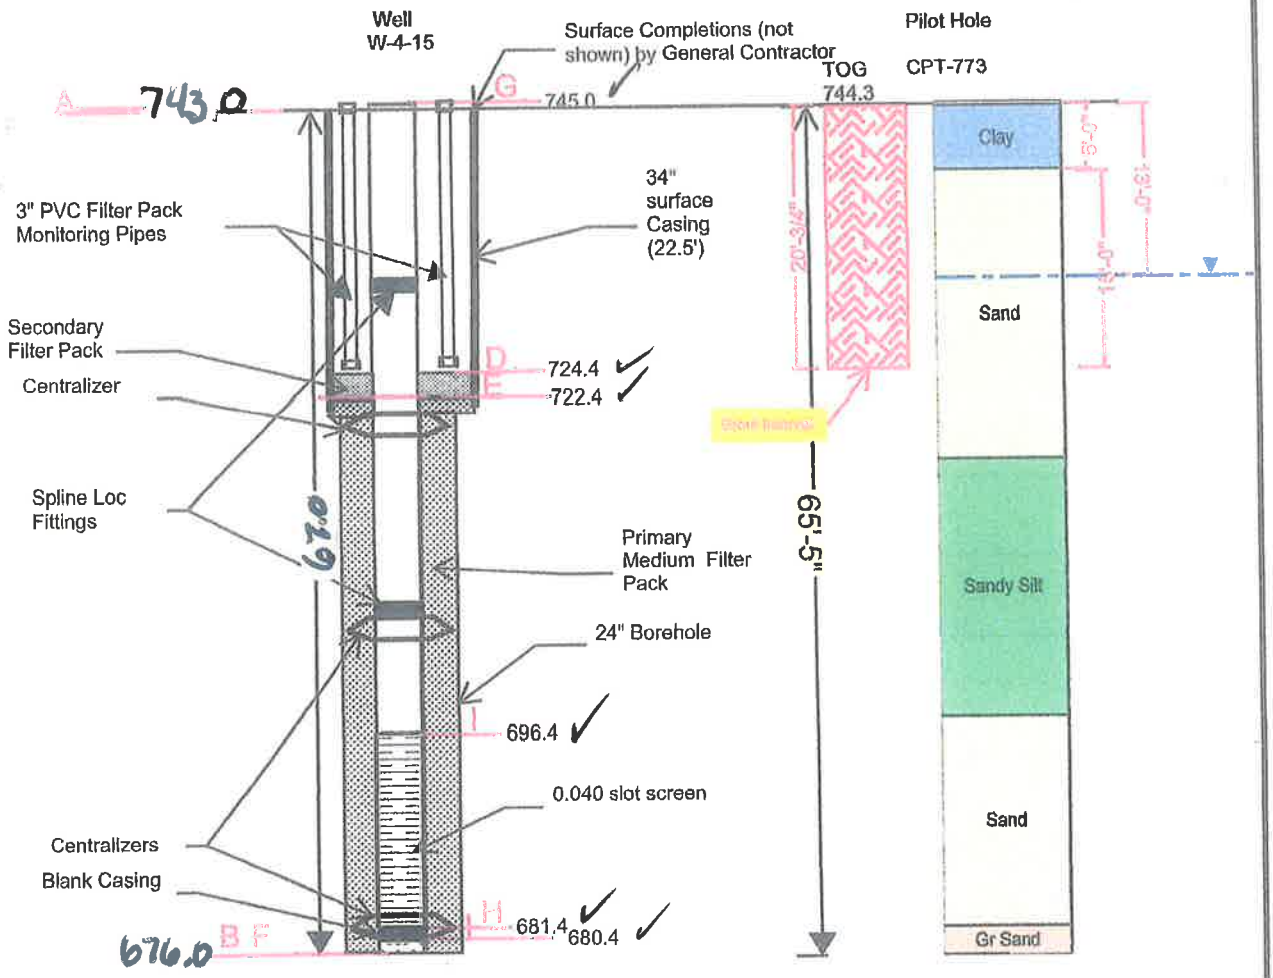

NOTES:
1. ALL PIPE IS 12" - 304 STAINLESS STEEL
2. CASING IS SCH. 40
3. SCREEN SLOT IS AS SHOWN
4. DRAWING IS N.T.S.

COUPLINGS WILL BE SPLINE LOC
ALL CONNECTIONS WELDED AT FACTORY

KC Relief Wells ARM Unit W-4-15	
GRIFFIN	Figure 104
Drawn By: SAS	Date: 5.16.2023

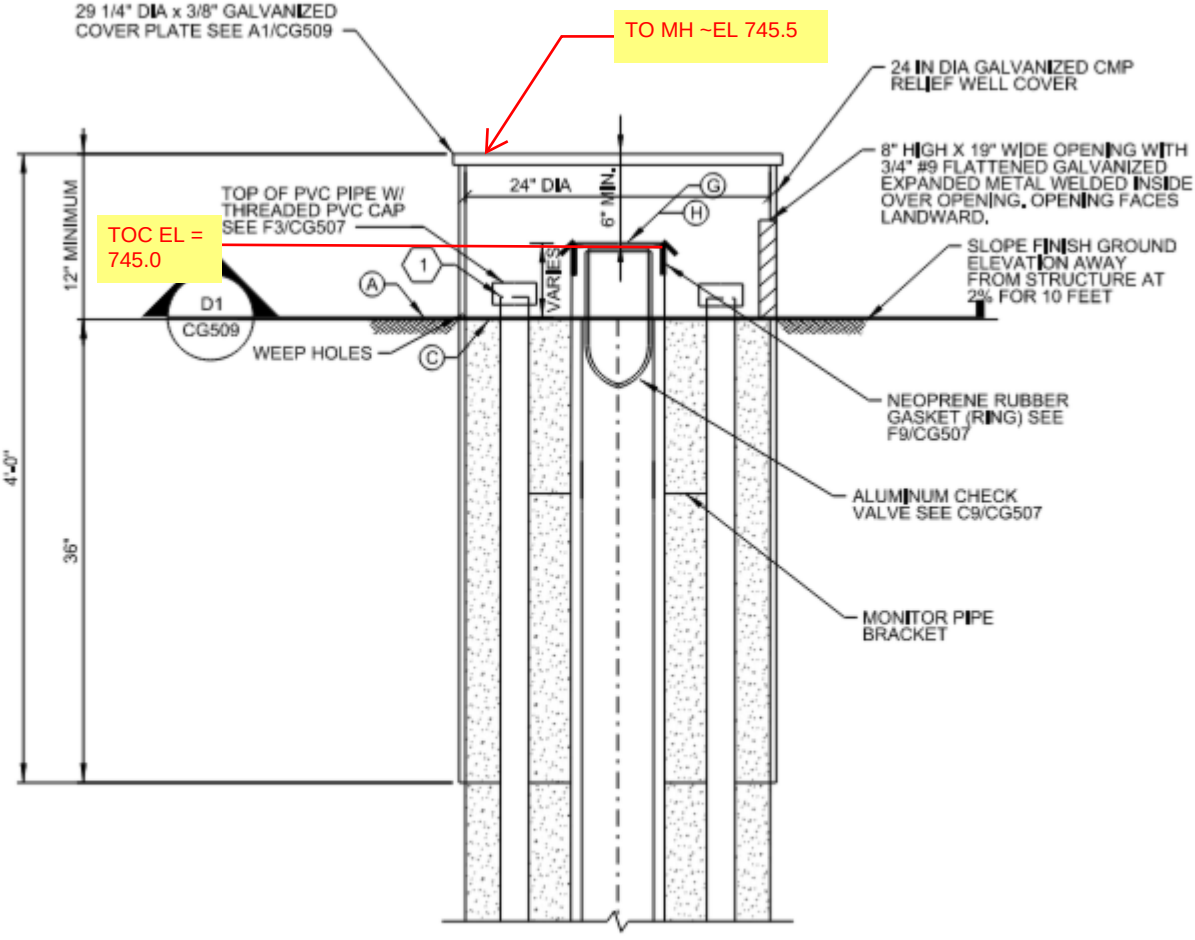

D8 RELIEF WELL WITH COVER PLATE

SCALE: NTS

N 4th St
ARM Well W-4-15
Central Ave Bridge
TRUX