

**WATER WELL RECORD (WWC5.2)**

Constructed

KOLAR DOC ID \_\_\_\_\_ WELL ID \_\_\_\_\_

**LOCATION OF WATER WELL**

|          |  |           |  |          |  |           |  |        |          |   |   |   |
|----------|--|-----------|--|----------|--|-----------|--|--------|----------|---|---|---|
| County   |  | Section   |  | Township |  | Range     |  | E<br>W | Fraction | ¼ | ¼ | ¼ |
| Latitude |  | Longitude |  | Datum    |  | Elevation |  |        |          |   |   |   |

**WATER WELL LOCATION**

at owner's address

**WATER WELL OWNER**

|          |  |
|----------|--|
| Name     |  |
| Business |  |
| Address  |  |

**PERMIT & ID NUMBERS (AS REQUIRED)**

DWR Application No.: \_\_\_\_\_

KDHE / EPA Project Code: \_\_\_\_\_

Site Name: \_\_\_\_\_

KDHE UIC Class V Form Completed: Yes No

County/Local Permit Required? Yes No

Permit Obtained? Yes No Permit ID: \_\_\_\_\_

Oil/Gas Lease Name & Well #: \_\_\_\_\_

**CONSTRUCTION**

**Casing:** Height above land surface: \_\_\_\_\_ in.

Is casing height less than 12 inches? Yes No

Blank Casing type: \_\_\_\_\_

1st interval: \_\_\_\_\_ ft. to \_\_\_\_\_ ft.; Diameter \_\_\_\_\_ in.

Casing Joint: : \_\_\_\_\_ Weight: \_\_\_\_\_ lbs/ft

Wall thickness or gauge no.: \_\_\_\_\_

2nd interval: \_\_\_\_\_ ft. to \_\_\_\_\_ ft.; Diameter \_\_\_\_\_ in.

Casing Joint: : \_\_\_\_\_ Weight: \_\_\_\_\_ lbs/ft

Wall thickness or gauge no.: \_\_\_\_\_

3rd interval: \_\_\_\_\_ ft. to \_\_\_\_\_ ft.; Diameter \_\_\_\_\_ in.

Casing Joint: : \_\_\_\_\_ Weight: \_\_\_\_\_ lbs/ft

Wall thickness or gauge no.: \_\_\_\_\_

**Screen / Perforation material:** \_\_\_\_\_

Specify if other: \_\_\_\_\_

Screen / Perforation openings: \_\_\_\_\_

1st interval \_\_\_\_\_ ft. to \_\_\_\_\_ ft. Slot Size \_\_\_\_\_

2nd interval \_\_\_\_\_ ft. to \_\_\_\_\_ ft. Slot Size \_\_\_\_\_

3rd interval \_\_\_\_\_ ft. to \_\_\_\_\_ ft. Slot Size \_\_\_\_\_

**WELL WATER USE**

Additional info if required:

# of Boreholes

# of Dewatering Wells

**COMPLETION**

Depth of completed well: \_\_\_\_\_ ft.

Depth(s) groundwater encountered: Dry Well

(1) \_\_\_\_\_ ft.; (2) \_\_\_\_\_ ft.; (3) \_\_\_\_\_ ft.;

Static water level in well: \_\_\_\_\_ ft.

Date measured: \_\_\_\_\_

Measured from: Top of Casing or Ground Surface

Measured: Above or Below Land Surface

Estimated yield: \_\_\_\_\_ gpm

Pump Test Date: Water level was:

\_\_\_\_\_ ft. after \_\_\_\_\_ hours pumping \_\_\_\_\_ gpm

\_\_\_\_\_ ft. after \_\_\_\_\_ hours pumping \_\_\_\_\_ gpm

**Pump Information:**

Pump Installed? Yes No Date: \_\_\_\_\_

Pump Type: Horsepower: Volts:

Drop Pipe Diameter: in. Drop Pipe Length: ft.

Water well disinfected? Yes No

Date disinfected (mm/dd/yy): \_\_\_\_\_

**CONSTRUCTION****Borehole interval:**

from \_\_\_\_\_ to \_\_\_\_\_ ft.

from \_\_\_\_\_ to \_\_\_\_\_ ft.

from \_\_\_\_\_ to \_\_\_\_\_ ft..

**Borehole diameter:**

\_\_\_\_\_ in.

\_\_\_\_\_ in.

\_\_\_\_\_ in.

**Grout:**

1st Interval: \_\_\_\_\_ ft. to \_\_\_\_\_ ft. Grout material: \_\_\_\_\_

2nd Interval: \_\_\_\_\_ ft. to \_\_\_\_\_ ft. Grout material: \_\_\_\_\_

3rd Interval: \_\_\_\_\_ ft. to \_\_\_\_\_ ft. Grout material: \_\_\_\_\_

**Gravel pack:**

Not Used

1st Interval: \_\_\_\_\_ ft. to \_\_\_\_\_ ft. Gravel Size: \_\_\_\_\_

2nd Interval: \_\_\_\_\_ ft. to \_\_\_\_\_ ft. Gravel Size: \_\_\_\_\_

3rd Interval: \_\_\_\_\_ ft. to \_\_\_\_\_ ft. Gravel Size: \_\_\_\_\_

**DESIGNATED PERSON****WELL COMPLETION DATE****CONTRACTOR BUSINESS NAME**

### LOCATION OF WATER WELL

|            |  |           |  |                     |  |       |                           |           |               |               |               |
|------------|--|-----------|--|---------------------|--|-------|---------------------------|-----------|---------------|---------------|---------------|
| County     |  | Section   |  | Township            |  | Range | <sup>E</sup> <sub>W</sub> | Fraction  | $\frac{1}{4}$ | $\frac{1}{4}$ | $\frac{1}{4}$ |
| Latitude   |  | Longitude |  |                     |  | Datum |                           | Elevation |               |               |               |
| Well Owner |  |           |  | Well Owner Business |  |       |                           |           |               |               |               |

|                                                  |    |                                                     |
|--------------------------------------------------|----|-----------------------------------------------------|
| <b>NEAREST SOURCE OF POTENTIAL CONTAMINATION</b> | or | No potential source of contamination within 100 ft. |
|--------------------------------------------------|----|-----------------------------------------------------|

|                                        |                      |    |                                        |                      |    |
|----------------------------------------|----------------------|----|----------------------------------------|----------------------|----|
| Source:                                |                      |    | Source:                                |                      |    |
| Distance from well (ft):               | Direction from well: |    | Distance from well (ft):               | Direction from well: |    |
| Source description:                    |                      |    | Source description:                    |                      |    |
| Required information for local entity? | Yes                  | No | Required information for local entity? | Yes                  | No |

## LITHOLOGIC LOG

**AQUIFER, if known**[illegible]


### COMMENTS

This water well was constructed/reconstructed pursuant to the stated water well contractor's license and was completed on \_\_\_\_\_.

I certify that this record is true to the best of my knowledge and belief. This water well record was completed on \_\_\_\_\_ under the business name of \_\_\_\_\_, KS Water Well Contractor's License No. \_\_\_\_\_ under the authority of the designated person as defined in K.A.R. 28-30-2(j) and signed and certified by the electronic signature of the designated person at its submittal: \_\_\_\_\_.

Send one copy to the water well owner and the contractor should retain one copy.

FINAL

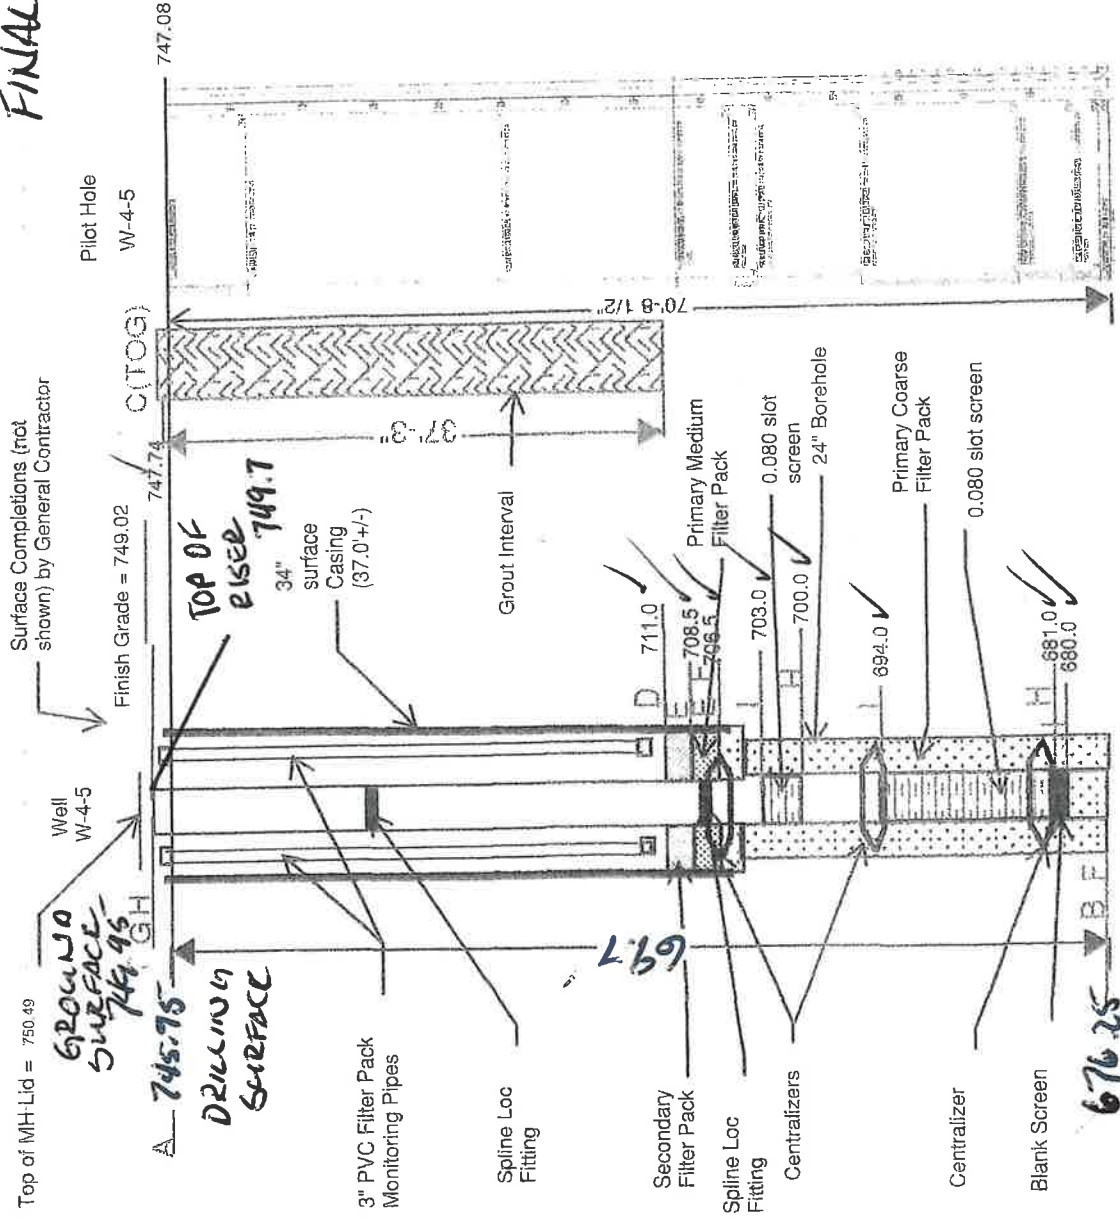

Revised per RFI #288

Note: Primary Coarse Filter Pack to be added to Filter Pack Monitoring Pipes

| PUMP TEST RATES              |        |        |        |  |
|------------------------------|--------|--------|--------|--|
| ALL WELLS EXCEPT WELLS BELOW |        |        |        |  |
| STEP 1                       | STEP 2 | STEP 3 | STEP 4 |  |
| 200                          | 300    | 400    | 500    |  |

- NOTES:
1. ALL PIPE IS 12" - 304 STAINLESS STEEL
  2. CASING IS SCH. 40
  3. SCREEN SLOT IS AS SHOWN
  4. DRAWING IS N.T.S.

**KC Relief Wells**  
**ARM Unit**  
W-4-5

**GRIFFIN**

Figure 119

Drawn By: SAS      Date: 06.11.2025

COUPLINGS WILL BE SPLINE LOC ALL CONNECTIONS WELDED AT FACTORY

TO MH ~EL 750.49

TOC EL =  
749.7

- 8" HIGH X 19" WIDE OPENING WITH  
3/4" #9 FLATTENED GALVANIZED  
EXPANDED METAL WELDED INSIDE  
OVER OPENING. OPENING FACES  
LANDWARD.

## WEEP HOLES

- ALUMINUM CHECK VALVE SEE C9/CG507

- MONITOR PIPE  
BRACKET

## RELIEF WELL WITH COVER PLATE

SCALE: NTS

ARM Well W-4-5

Arm Well W-4-4

ecturing

N39°05'58.56"  
ARM Well W-4-3  
W 94°36'54.72"

ARM Well W-4-2

ARM Well W-4-1

1A

670