

**WATER WELL RECORD (WWC5.2)**

Constructed

KOLAR DOC ID \_\_\_\_\_ WELL ID \_\_\_\_\_

**LOCATION OF WATER WELL**

|          |  |           |  |          |  |           |  |        |          |   |   |   |
|----------|--|-----------|--|----------|--|-----------|--|--------|----------|---|---|---|
| County   |  | Section   |  | Township |  | Range     |  | E<br>W | Fraction | ¼ | ¼ | ¼ |
| Latitude |  | Longitude |  | Datum    |  | Elevation |  |        |          |   |   |   |

**WATER WELL LOCATION**

at owner's address

**WATER WELL OWNER**

|          |  |
|----------|--|
| Name     |  |
| Business |  |
| Address  |  |

**PERMIT & ID NUMBERS (AS REQUIRED)**

DWR Application No.: \_\_\_\_\_  
 KDHE / EPA Project Code: \_\_\_\_\_  
 Site Name: \_\_\_\_\_  
 KDHE UIC Class V Form Completed: Yes No  
 County/Local Permit Required? Yes No  
 Permit Obtained? Yes No Permit ID: \_\_\_\_\_  
 Oil/Gas Lease Name & Well #: \_\_\_\_\_

**CONSTRUCTION**

**Casing:** Height above land surface: \_\_\_\_\_ in.  
 Is casing height less than 12 inches? Yes No

Blank Casing type: \_\_\_\_\_  
 1st interval: \_\_\_\_\_ ft. to \_\_\_\_\_ ft.; Diameter \_\_\_\_\_ in.  
 Casing Joint: : \_\_\_\_\_ Weight: \_\_\_\_\_ lbs/ft  
 Wall thickness or gauge no.: \_\_\_\_\_  
 2nd interval: \_\_\_\_\_ ft. to \_\_\_\_\_ ft.; Diameter \_\_\_\_\_ in.  
 Casing Joint: : \_\_\_\_\_ Weight: \_\_\_\_\_ lbs/ft  
 Wall thickness or gauge no.: \_\_\_\_\_  
 3rd interval: \_\_\_\_\_ ft. to \_\_\_\_\_ ft.; Diameter \_\_\_\_\_ in.  
 Casing Joint: : \_\_\_\_\_ Weight: \_\_\_\_\_ lbs/ft  
 Wall thickness or gauge no.: \_\_\_\_\_

**Screen / Perforation material:** \_\_\_\_\_

Specify if other: \_\_\_\_\_

Screen / Perforation openings: \_\_\_\_\_

1st interval \_\_\_\_\_ ft. to \_\_\_\_\_ ft. Slot Size \_\_\_\_\_  
 2nd interval \_\_\_\_\_ ft. to \_\_\_\_\_ ft. Slot Size \_\_\_\_\_  
 3rd interval \_\_\_\_\_ ft. to \_\_\_\_\_ ft. Slot Size \_\_\_\_\_

**DESIGNATED PERSON****CONTRACTOR BUSINESS NAME****WELL WATER USE**

Additional info if required:

# of Boreholes

# of Dewatering Wells

**COMPLETION**

Depth of completed well: \_\_\_\_\_ ft.

Depth(s) groundwater encountered: Dry Well

(1) \_\_\_\_\_ ft.; (2) \_\_\_\_\_ ft.; (3) \_\_\_\_\_ ft.;

Static water level in well: \_\_\_\_\_ ft.

Date measured: \_\_\_\_\_

Measured from: Top of Casing or Ground Surface

Measured: Above or Below Land Surface

Estimated yield: \_\_\_\_\_ gpm

Pump Test Date: Water level was:

\_\_\_\_\_ ft. after \_\_\_\_\_ hours pumping \_\_\_\_\_ gpm

\_\_\_\_\_ ft. after \_\_\_\_\_ hours pumping \_\_\_\_\_ gpm

**Pump Information:**

Pump Installed? Yes No Date: \_\_\_\_\_

Pump Type: Horsepower: Volts:

Drop Pipe Diameter: in. Drop Pipe Length: ft.

Water well disinfected? Yes No

Date disinfected (mm/dd/yy): \_\_\_\_\_

**CONSTRUCTION****Borehole interval:**

from \_\_\_\_\_ to \_\_\_\_\_ ft.

from \_\_\_\_\_ to \_\_\_\_\_ ft.

from \_\_\_\_\_ to \_\_\_\_\_ ft..

**Borehole diameter:**

\_\_\_\_\_ in.

\_\_\_\_\_ in.

\_\_\_\_\_ in.

**Grout:**

1st Interval: \_\_\_\_\_ ft. to \_\_\_\_\_ ft. Grout material: \_\_\_\_\_

2nd Interval: \_\_\_\_\_ ft. to \_\_\_\_\_ ft. Grout material: \_\_\_\_\_

3rd Interval: \_\_\_\_\_ ft. to \_\_\_\_\_ ft. Grout material: \_\_\_\_\_

**Gravel pack:**

Not Used

1st Interval: \_\_\_\_\_ ft. to \_\_\_\_\_ ft. Gravel Size: \_\_\_\_\_

2nd Interval: \_\_\_\_\_ ft. to \_\_\_\_\_ ft. Gravel Size: \_\_\_\_\_

3rd Interval: \_\_\_\_\_ ft. to \_\_\_\_\_ ft. Gravel Size: \_\_\_\_\_

**WELL COMPLETION DATE**



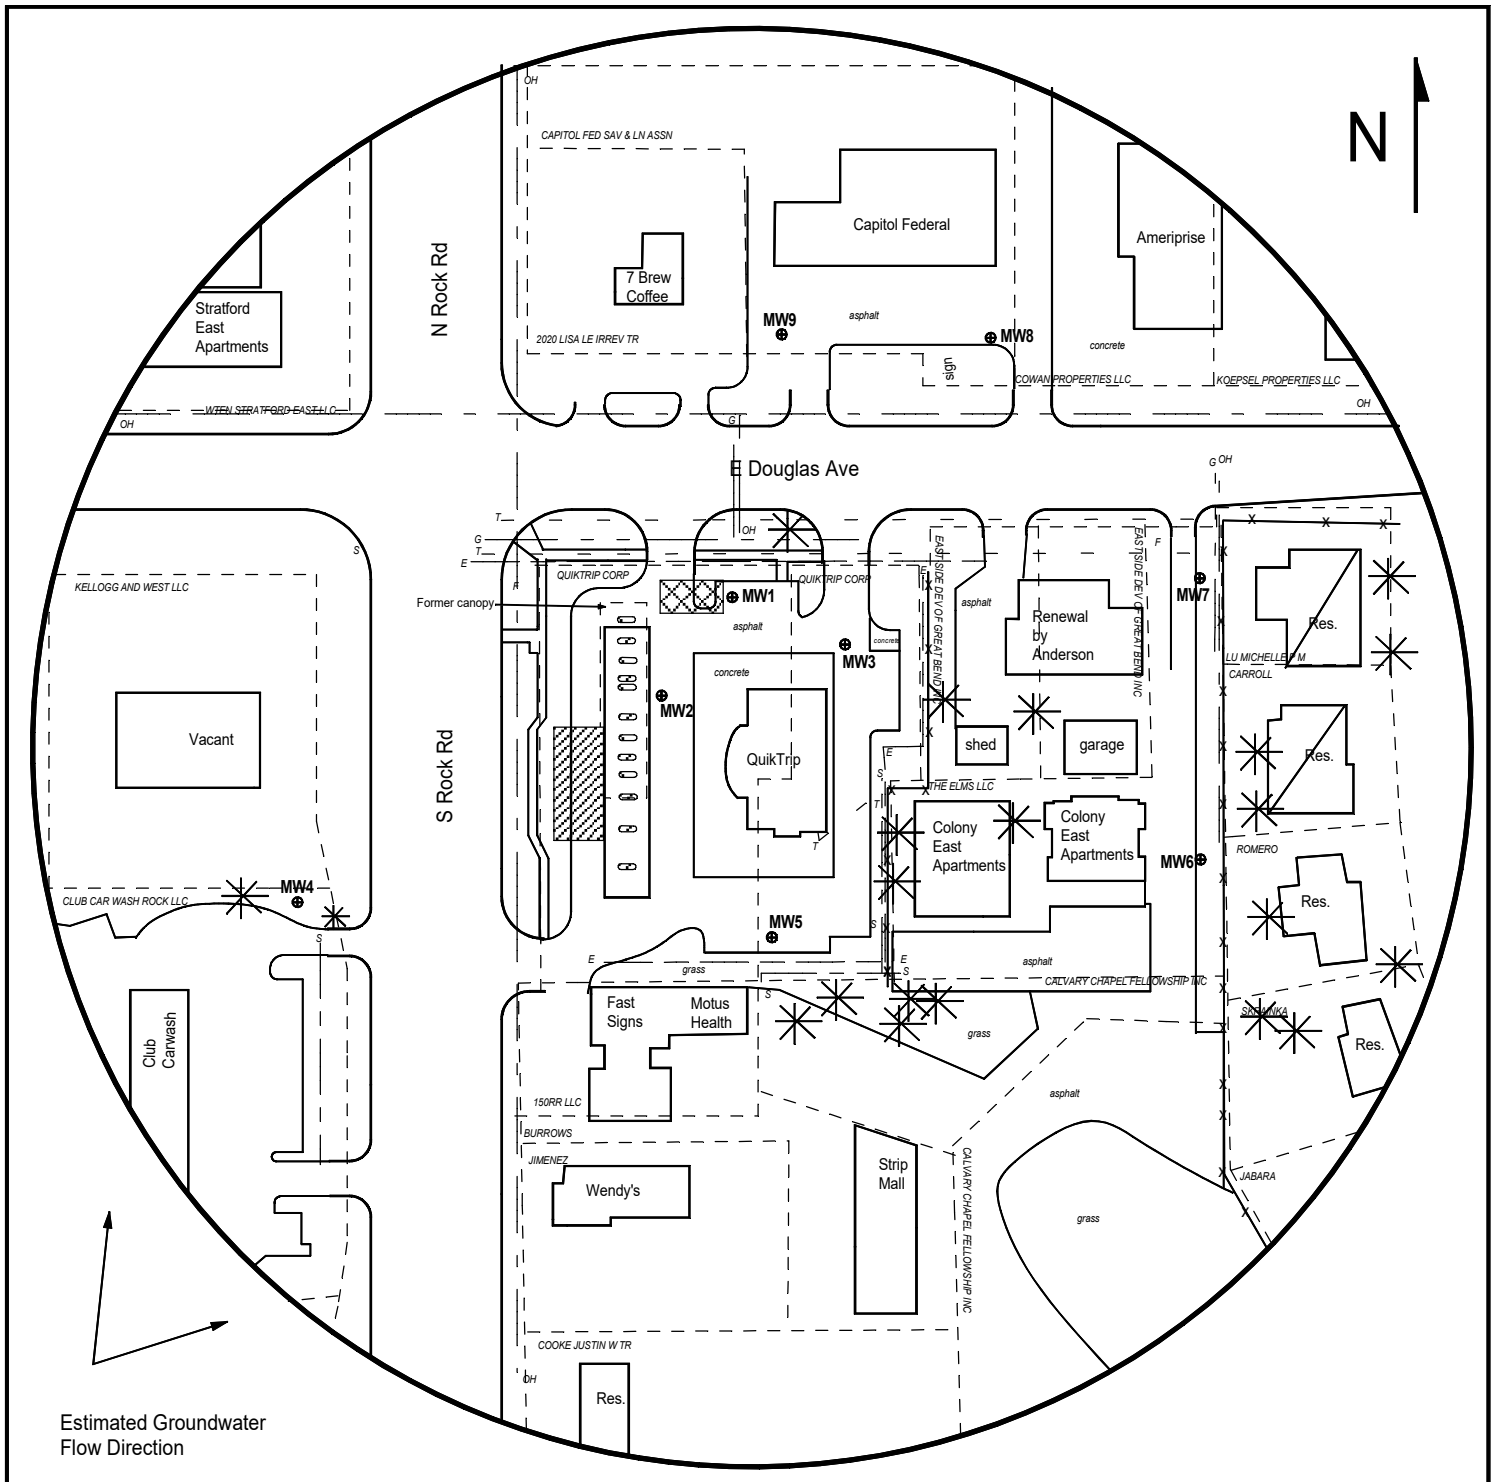


FIGURE 2 - 500 FT RADIUS AREA BASE MAP



1311 E 25th St., Suite B (785) 841-8707 office  
Lawrence, KS 66046

**PROJECT:**


QuikTrip #353R  
110 S Rock Road,  
Wichita, KS  
KDHE ID: U2-087-15659  
Date: 3/18/26

0 100 feet

**LEGEND:**

- Approximate Location of Active UST Basin and Pump Island
- Approximate Location of Former UST Basin and Pump Island
- Building with Basement
- X Proposed Soil Boring
- ⊕ Newly installed Monitoring Well
- F Fire Hydrant
- OH Overhead Lines
- G Gas (2 - 6 ft BGS)
- E Electric (2 - 6 ft BGS)
- T Telephone (2 - 6 ft BGS)
- S Sewer (2 - 6 ft BGS)
- \* Tree/Bush

NOTE: Utility depths and locations are approximate.  
NOTE: SB5 & SB6 will be drilled to collect hydrological samples.

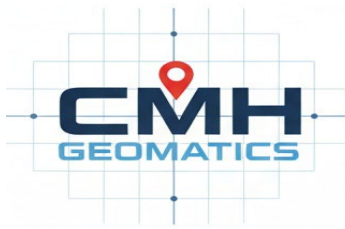

CMH Geomatics, LLC  
1917 SW Medford Ave., Topeka, KS 66604  
(785) 979-0372  
chumphrey@cmhgeomatics.com

Jess Chapman  
Larsen & Associates  
1311 E. 25<sup>th</sup> Street, Suite B  
Lawrence, Kansas 66046

June 24, 2026

Re: Project No. T26-001-LAA-008 Monitor Well Location and Elevation Survey, QuikTrip #353R 110 S Rock Road, Wichita, KS. KDHE ID: U2-087-15659.

| Point          | Distance<br>North of<br>SE Cor. | Distance<br>West of SE<br>Cor. | Elev. Top of<br>Rim | Elev.<br>Top of<br>Pipe | Latitude | Longitude |
|----------------|---------------------------------|--------------------------------|---------------------|-------------------------|----------|-----------|
| MW 1           | 2485.726                        | 5140.733                       | 1353.60             | 1353.36                 | 37.68630 | -97.24379 |
| MW 2           | 2418.957                        | 5187.59                        | 1353.90             | 1353.55                 | 37.68610 | -97.24396 |
| MW 3           | 2457.292                        | 5062.377                       | 1354.55             | 1354.23                 | 37.68620 | -97.24352 |
| MW 4           | 2283.353                        | 5435.121                       | 1358.94             | 1358.42                 | 37.68570 | -97.24482 |
| MW 5           | 2268.645                        | 5117.158                       | 1354.13             | 1353.88                 | 37.68570 | -97.24372 |
| MW 6           | 2305.876                        | 4810.765                       | 1348.38             | 1348.06                 | 37.68580 | -97.24266 |
| MW 7           | 2502.877                        | 4812.638                       | 1348.00             | 1347.69                 | 37.68630 | -97.24266 |
| MW 8           | 2668.062                        | 4968.339                       | 1350.09             | 1349.79                 | 37.68680 | -97.24319 |
| MW 9           | 2667.396                        | 5103.134                       | 1353.11             | 1352.76                 | 37.68680 | -97.24365 |
| Site Benchmark | 2507.433                        | 5263.736                       | 1356.20             |                         | 37.68630 | -97.24422 |
| NGS Monument   | 13101.795                       | 5469.369                       | 1385.68             |                         | 37.71540 | -97.24443 |

**Project Information:** All Measured distances taken from a Chiseled "+" found at the Southeast Corner of Section 20, Township 27 South, Range 2 East of the 6th P.M. Vertical Measurements were taken in NAVD 88 and established from NGS monument PID HE 0447 Designation Q 39. Set Notches on North side of Top Rim and on the North side of Pipe. Site Benchmark is a set Chiseled Square in Northwest corner of the Concrete Base for Quick Trip Sign on Northwest Corner of Property.

