

WATER WELL RECORD (WWC5.2)

Constructed

KOLAR DOC ID _____ WELL ID _____

LOCATION OF WATER WELL

County		Section		Township		Range		E W	Fraction	¼	¼	¼
Latitude		Longitude				Datum			Elevation			

WATER WELL LOCATION

at owner's address

WATER WELL OWNER

Name	
Business	
Address	

PERMIT & ID NUMBERS (AS REQUIRED)

DWR Application No.: _____
 KDHE / EPA Project Code: _____
 Site Name: _____
 KDHE UIC Class V Form Completed: Yes No
 County/Local Permit Required? Yes No
 Permit Obtained? Yes No Permit ID: _____
 Oil/Gas Lease Name & Well #: _____

CONSTRUCTION

Casing: Height above land surface: _____ in.
 Is casing height less than 12 inches? Yes No

Blank Casing type: _____
 1st interval: _____ ft. to _____ ft.; Diameter _____ in.
 Casing Joint: : _____ Weight: _____ lbs/ft
 Wall thickness or gauge no.: _____
 2nd interval: _____ ft. to _____ ft.; Diameter _____ in.
 Casing Joint: : _____ Weight: _____ lbs/ft
 Wall thickness or gauge no.: _____
 3rd interval: _____ ft. to _____ ft.; Diameter _____ in.
 Casing Joint: : _____ Weight: _____ lbs/ft
 Wall thickness or gauge no.: _____

Screen / Perforation material: _____

Specify if other: _____

Screen / Perforation openings: _____

1st interval _____ ft. to _____ ft. Slot Size _____
 2nd interval _____ ft. to _____ ft. Slot Size _____
 3rd interval _____ ft. to _____ ft. Slot Size _____

WELL WATER USE

Additional info if required:

of Boreholes # of Dewatering Wells

COMPLETION

Depth of completed well: _____ ft.

Depth(s) groundwater encountered: Dry Well

(1) _____ ft.; (2) _____ ft.; (3) _____ ft.;

Static water level in well: _____ ft.

Date measured: _____

Measured from: Top of Casing or Ground Surface

Measured: Above or Below Land Surface

Estimated yield: _____ gpm

Pump Test Date: Water level was:

_____ ft. after _____ hours pumping _____ gpm

_____ ft. after _____ hours pumping _____ gpm

Pump Information:

Pump Installed? Yes No Date: _____

Pump Type: Horsepower: Volts:

Drop Pipe Diameter: in. Drop Pipe Length: ft.

Water well disinfected? Yes No

Date disinfected (mm/dd/yy): _____

CONSTRUCTION**Borehole interval:**

from _____ to _____ ft.

from _____ to _____ ft.

from _____ to _____ ft..

Borehole diameter:

_____ in.

_____ in.

_____ in.

Grout:

1st Interval: _____ ft. to _____ ft. Grout material: _____

2nd Interval: _____ ft. to _____ ft. Grout material: _____

3rd Interval: _____ ft. to _____ ft. Grout material: _____

Gravel pack:

Not Used

1st Interval: _____ ft. to _____ ft. Gravel Size: _____

2nd Interval: _____ ft. to _____ ft. Gravel Size: _____

3rd Interval: _____ ft. to _____ ft. Gravel Size: _____

DESIGNATED PERSON**WELL COMPLETION DATE****CONTRACTOR BUSINESS NAME**

LOCATION OF WATER WELL

County		Section		Township		Range	$\frac{E}{W}$	Fraction	$\frac{1}{4}$	$\frac{1}{4}$	$\frac{1}{4}$
Latitude		Longitude				Datum		Elevation			
Well Owner				Well Owner Business							

NEAREST SOURCE OF POTENTIAL CONTAMINATION	or	No potential source of contamination within 100 ft.

Source:				Source:			
Distance from well (ft):		Direction from well:		Distance from well (ft):		Direction from well:	
Source description:				Source description:			
Required information for local entity?		Yes	No	Required information for local entity?		Yes	No

LITHOLOGIC LOG

AQUIFER, if known[illegible]

COMMENTS

This water well was constructed/reconstructed pursuant to the stated water well contractor's license and was completed on _____.

I certify that this record is true to the best of my knowledge and belief. This water well record was completed on _____ under the business name of _____, KS Water Well Contractor's License No. _____ under the authority of the designated person as defined in K.A.R. 28-30-2(j) and signed and certified by the electronic signature of the designated person at its submittal: _____.

Send one copy to the water well owner and the contractor should retain one copy.

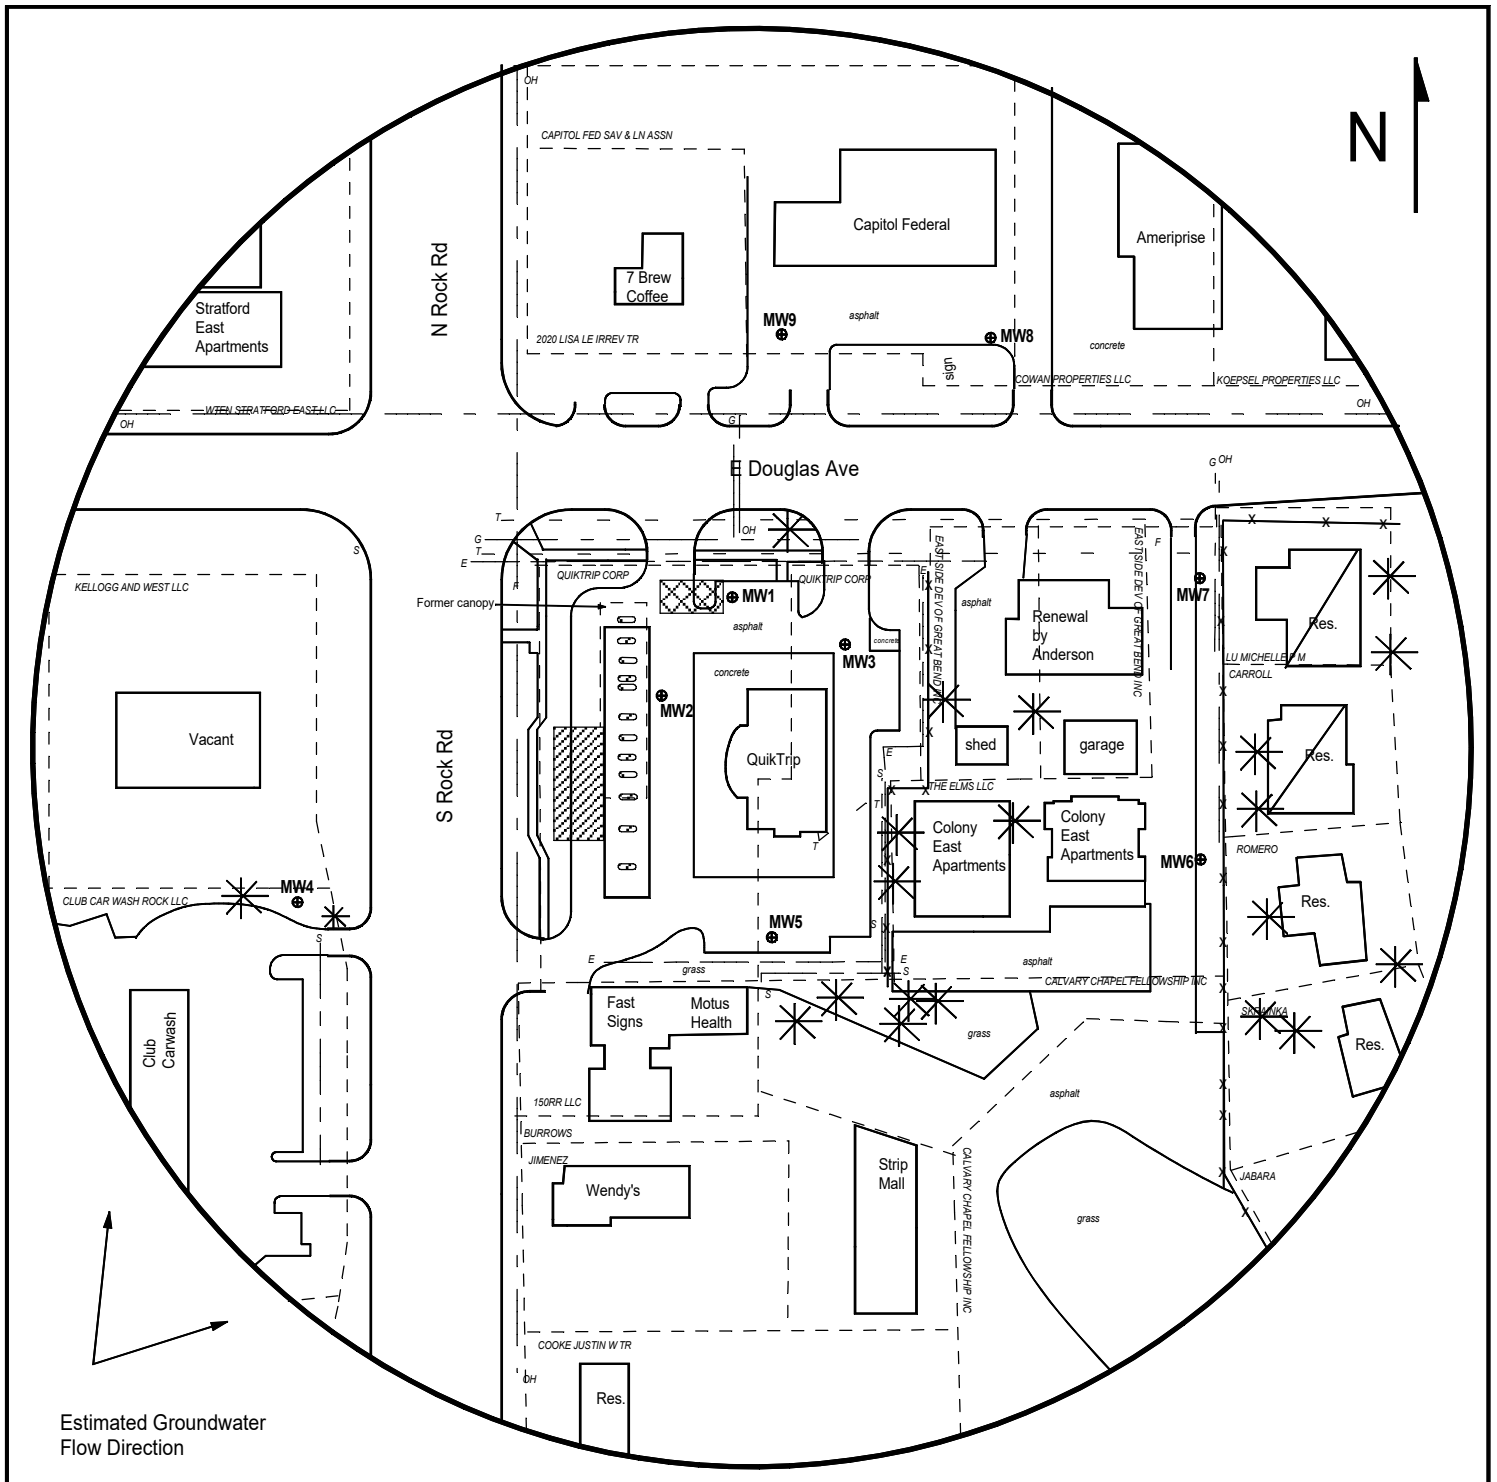


FIGURE 2 - 500 FT RADIUS AREA BASE MAP



1311 E 25th St., Suite B (785) 841-8707 office
Lawrence, KS 66046

PROJECT:


QuikTrip #353R
110 S Rock Road,
Wichita, KS
KDHE ID: U2-087-15659
Date: 3/18/26

0 100 feet

LEGEND:

- Approximate Location of Active UST Basin and Pump Island
- Approximate Location of Former UST Basin and Pump Island
- Building with Basement
- X Proposed Soil Boring
- ⊕ Newly installed Monitoring Well
- F Fire Hydrant
- OH Overhead Lines
- G Gas (2 - 6 ft BGS)
- E Electric (2 - 6 ft BGS)
- T Telephone (2 - 6 ft BGS)
- S Sewer (2 - 6 ft BGS)
- * Tree/Bush

NOTE: Utility depths and locations are approximate.
NOTE: SB5 & SB6 will be drilled to collect hydrological samples.

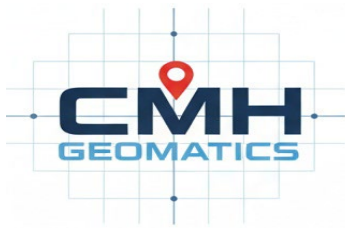

CMH Geomatics, LLC
1917 SW Medford Ave., Topeka, KS 66604
(785) 979-0372
chumphrey@cmhgeomatics.com

Jess Chapman
Larsen & Associates
1311 E. 25th Street, Suite B
Lawrence, Kansas 66046

June 24, 2026

Re: Project No. T26-001-LAA-008 Monitor Well Location and Elevation Survey, QuikTrip #353R 110 S Rock Road, Wichita, KS. KDHE ID: U2-087-15659.

Point	Distance North of SE Cor.	Distance West of SE Cor.	Elev. Top of Rim	Elev. Top of Pipe	Latitude	Longitude
MW 1	2485.726	5140.733	1353.60	1353.36	37.68630	-97.24379
MW 2	2418.957	5187.59	1353.90	1353.55	37.68610	-97.24396
MW 3	2457.292	5062.377	1354.55	1354.23	37.68620	-97.24352
MW 4	2283.353	5435.121	1358.94	1358.42	37.68570	-97.24482
MW 5	2268.645	5117.158	1354.13	1353.88	37.68570	-97.24372
MW 6	2305.876	4810.765	1348.38	1348.06	37.68580	-97.24266
MW 7	2502.877	4812.638	1348.00	1347.69	37.68630	-97.24266
MW 8	2668.062	4968.339	1350.09	1349.79	37.68680	-97.24319
MW 9	2667.396	5103.134	1353.11	1352.76	37.68680	-97.24365
Site Benchmark	2507.433	5263.736	1356.20		37.68630	-97.24422
NGS Monument	13101.795	5469.369	1385.68		37.71540	-97.24443

Project Information: All Measured distances taken from a Chiseled "+" found at the Southeast Corner of Section 20, Township 27 South, Range 2 East of the 6th P.M. Vertical Measurements were taken in NAVD 88 and established from NGS monument PID HE 0447 Designation Q 39. Set Notches on North side of Top Rim and on the North side of Pipe. Site Benchmark is a set Chiseled Square in Northwest corner of the Concrete Base for Quick Trip Sign on Northwest Corner of Property.

