

WATER WELL RECORD (WWC5.2)

Constructed

KOLAR DOC ID _____ WELL ID _____

LOCATION OF WATER WELL

County		Section		Township		Range		E W	Fraction	¼	¼	¼
Latitude		Longitude		Datum		Elevation						

WATER WELL LOCATION

at owner's address

WATER WELL OWNER

Name	
Business	
Address	

PERMIT & ID NUMBERS (AS REQUIRED)

DWR Application No.: _____
 KDHE / EPA Project Code: _____
 Site Name: _____
 KDHE UIC Class V Form Completed: Yes No
 County/Local Permit Required? Yes No
 Permit Obtained? Yes No Permit ID: _____
 Oil/Gas Lease Name & Well #: _____

CONSTRUCTION

Casing: Height above land surface: _____ in.
 Is casing height less than 12 inches? Yes No

Blank Casing type: _____
 1st interval: _____ ft. to _____ ft.; Diameter _____ in.
 Casing Joint: : _____ Weight: _____ lbs/ft
 Wall thickness or gauge no.: _____
 2nd interval: _____ ft. to _____ ft.; Diameter _____ in.
 Casing Joint: : _____ Weight: _____ lbs/ft
 Wall thickness or gauge no.: _____
 3rd interval: _____ ft. to _____ ft.; Diameter _____ in.
 Casing Joint: : _____ Weight: _____ lbs/ft
 Wall thickness or gauge no.: _____

Screen / Perforation material: _____

Specify if other: _____

Screen / Perforation openings: _____

1st interval _____ ft. to _____ ft. Slot Size _____
 2nd interval _____ ft. to _____ ft. Slot Size _____
 3rd interval _____ ft. to _____ ft. Slot Size _____

WELL WATER USE

Additional info if required:

of Boreholes # of Dewatering Wells

COMPLETION

Depth of completed well: _____ ft.

Depth(s) groundwater encountered: Dry Well

(1) _____ ft.; (2) _____ ft.; (3) _____ ft.;

Static water level in well: _____ ft.

Date measured: _____

Measured from: Top of Casing or Ground Surface

Measured: Above or Below Land Surface

Estimated yield: _____ gpm

Pump Test Date: Water level was:

_____ ft. after _____ hours pumping _____ gpm

_____ ft. after _____ hours pumping _____ gpm

Pump Information:

Pump Installed? Yes No Date: _____

Pump Type: Horsepower: Volts:

Drop Pipe Diameter: in. Drop Pipe Length: ft.

Water well disinfected? Yes No

Date disinfected (mm/dd/yy): _____

CONSTRUCTION**Borehole interval:**

from _____ to _____ ft.

from _____ to _____ ft.

from _____ to _____ ft..

Borehole diameter:

_____ in.

_____ in.

_____ in.

Grout:

1st Interval: _____ ft. to _____ ft. Grout material: _____

2nd Interval: _____ ft. to _____ ft. Grout material: _____

3rd Interval: _____ ft. to _____ ft. Grout material: _____

Gravel pack:

Not Used

1st Interval: _____ ft. to _____ ft. Gravel Size: _____

2nd Interval: _____ ft. to _____ ft. Gravel Size: _____

3rd Interval: _____ ft. to _____ ft. Gravel Size: _____

DESIGNATED PERSON**WELL COMPLETION DATE****CONTRACTOR BUSINESS NAME**

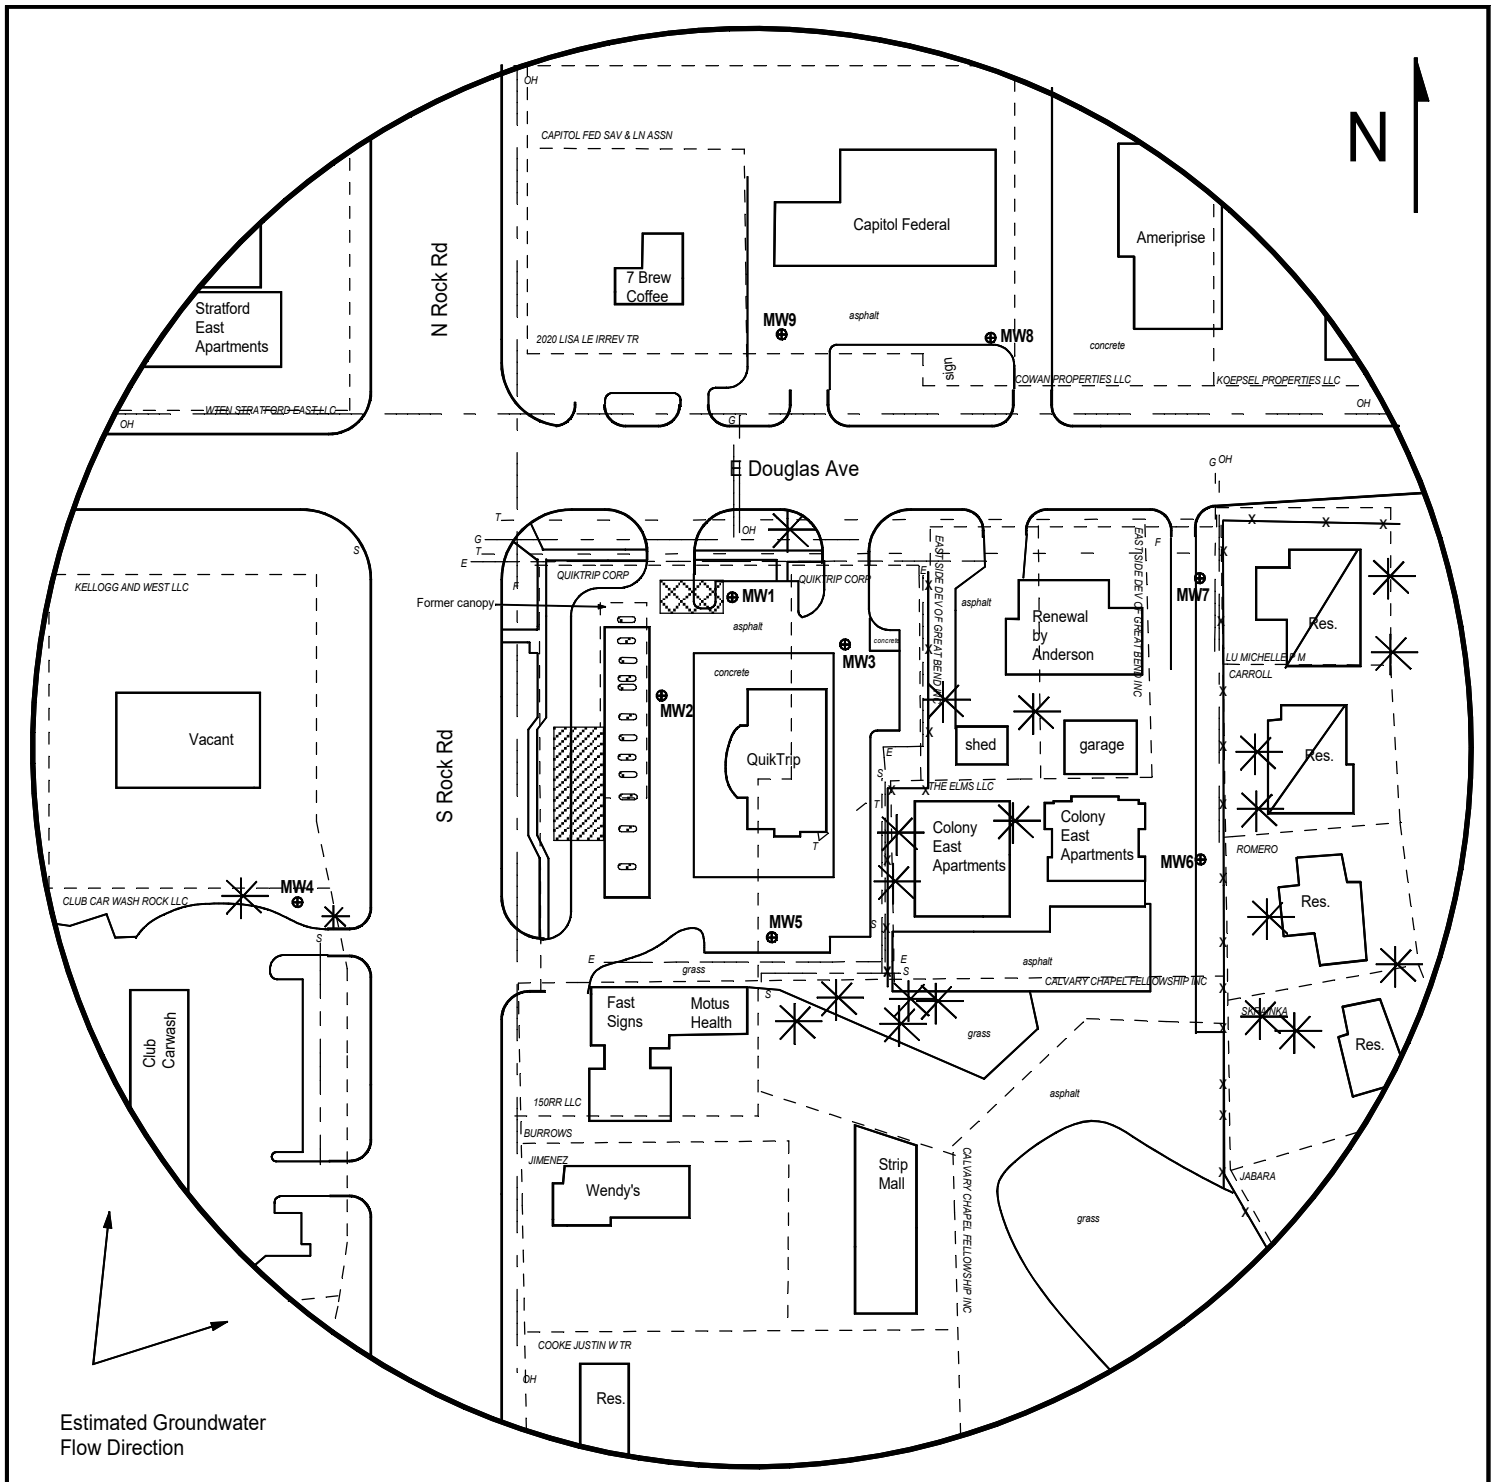


FIGURE 2 - 500 FT RADIUS AREA BASE MAP



1311 E 25th St., Suite B (785) 841-8707 office
Lawrence, KS 66046

PROJECT:


QuikTrip #353R
110 S Rock Road,
Wichita, KS
KDHE ID: U2-087-15659
Date: 3/18/26

0 100 feet

LEGEND:

- Approximate Location of Active UST Basin and Pump Island
- Approximate Location of Former UST Basin and Pump Island
- Building with Basement
- X Proposed Soil Boring
- ⊕ Newly installed Monitoring Well
- F Fire Hydrant
- OH Overhead Lines
- G Gas (2 - 6 ft BGS)
- E Electric (2 - 6 ft BGS)
- T Telephone (2 - 6 ft BGS)
- S Sewer (2 - 6 ft BGS)
- * Tree/Bush

NOTE: Utility depths and locations are approximate.
NOTE: SB5 & SB6 will be drilled to collect hydrological samples.

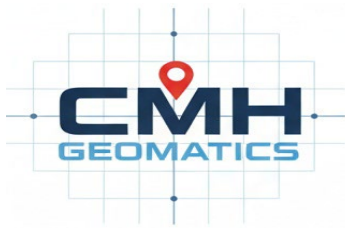

CMH Geomatics, LLC
1917 SW Medford Ave., Topeka, KS 66604
(785) 979-0372
chumphrey@cmhgeomatics.com


Jess Chapman
Larsen & Associates
1311 E. 25th Street, Suite B
Lawrence, Kansas 66046


June 24, 2026

Re: Project No. T26-001-LAA-008 Monitor Well Location and Elevation Survey, QuikTrip #353R 110 S Rock Road, Wichita, KS. KDHE ID: U2-087-15659.

Point	Distance North of SE Cor.	Distance West of SE Cor.	Elev. Top of Rim	Elev. Top of Pipe	Latitude	Longitude
MW 1	2485.726	5140.733	1353.60	1353.36	37.68630	-97.24379
MW 2	2418.957	5187.59	1353.90	1353.55	37.68610	-97.24396
MW 3	2457.292	5062.377	1354.55	1354.23	37.68620	-97.24352
MW 4	2283.353	5435.121	1358.94	1358.42	37.68570	-97.24482
MW 5	2268.645	5117.158	1354.13	1353.88	37.68570	-97.24372
MW 6	2305.876	4810.765	1348.38	1348.06	37.68580	-97.24266
MW 7	2502.877	4812.638	1348.00	1347.69	37.68630	-97.24266
MW 8	2668.062	4968.339	1350.09	1349.79	37.68680	-97.24319
MW 9	2667.396	5103.134	1353.11	1352.76	37.68680	-97.24365
Site Benchmark	2507.433	5263.736	1356.20		37.68630	-97.24422
NGS Monument	13101.795	5469.369	1385.68		37.71540	-97.24443

Project Information: All Measured distances taken from a Chiseled "+" found at the Southeast Corner of Section 20, Township 27 South, Range 2 East of the 6th P.M. Vertical Measurements were taken in NAVD 88 and established from NGS monument PID HE 0447 Designation Q 39. Set Notches on North side of Top Rim and on the North side of Pipe. Site Benchmark is a set Chiseled Square in Northwest corner of the Concrete Base for Quick Trip Sign on Northwest Corner of Property.

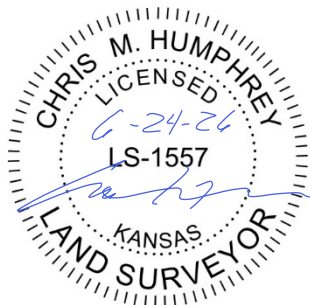

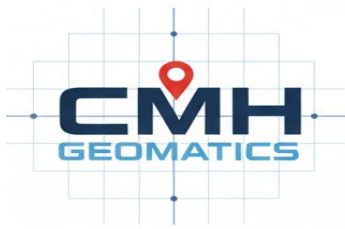

CMH Geomatics, LLC
1917 SW Medford Ave., Topeka, KS 66604
(785) 979-0372
chumphrey@cmhgeomatics.com

Jess Chapman
Larsen & Associates
1311 E. 25th Street, Suite B
Lawrence, Kansas 66046

June 24, 2026

Re: Project No. T26-001-LAA-008 Monitor Well Location and Elevation Survey, QuikTrip #353R 110 S Rock Road, Wichita, KS. KDHE ID: U2-087-15659.

Point	Distance North of SE Cor.	Distance West of SE Cor.	Elev. Top of Rim	Elev. Top of Pipe	Latitude	Longitude
MW 1	2485.726	5140.733	1353.60	1353.36	37.68630	-97.24379
MW 2	2418.957	5187.59	1353.90	1353.55	37.68610	-97.24396
MW 3	2457.292	5062.377	1354.55	1354.23	37.68620	-97.24352
MW 4	2283.353	5435.121	1358.94	1358.42	37.68570	-97.24482
MW 5	2268.645	5117.158	1354.13	1353.88	37.68570	-97.24372
MW 6	2305.876	4810.765	1348.38	1348.06	37.68580	-97.24266
MW 7	2502.877	4812.638	1348.00	1347.69	37.68630	-97.24266
MW 8	2668.062	4968.339	1350.09	1349.79	37.68680	-97.24319
MW 9	2667.396	5103.134	1353.11	1352.76	37.68680	-97.24365
Site Benchmark	2507.433	5263.736	1356.20		37.68630	-97.24422
NGS Monument	13101.795	5469.369	1385.68		37.71540	-97.24443

Project Information: All Measured distances taken from a Chiseled "+" found at the Southeast Corner of Section 20, Township 27 South, Range 2 East of the 6th P.M. Vertical Measurements were taken in NAVD 88 and established from NGS monument PID HE 0447 Designation Q 39. Set Notches on North side of Top Rim and on the North side of Pipe. Site Benchmark is a set Chiseled Square in Northwest corner of the Concrete Base for Quick Trip Sign on Northwest Corner of Property.

