

For KCC Use:Effective Date: 08/01/2026District # 1SGA? ☐ Yes ☒ No**KANSAS CORPORATION COMMISSION
OIL & GAS CONSERVATION DIVISION**

Form C-1

March 2010

Form must be Typed**Form must be Signed****All blanks must be Filled****NOTICE OF INTENT TO DRILL****Must be approved by KCC five (5) days prior to commencing well****Form KSONA-1, Certification of Compliance with the Kansas Surface Owner Notification Act, MUST be submitted with this form.**Expected Spud Date: 8/03/2026
month day yearOPERATOR: License# 5144Name: Mull Drilling Company, Inc.Address 1: 1700 N WATERFRONT PKWY BLDG 1200

Address 2: _____

City: WICHITA State: KS Zip: 67206 + 6637Contact Person: Preston DollPhone: 316-264-6366CONTRACTOR: License# 5929Name: Duke Drilling Co., Inc.**Well Drilled For:**☒ Oil☐ Gas☐ Seismic ; _____ # of Holes☐ Other: _____☐ If OWWO: old well information as follows:

Operator: _____

Well Name: _____

Original Completion Date: _____ Original Total Depth: _____

Directional, Deviated or Horizontal wellbore? ☐ Yes ☒ No

If Yes, true vertical depth: _____

Bottom Hole Location: _____

KCC DKT #: _____

Well Class:☐ Enh Rec☐ Storage☐ Disposal☐ Infield☐ Pool Ext.☐ Wildcat☒ Other**Type Equipment:**☒ Mud Rotary☐ Air Rotary☐ Cable

Spot Description: _____

SW - SW - NE - SE Sec. 8 Twp. 22 S. R. 37 ☐ E ☒ W
(Q/Q/Q/Q) 1608 feet from ☐ N / ☒ S Line of Section1243 feet from ☒ E / ☐ W Line of SectionIs SECTION: ☒ Regular ☐ Irregular?

(Note: Locate well on the Section Plat on reverse side)

County: KearnyLease Name: Stone Well #: 1-8Field Name: UnnamedIs this a Prorated / Spaced Field? ☐ Yes ☒ NoTarget Formation(s): MorrowNearest Lease or unit boundary line (in footage): 1032Ground Surface Elevation: 3311 Surveyed _____ feet MSLWater well within one-quarter mile: ☐ Yes ☒ NoPublic water supply well within one mile: ☐ Yes ☒ NoDepth to bottom of fresh water: 180Depth to bottom of usable water: 1000Surface Pipe by Alternate: ☒ I ☐ IILength of Surface Pipe Planned to be set: 1100

Length of Conductor Pipe (if any): _____

Projected Total Depth: 5200Formation at Total Depth: Mississippian

Water Source for Drilling Operations:

☐ Well ☐ Farm Pond ☒ Other: Haul

DWR Permit #: _____

(Note: Apply for Permit with DWR ☐)Will Cores be taken? ☐ Yes ☒ No

If Yes, proposed zone: _____

AFFIDAVIT

The undersigned hereby affirms that the drilling, completion and eventual plugging of this well will comply with K.S.A. 55 et. seq.

It is agreed that the following minimum requirements will be met:

1. Notify the appropriate district office **prior** to spudding of well;
2. A copy of the approved notice of intent to drill **shall be** posted on each drilling rig;
3. The minimum amount of surface pipe as specified below **shall be set** by circulating cement to the top; in all cases surface pipe **shall be set** through all unconsolidated materials plus a minimum of 20 feet into the underlying formation.
4. If the well is dry hole, an agreement between the operator and the district office on plug length and placement is necessary **prior to plugging**;
5. The appropriate district office will be notified before well is either plugged or production casing is cemented in;
6. If an ALTERNATE II COMPLETION, production pipe shall be cemented from below any usable water to surface within **120 DAYS** of spud date. Or pursuant to Appendix "B" - Eastern Kansas surface casing order #133,891-C, which applies to the KCC District 3 area, alternate II cementing must be completed within 30 days of the spud date or the well shall be plugged. **In all cases, NOTIFY district office** prior to any cementing.

Submitted Electronically**For KCC Use ONLY**API # 15 - 15-093-22039-00-00Conductor pipe required 0 feetMinimum surface pipe required 1020 feet per ALT. ☒ I ☐ IIApproved by: Alexis Vincent 07/27/2026This authorization expires: 07/27/2027

(This authorization void if drilling not started within 12 months of approval date.)

Spud date: _____ Agent: _____

Remember to:

- File Certification of Compliance with the Kansas Surface Owner Notification Act (KSONA-1) with Intent to Drill;
- File Drill Pit Application (form CDP-1) with Intent to Drill;
- File Completion Form ACO-1 within 120 days of spud date;
- File acreage attribution plat according to field proration orders;
- Notify appropriate district office 48 hours prior to workover or re-entry;
- Submit plugging report (CP-4) after plugging is completed (within 60 days);
- Obtain written approval before disposing or injecting salt water.
- If well will not be drilled or permit has expired (See: authorized expiration date) please check the box below and return to the address below.

☐ Well will not be drilled or Permit Expired Date: _____

Signature of Operator or Agent: _____

8

22

37

☐ E☒ X

W

For KCC Use ONLYAPI # 15 - 15-093-22039-00-00**IN ALL CASES PLOT THE INTENDED WELL ON THE PLAT BELOW**


In all cases, please fully complete this side of the form. Include items 1 through 5 at the bottom of this page.

Operator: Mull Drilling Company, Inc.Lease: StoneWell Number: 1-8Field: Unnamed


Number of Acres attributable to well: _____

QTR/QTR/QTR/QTR of acreage: SW - SW - NE - SELocation of Well: County: Kearny1608 feet from ☐ N / ☒ S Line of Section1243 feet from ☒ E / ☐ W Line of SectionSec. 8 Twp. 22 S. R. 37 ☐ E ☒ WIs Section: ☒ Regular or ☐ Irregular**If Section is Irregular, locate well from nearest corner boundary.**Section corner used: ☐ NE ☐ NW ☐ SE ☐ SW**PLAT**

Show location of the well. Show footage to the nearest lease or unit boundary line. Show the predicted locations of lease roads, tank batteries, pipelines and electrical lines, as required by the Kansas Surface Owner Notice Act (House Bill 2032). You may attach a separate plat if desired.

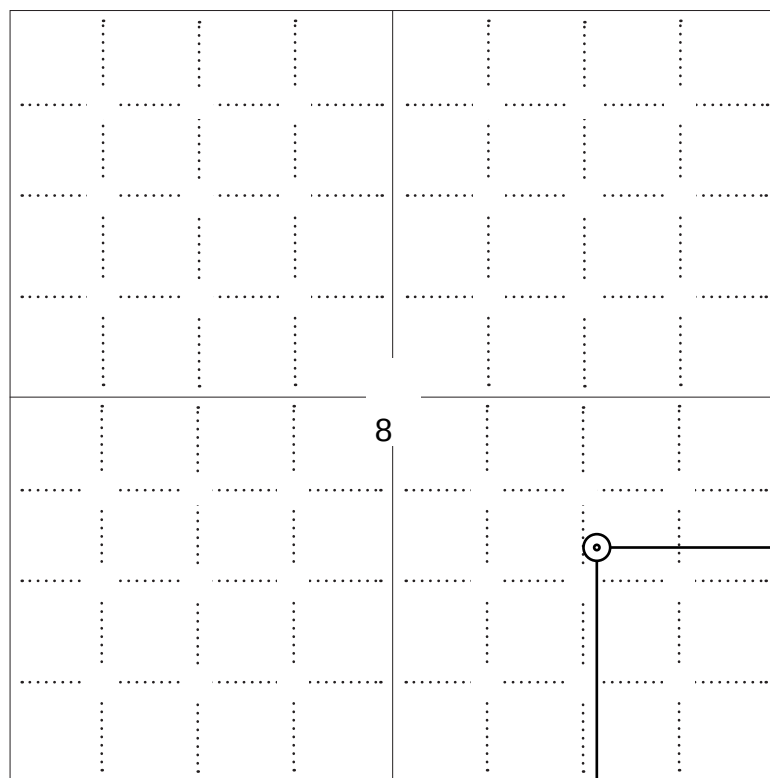**NOTE: In all cases locate the spot of the proposed drilling location.****LEGEND**

- ☐ Well Location
- ☐ Tank Battery Location
- Pipeline Location
- - - - Electric Line Location
- Lease Road Location

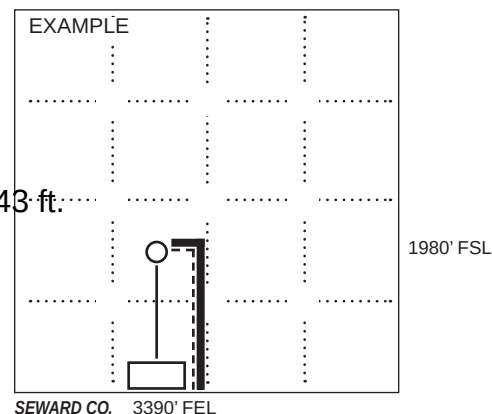

1608 ft.

In plotting the proposed location of the well, you must show:

- The manner in which you are using the depicted plat by identifying section lines, i.e. 1 section, 1 section with 8 surrounding sections, 4 sections, etc.
- The distance of the proposed drilling location from the south / north and east / west outside section lines.
- The distance to the nearest lease or unit boundary line (in footage).
- If proposed location is located within a prorated or spaced field a certificate of acreage attribution plat must be attached: (C0-7 for oil wells; CG-8 for gas wells).
- The predicted locations of lease roads, tank batteries, pipelines, and electrical lines.

KANSAS CORPORATION COMMISSION
OIL & GAS CONSERVATION DIVISION

Form CDP-1
May 2010
Form must be Typed

APPLICATION FOR SURFACE PIT

Submit in Duplicate

Operator Name: Mull Drilling Company, Inc.		License Number: 5144	
Operator Address: 1700 N WATERFRONT PKWY BLDG 1200		WICHITA KS 67206	
Contact Person: Preston Doll		Phone Number: 316-264-6366	
Lease Name & Well No.: Stone 1-8		Pit Location (QQQQ): SW - SW - NE - SE Sec. 8 Twp. 22 R. 37 ☐ East ☒ West 1608 Feet from ☐ North / ☒ South Line of Section 1243 Feet from ☒ East / ☐ West Line of Section Kearny County	
Type of Pit: ☐ Emergency Pit ☐ Burn Pit ☐ Settling Pit ☒ Drilling Pit ☐ Workover Pit ☐ Haul-Off Pit (If WP Supply API No. or Year Drilled)	Pit is: ☒ Proposed ☐ Existing If Existing, date constructed: _____ Pit capacity: 7125 (bbls)		
Is the pit located in a Sensitive Ground Water Area? ☐ Yes ☒ No		Chloride concentration: _____ mg/l (For Emergency Pits and Settling Pits only)	
Is the bottom below ground level? ☒ Yes ☐ No	Artificial Liner? ☐ Yes ☒ No	How is the pit lined if a plastic liner is not used? Natural clay soil and bentonite	
Pit dimensions (all but working pits): 100 Length (feet) 100 Width (feet) ☐ N/A: Steel Pits Depth from ground level to deepest point: 4 (feet) ☐ No Pit			
If the pit is lined give a brief description of the liner material, thickness and installation procedure.		Describe procedures for periodic maintenance and determining liner integrity, including any special monitoring.	
Distance to nearest water well within one-mile of pit: _____ feet Depth of water well _____ feet		Depth to shallowest fresh water _____ feet. Source of information: ☐ measured ☐ well owner ☐ electric log ☒ KDWR	
Emergency, Settling and Burn Pits ONLY: Producing Formation: _____ Number of producing wells on lease: _____ Barrels of fluid produced daily: _____ Does the slope from the tank battery allow all spilled fluids to flow into the pit? ☐ Yes ☐ No		Drilling, Workover and Haul-Off Pits ONLY: Type of material utilized in drilling/workover: drilling fluid Number of working pits to be utilized: 1 Abandonment procedure: Allow pits to evaporate until dry then backfill when conditions permit Drill pits must be closed within 365 days of spud date.	
Submitted Electronically			

KCC OFFICE USE ONLY

☐ Liner ☐ Steel Pit ☐ RFAC ☐ RFAS
 Date Received: **07/24/2026** Permit Number: **15-093-22039-00-00** Permit Date: **07/27/2026** Lease Inspection: ☐ Yes ☒ No

KANSAS CORPORATION COMMISSION
OIL & GAS CONSERVATION DIVISION

Form KSONA-1

July 2021

Form Must Be Typed

Form must be Signed

All blanks must be Filled

CERTIFICATION OF COMPLIANCE WITH THE KANSAS SURFACE OWNER NOTIFICATION ACT

This form must be submitted with all Forms C-1 (Notice of Intent to Drill); CB-1 (Cathodic Protection Borehole Intent); T-1 (Request for Change of Operator Transfer of Injection or Surface Pit Permit); and CP-1 (Well Plugging Application). Any such form submitted without an accompanying Form KSONA-1 will be returned.

Select the corresponding form being filed: ☒ **C-1** (Intent) ☐ **CB-1** (Cathodic Protection Borehole Intent) ☐ **T-1** (Transfer) ☐ **CP-1** (Plugging Application)

OPERATOR: License # 5144
Name: Mull Drilling Company, Inc.
Address 1: 1700 N WATERFRONT PKWY BLDG 1200
Address 2: _____
City: WICHITA State: KS Zip: 67206 + 6637 _____
Contact Person: Preston Doll
Phone: (316) 264-6366 Fax: (_____) _____
Email Address: _____

Well Location:
SW SW NE SE Sec. 8 Twp. 22 S. R. 37 ☐ East ☒ West
County: Kearny
Lease Name: Stone Well #: 1-8
If filing a Form T-1 for multiple wells on a lease, enter the legal description of the lease below:

Surface Owner Information:

Name: Clarissa Stone / Patricia Ann Swob
Address 1: 2500 N Rosemont Blvd, Apt 317 / 3827 Ave R
Address 2: _____
City: Tucson / Alber State: AZ / KS 67 Zip: 85712 + _____

When filing a Form T-1 involving multiple surface owners, attach an additional sheet listing all of the information to the left for each surface owner. Surface owner information can be found in the records of the register of deeds for the county, and in the real estate property tax records of the county treasurer.

If this form is being submitted with a Form C-1 (Intent) or CB-1 (Cathodic Protection Borehole Intent), you must supply the surface owners and the KCC with a plat showing the predicted locations of lease roads, tank batteries, pipelines, and electrical lines. The locations shown on the plat are preliminary non-binding estimates. The locations may be entered on the Form C-1 plat, Form CB-1 plat, or a separate plat may be submitted.


Select one of the following:

- ☒ I certify that, pursuant to the Kansas Surface Owner Notice Act (see Chapter 55 of the Kansas Statutes Annotated), I have provided the following to the surface owner(s) of the land upon which the subject well is or will be located: 1) a copy of the Form C-1, Form CB-1, Form T-1, or Form CP-1 that I am filing in connection with this form; 2) if the form being filed is a Form C-1 or Form CB-1, the plat(s) required by this form; and 3) my operator name, address, phone number, fax, and email address.
- ☐ I have not provided this information to the surface owner(s). I acknowledge that, because I have not provided this information, the KCC will be required to send this information to the surface owner(s). To mitigate the additional cost of the KCC performing this task, I acknowledge that I must provide the name and address of the surface owner by filling out the top section of this form and that I am being charged a \$30.00 handling fee, payable to the KCC, which is enclosed with this form.

If choosing the second option, submit payment of the \$30.00 handling fee with this form. If the fee is not received with this form, the KSONA-1 form and the associated Form C-1, Form CB-1, Form T-1, or Form CP-1 will be returned.

I Submitted Electronically

I

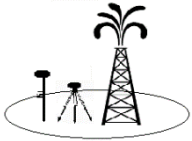

00-22s-37w-2025
CRD NO.

22s-37w
DMT NO.

PRO-STAKE LLC

Oil field & Construction Site Staking

P.O. Box 1575
Leoti, Ks. 67861
Jay Koehn: 620-874-0022
jay@prostakellc.com

20706
INVOICE NO.



Mull Drilling Company

OPERATOR

Stone #1-8

LEASE NAME

Sec. 8-T22S-R37W

LEGAL DESCRIPTION

Kearny Co. KS

COUNTY

1608' FSL - 1243' FEL

FOOTAGE CALLS

3311.4'

GR ELEVATION

SCALE: 1" = 1000'
DATE STAKED: July 23, 2026
MEASURED BY: Jay K.
DRAWN BY: Jay K.
AUTHORIZED BY: Sarah K.

NAD 83

LAT: 38.152249°
LONG: -101.399988°

NAD 27

LAT: 38.15223021°
LONG: -101.39954386°

SPCS NAD 27 KS-S

NORTHING/Y: 553883.17
EASTING/X: 1166346.91




LEGEND


- irr. well
- water hydrant
- tank battery
- staked loc.
- prod. well/aband. well
- house
- building
- gas line
- water line
- transmission powerline
- 3 phase powerline
- single phase powerline
- fence
- gravel/sand rd.
- gravel trail/lease rd.
- dirt rd.
- dirt trail/lease rd.
- Hwy/blacktop rd.

DIRECTIONS: Beginning at the intersection on US Hwy 50 & Hwy K-25 in Lakin, Ks. – proceed north on Hwy K-25 for 10.15 miles – turn left onto Rd 250 and proceed west for 7 miles – turn right onto Rd J and proceed north for 4 miles to the southeast corner of section 8-T22S-R37W – continue north on Rd J (now a dirt trail) for another 0.3 mile to an ingress stake "west into" – from this point, the staked location is 1243' west in cropland with growing milo
Final ingress must be verified with landowner.

LANDOWNER/CONTACT: Bruce Swob 620-923-5291

* This drawing does not constitute a monumented survey or a land survey plat.
* This drawing is intended for general informational and/or construction purposes only.

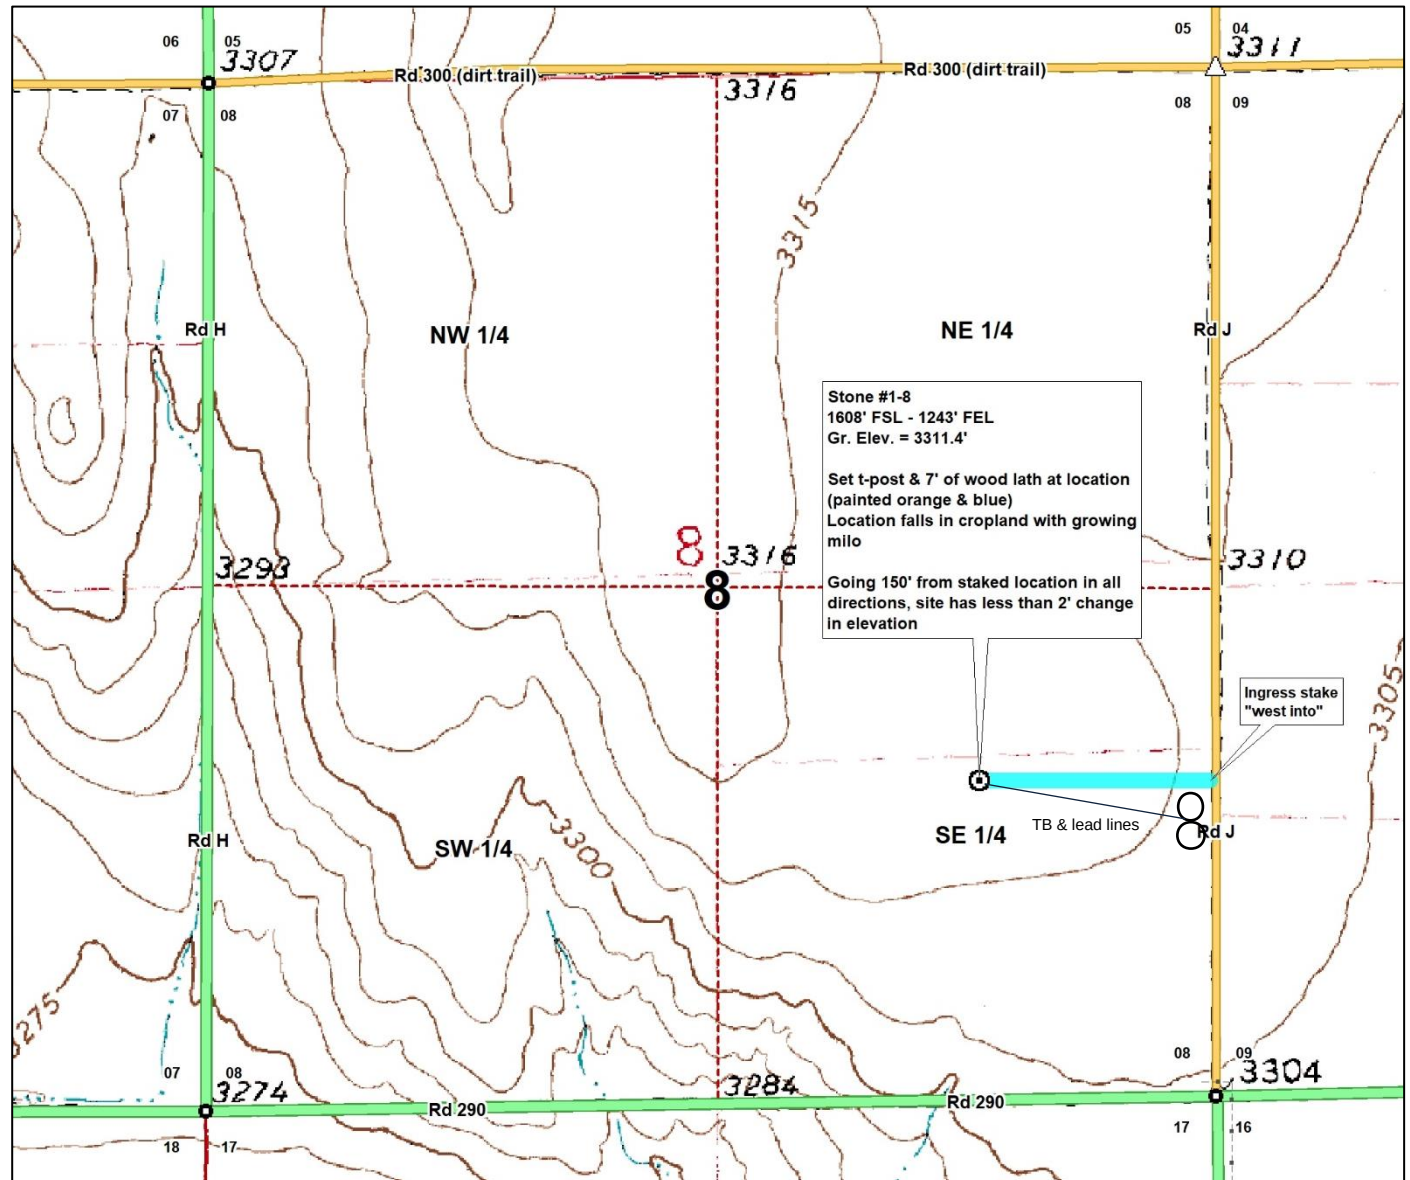

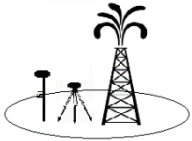

00-22s-37w-2025
CRD NO.

22s-37w
DMT NO.

PRO-STAKE LLC

Oil field & Construction Site Staking

P.O. Box 1575
Leoti, Ks. 67861
Jay Koehn: 620-874-0022
jay@prostakellc.com

20706
INVOICE NO.



Mull Drilling Company

OPERATOR

Stone #1-8

LEASE NAME

Sec. 8-T22S-R37W

LEGAL DESCRIPTION

Kearny Co. KS

COUNTY

1608' FSL - 1243' FEL

FOOTAGE CALLS

3311.4'

GR ELEVATION

SCALE: N/A
DATE STAKED: July 23, 2026
MEASURED BY: Jay K.
DRAWN BY: Jay K.
AUTHORIZED BY: Sarah K.

NAD 83

LAT: 38.152249°
LONG: -101.399988°

NAD 27

LAT: 38.15223021°
LONG: -101.39954386°

SPCS NAD 27 KS-S

NORTHING/Y: 553883.17
EASTING/X: 1166346.91



LEGEND


- irr. well
- water hydrant
- tank battery
- staked loc.
- prod. well/aband. well
- house
- building
- gas line
- water line
- transmission powerline
- 3 phase powerline
- single phase powerline
- fence
- gravel / sand rd.
- gravel trail / lease rd.
- dirt rd.
- dirt trail / lease rd.
- Hwy / blacktop rd.


DIRECTIONS: Beginning at the intersection on US Hwy 50 & Hwy K-25 in Lakin, Ks. – proceed north on Hwy K-25 for 10.15 miles – turn left onto Rd 250 and proceed west for 7 miles – turn right onto Rd J and proceed north for 4 miles to the southeast corner of section 8-T22S-R37W – continue north on Rd J (now a dirt trail) for another 0.3 mile to an ingress stake "west into" – from this point, the staked location is 1243' west in cropland with growing milo
Final ingress must be verified with landowner.

LANDOWNER/CONTACT: Bruce Swob 620-923-5291

* This drawing does not constitute a monumented survey or a land survey plat.

* This drawing is intended for general informational and/or construction purposes only.

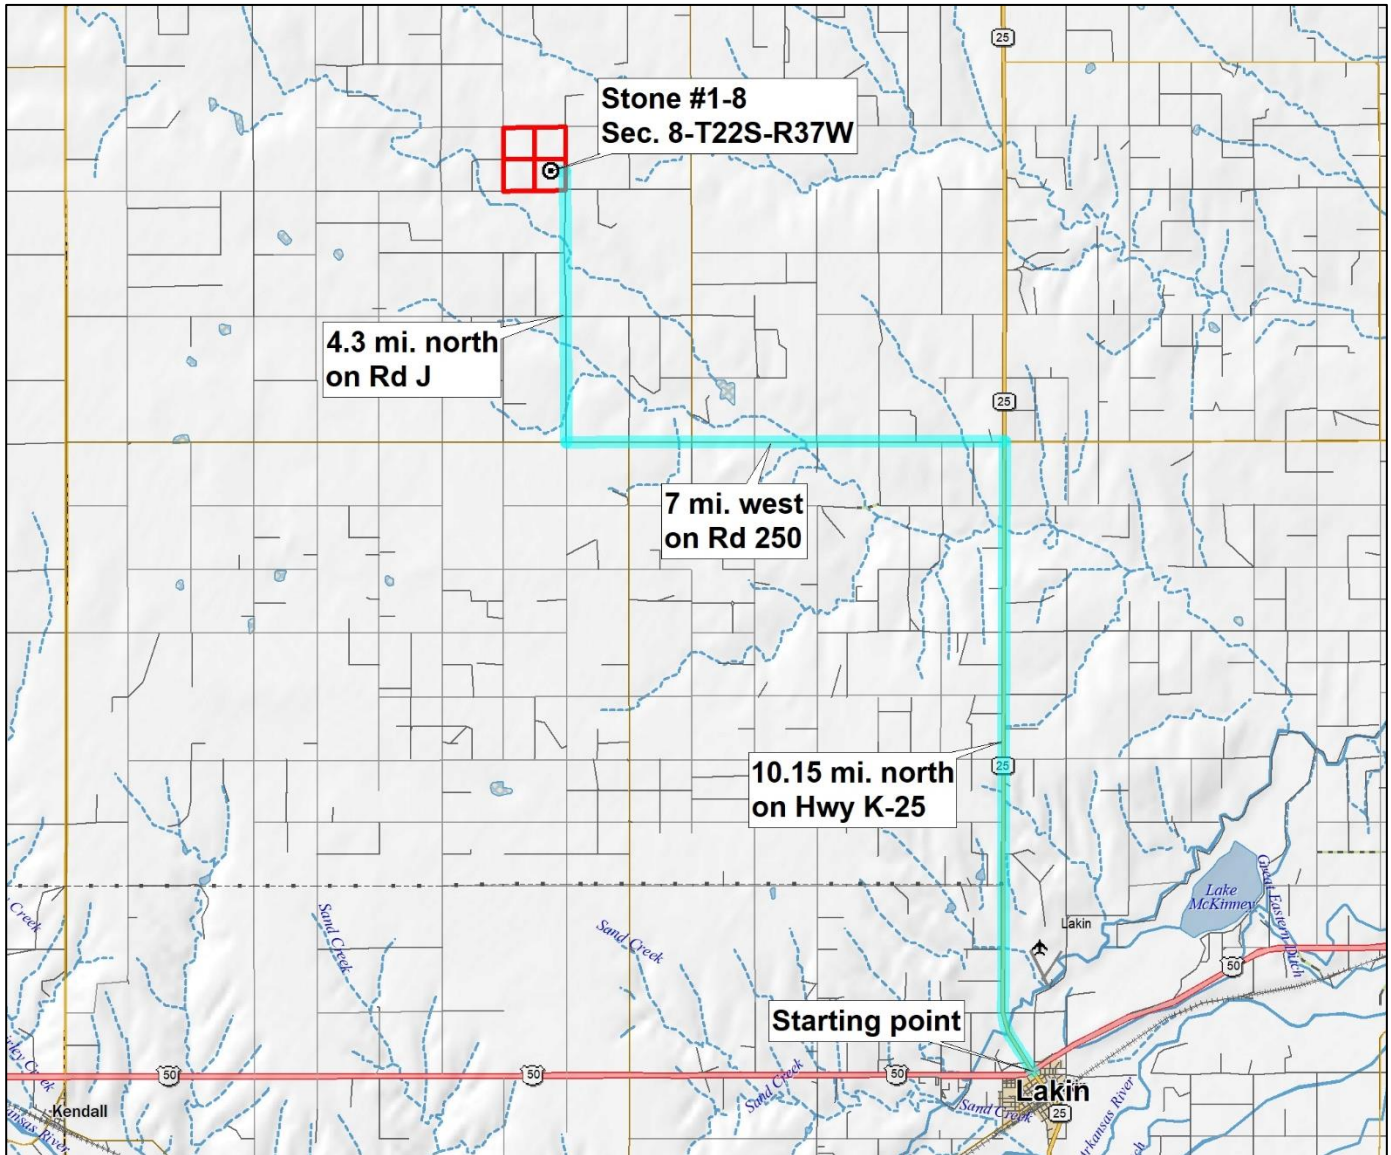

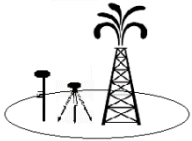

00-22s-37w-2025
CRD NO.

22s-37w
DMT NO.

PRO-STAKE LLC

Oil field & Construction Site Staking

P.O. Box 1575
Leoti, Ks. 67861
Jay Koehn: 620-874-0022
jay@prostakellc.com

20706
INVOICE NO.



Mull Drilling Company
OPERATOR

Stone #1-8
LEASE NAME

Sec. 8-T22S-R37W
LEGAL DESCRIPTION

Kearny Co. KS
COUNTY

1608' FSL - 1243' FEL
FOOTAGE CALLS

3311.4'
GR ELEVATION

SCALE: 1" = 1000'
DATE STAKED: July 23, 2026
MEASURED BY: Jay K.
DRAWN BY: Jay K.
AUTHORIZED BY: Sarah K.

NAD 83 LAT: 38.152249° LONG: -101.399988°	NAD 27 LAT: 38.15223021° LONG: -101.39954386°	SPCS NAD 27 KS-S NORTHING/Y: 553883.17 EASTING/X: 1166346.91
--	--	---

- LEGEND**
- irr. well
 - water hydrant
 - tank battery
 - staked loc.
 - prod. well/aband. well
 - house
 - building
 - gas line
 - water line
 - transmission powerline
 - 3 phase powerline
 - single phase powerline
 - fence
 - gravel/sand rd.
 - gravel trail/lease rd.
 - dirt rd.
 - dirt trail/lease rd.
 - Hwy/blacktop rd.



DIRECTIONS: Beginning at the intersection on US Hwy 50 & Hwy K-25 in Lakin, Ks. – proceed north on Hwy K-25 for 10.15 miles – turn left onto Rd 250 and proceed west for 7 miles – turn right onto Rd J and proceed north for 4 miles to the southeast corner of section 8-T22S-R37W – continue north on Rd J (now a dirt trail) for another 0.3 mile to an ingress stake "west into" – from this point, the staked location is 1243' west in cropland with growing milo
Final ingress must be verified with landowner.

LANDOWNER/CONTACT: Bruce Swob 620-923-5291

* This drawing does not constitute a monumented survey or a land survey plat.
* This drawing is intended for general informational and/or construction purposes only.

