

For KCC Use:Effective Date: 10/07/2026District # 1SGA? ☒ Yes ☐ No**KANSAS CORPORATION COMMISSION
OIL & GAS CONSERVATION DIVISION**

Form C-1

March 2010

Form must be Typed**Form must be Signed****All blanks must be Filled****NOTICE OF INTENT TO DRILL****Must be approved by KCC five (5) days prior to commencing well****Form KSONA-1, Certification of Compliance with the Kansas Surface Owner Notification Act, MUST be submitted with this form.**Expected Spud Date: 10/05/2026
month day yearOPERATOR: License# 36264Name: Eiger Operating Company, LLCAddress 1: 3811 TURTLE CREEK BLVD SUITE 975

Address 2: _____

City: DALLAS State: TX Zip: 75219 + 4784Contact Person: CASI RENFROPhone: 469-568-1716

CONTRACTOR: License# _____

Name: Advise on ACO-1 -- Must be licensed by KCC**Well Drilled For:**

☒ Oil	☐ Enh Rec	☐ Infield	☒ Mud Rotary
☐ Gas	☐ Storage	☐ Pool Ext.	☐ Air Rotary
	☐ Disposal	☒ Wildcat	☐ Cable
☐ Seismic ; _____ # of Holes	☐ Other		
☐ Other: _____			

☐ If OWWO: old well information as follows:

Operator: _____

Well Name: _____

Original Completion Date: _____ Original Total Depth: _____

Directional, Deviated or Horizontal wellbore? ☒ Yes ☐ NoIf Yes, true vertical depth: 5250Bottom Hole Location: 844' FSL & 2270' FEL

KCC DKT #: _____

NLUB letter attached

Spot Description: _____

W2 - SW - SW - SE Sec. 33 Twp. 24 S. R. 33 ☐ E ☒ W
(Q/Q/Q/Q) 330 feet from ☐ N / ☒ S Line of Section
2385 feet from ☒ E / ☐ W Line of Section

Is SECTION: ☒ Regular ☐ Irregular?*(Note: Locate well on the Section Plat on reverse side)*County: FinneyLease Name: SUNFLOWER Well #: 33-2Field Name: UNASSIGNEDIs this a Prorated / Spaced Field? ☐ Yes ☒ NoTarget Formation(s): MISSISSIPPIANNearest Lease or unit boundary line (in footage): 330Ground Surface Elevation: 2910 Estimated _____ feet MSLWater well within one-quarter mile: ☐ Yes ☒ NoPublic water supply well within one mile: ☐ Yes ☒ NoDepth to bottom of fresh water: 480Depth to bottom of usable water: 920Surface Pipe by Alternate: ☒ I ☐ IILength of Surface Pipe Planned to be set: 1800

Length of Conductor Pipe (if any): _____

Projected Total Depth: 5250Formation at Total Depth: ST LOUIS

Water Source for Drilling Operations:

☒ Well ☐ Farm Pond ☐ Other: _____

DWR Permit #: _____

*(Note: Apply for Permit with DWR ☐)*Will Cores be taken? ☐ Yes ☒ No

If Yes, proposed zone: _____

AFFIDAVIT

The undersigned hereby affirms that the drilling, completion and eventual plugging of this well will comply with K.S.A. 55 et. seq.

It is agreed that the following minimum requirements will be met:

1. Notify the appropriate district office **prior** to spudding of well;
2. A copy of the approved notice of intent to drill **shall be** posted on each drilling rig;
3. The minimum amount of surface pipe as specified below **shall be set** by circulating cement to the top; in all cases surface pipe **shall be set** through all unconsolidated materials plus a minimum of 20 feet into the underlying formation.
4. If the well is dry hole, an agreement between the operator and the district office on plug length and placement is necessary **prior to plugging**;
5. The appropriate district office will be notified before well is either plugged or production casing is cemented in;
6. If an ALTERNATE II COMPLETION, production pipe shall be cemented from below any usable water to surface within **120 DAYS** of spud date. Or pursuant to Appendix "B" - Eastern Kansas surface casing order #133,891-C, which applies to the KCC District 3 area, alternate II cementing must be completed within 30 days of the spud date or the well shall be plugged. **In all cases, NOTIFY district office** prior to any cementing.

Submitted Electronically**For KCC Use ONLY**API # 15 - 15-055-22660-01-00Conductor pipe required 0 feetMinimum surface pipe required 940 feet per ALT. ☒ I ☐ IIApproved by: Alexis Vincent 10/02/2026This authorization expires: 10/02/2027*(This authorization void if drilling not started within 12 months of approval date.)*

Spud date: _____ Agent: _____

Remember to:

- File Certification of Compliance with the Kansas Surface Owner Notification Act (KSONA-1) with Intent to Drill;
- File Drill Pit Application (form CDP-1) with Intent to Drill;
- File Completion Form ACO-1 within 120 days of spud date;
- File acreage attribution plat according to field proration orders;
- Notify appropriate district office 48 hours prior to workover or re-entry;
- Submit plugging report (CP-4) after plugging is completed (within 60 days);
- Obtain written approval before disposing or injecting salt water.
- If well will not be drilled or permit has expired (See: authorized expiration date) please check the box below and return to the address below.

☐ **Well will not be drilled or Permit Expired** Date: _____

Signature of Operator or Agent: _____

33

24

33

☐ E☒ W

For KCC Use ONLY

API # 15 - 15-055-22660-01-00

IN ALL CASES PLOT THE INTENDED WELL ON THE PLAT BELOW

In all cases, please fully complete this side of the form. Include items 1 through 5 at the bottom of this page.

Operator: Eiger Operating Company, LLC

Lease: SUNFLOWER

Well Number: 33-2

Field: UNASSIGNED


Number of Acres attributable to well: _____

QTR/QTR/QTR/QTR of acreage: W2 - SW - SW - SE

Location of Well: County: Finney

330 feet from ☐ N / ☒ S Line of Section2385 feet from ☒ E / ☐ W Line of SectionSec. 33 Twp. 24 S. R. 33 ☐ E ☒ WIs Section: ☒ Regular or ☐ Irregular**If Section is Irregular, locate well from nearest corner boundary.**Section corner used: ☐ NE ☐ NW ☐ SE ☐ SW**PLAT**


Show location of the well. Show footage to the nearest lease or unit boundary line. Show the predicted locations of lease roads, tank batteries, pipelines and electrical lines, as required by the Kansas Surface Owner Notice Act (House Bill 2032). You may attach a separate plat if desired.

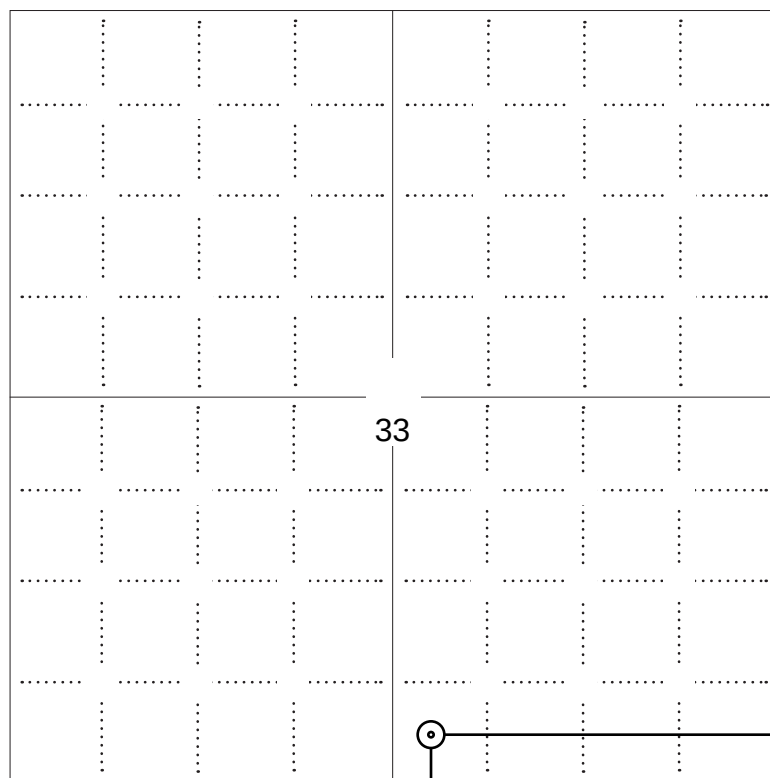**NOTE: In all cases locate the spot of the proposed drilling location.**

330 ft.

LEGEND

- ☐ Well Location
- ☐ Tank Battery Location
- ☐ Pipeline Location
- ☐ Electric Line Location
- ☐ Lease Road Location

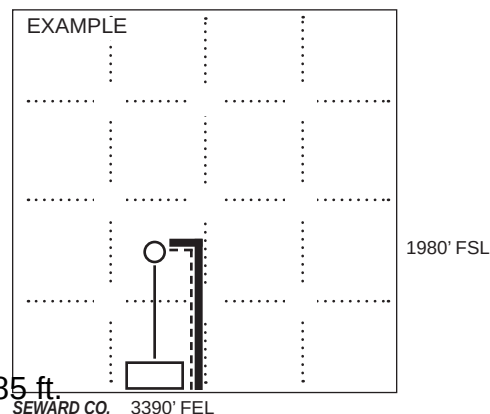**In plotting the proposed location of the well, you must show:**

- The manner in which you are using the depicted plat by identifying section lines, i.e. 1 section, 1 section with 8 surrounding sections, 4 sections, etc.
- The distance of the proposed drilling location from the south / north and east / west outside section lines.
- The distance to the nearest lease or unit boundary line (in footage).
- If proposed location is located within a prorated or spaced field a certificate of acreage attribution plat must be attached: (C0-7 for oil wells; CG-8 for gas wells).
- The predicted locations of lease roads, tank batteries, pipelines, and electrical lines.

KANSAS CORPORATION COMMISSION
OIL & GAS CONSERVATION DIVISION
APPLICATION FOR SURFACE PIT

Form CDP-1
May 2010
Form must be Typed

Submit in Duplicate

Operator Name: Eiger Operating Company, LLC		License Number: 36264	
Operator Address: 3811 TURTLE CREEK BLVD SUITE 975		DALLAS TX 75219	
Contact Person: CASI RENFRO		Phone Number: 469-568-1716	
Lease Name & Well No.: SUNFLOWER 33-2		Pit Location (QQQQ): W2 - SW - SW - SE Sec. 33 Twp. 24 R. 33 ☐ East ☒ West 330 Feet from ☐ North / ☒ South Line of Section 2385 Feet from ☒ East / ☐ West Line of Section Finney County	
Type of Pit: ☐ Emergency Pit ☐ Burn Pit ☐ Settling Pit ☒ Drilling Pit ☐ Workover Pit ☐ Haul-Off Pit <small>(If WP Supply API No. or Year Drilled)</small>	Pit is: ☒ Proposed ☐ Existing If Existing, date constructed: _____ Pit capacity: 20000 (bbls)		
Is the pit located in a Sensitive Ground Water Area? ☒ Yes ☐ No		Chloride concentration: _____ mg/l <small>(For Emergency Pits and Settling Pits only)</small>	
Is the bottom below ground level? ☒ Yes ☐ No	Artificial Liner? ☐ Yes ☒ No	How is the pit lined if a plastic liner is not used? BENTONITE AND CUTTINGS	
Pit dimensions (all but working pits): 150 Length (feet) 150 Width (feet) ☐ N/A: Steel Pits Depth from ground level to deepest point: 5 (feet) ☐ No Pit			
If the pit is lined give a brief description of the liner material, thickness and installation procedure.		Describe procedures for periodic maintenance and determining liner integrity, including any special monitoring.	
Distance to nearest water well within one-mile of pit: 2725 feet Depth of water well 300 feet		Depth to shallowest fresh water 95 feet. Source of information: ☐ measured ☐ well owner ☐ electric log ☒ KDWR	
Emergency, Settling and Burn Pits ONLY: Producing Formation: _____ Number of producing wells on lease: _____ Barrels of fluid produced daily: _____ Does the slope from the tank battery allow all spilled fluids to flow into the pit? ☐ Yes ☐ No		Drilling, Workover and Haul-Off Pits ONLY: Type of material utilized in drilling/workover: FRESH WATER MUD Number of working pits to be utilized: 1 Abandonment procedure: EVAPORATION AND BACKFILL _____ Drill pits must be closed within 365 days of spud date.	
Submitted Electronically			

KCC OFFICE USE ONLY

☐ Liner ☐ Steel Pit ☒ RFAC ☒ RFAS
 Date Received: **09/30/2026** Permit Number: **15-055-22660-01-00** Permit Date: **10/02/2026** Lease Inspection: ☒ Yes ☐ No

KANSAS CORPORATION COMMISSION
OIL & GAS CONSERVATION DIVISION

Form KSONA-1

July 2021

Form Must Be Typed

Form must be Signed

All blanks must be Filled

CERTIFICATION OF COMPLIANCE WITH THE KANSAS SURFACE OWNER NOTIFICATION ACT

This form must be submitted with all Forms C-1 (Notice of Intent to Drill); CB-1 (Cathodic Protection Borehole Intent); T-1 (Request for Change of Operator Transfer of Injection or Surface Pit Permit); and CP-1 (Well Plugging Application). Any such form submitted without an accompanying Form KSONA-1 will be returned.

Select the corresponding form being filed: ☒ **C-1** (Intent) ☐ **CB-1** (Cathodic Protection Borehole Intent) ☐ **T-1** (Transfer) ☐ **CP-1** (Plugging Application)

OPERATOR: License # 36264
Name: Eiger Operating Company, LLC
Address 1: 3811 TURTLE CREEK BLVD SUITE 975
Address 2: _____
City: DALLAS State: TX Zip: 75219 + 4784 _____
Contact Person: CASI RENFRO
Phone: (469) 568-1716 Fax: (_____) _____
Email Address: _____

Well Location:
W2 SW SW SE Sec. 33 Twp. 24 S. R. 33 ☐ East ☒ West
County: Finney
Lease Name: SUNFLOWER Well #: 33-2
If filing a Form T-1 for multiple wells on a lease, enter the legal description of the lease below:

Surface Owner Information:

Name: CIRCLE LAND AND CATTLE CORPORATION
Address 1: 955 S CIRCLE LAND RD
Address 2: _____
City: GARDEN CITY State: KS Zip: 67846 + _____

When filing a Form T-1 involving multiple surface owners, attach an additional sheet listing all of the information to the left for each surface owner. Surface owner information can be found in the records of the register of deeds for the county, and in the real estate property tax records of the county treasurer.

If this form is being submitted with a Form C-1 (Intent) or CB-1 (Cathodic Protection Borehole Intent), you must supply the surface owners and the KCC with a plat showing the predicted locations of lease roads, tank batteries, pipelines, and electrical lines. The locations shown on the plat are preliminary non-binding estimates. The locations may be entered on the Form C-1 plat, Form CB-1 plat, or a separate plat may be submitted.


Select one of the following:

- ☒ I certify that, pursuant to the Kansas Surface Owner Notice Act (see Chapter 55 of the Kansas Statutes Annotated), I have provided the following to the surface owner(s) of the land upon which the subject well is or will be located: 1) a copy of the Form C-1, Form CB-1, Form T-1, or Form CP-1 that I am filing in connection with this form; 2) if the form being filed is a Form C-1 or Form CB-1, the plat(s) required by this form; and 3) my operator name, address, phone number, fax, and email address.
- ☐ I have not provided this information to the surface owner(s). I acknowledge that, because I have not provided this information, the KCC will be required to send this information to the surface owner(s). To mitigate the additional cost of the KCC performing this task, I acknowledge that I must provide the name and address of the surface owner by filling out the top section of this form and that I am being charged a \$30.00 handling fee, payable to the KCC, which is enclosed with this form.

If choosing the second option, submit payment of the \$30.00 handling fee with this form. If the fee is not received with this form, the KSONA-1 form and the associated Form C-1, Form CB-1, Form T-1, or Form CP-1 will be returned.

I Submitted Electronically

I

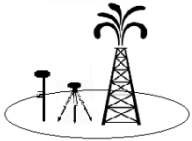

00-24s-33w-2022
CRD NO.

24s-33w
DMT NO.

PRO-STAKE LLC

Oil field & Construction Site Staking

P.O. Box 1575
Leoti, Ks. 67861
Jay Koehn: 620-874-0022
jay@prostakellc.com

20734
INVOICE NO.



Eiger Operating Company, LLC
OPERATOR

Sunflower 33-2
WELL NAME

Finney Co. KS
COUNTY

2910.6'
GR ELEVATION @ SURFACE LOCATION

SCALE: 1" = 1000'
DATE STAKED: Sept. 23, 2026
MEASURED BY: Jay K.
DRAWN BY: Jay K.
AUTHORIZED BY: Sean M.

LEGEND


- irr. well
- water hydrant
- tank battery
- staked loc.
- prod. well / aband. well
- house
- building
- gas line
- water line
- transmission powerline
- 3 phase powerline
- single phase powerline
- fence
- gravel / sand rd.
- gravel trail / lease rd.
- dirt rd.
- dirt trail / lease rd.
- Hwy / blacktop rd.


DIRECTIONS: Beginning at the intersection of Kansas Ave/Hwy 156 & Main St./Hwy 83 Bus. In Garden City, KS. - proceed SSW on Main St./Hwy 83 Bus. for 1.57 miles - turn right onto Sagebrush Rd and proceed westerly for 4 miles - turn left onto unnamed trail road and proceed south for 2.5 miles - from this point, the staked surface location is approximately 235' east in unfarmed crop circle corner

Final ingress must be verified with landowner or operator.

*This drawing does not constitute a monumented survey or a land survey plat.
This drawing is for construction purposes only.*

SURFACE LOCATION	TARGET BOTTOM HOLE
330' FSL - 2385' FEL Sec. 33-T24S-R33W	844' FSL - 2270' FEL Sec. 33-T24S-R33W
NAD 83 LAT: 37.917807° LONG: -100.946668°	NAD 83 LAT: 37.919219° LONG: -100.946277°
NAD 27 LAT: 37.917783° LONG: -100.946225°	NAD 27 LAT: 37.9191954978° LONG: -100.9458343407°
SPCS NAD 27 KS-S NORTHING/Y: 464806.03 EASTING/X: 1294409.19	SPCS NAD 27 KS-S NORTHING/Y: 465317.25 EASTING/X: 1294535.30

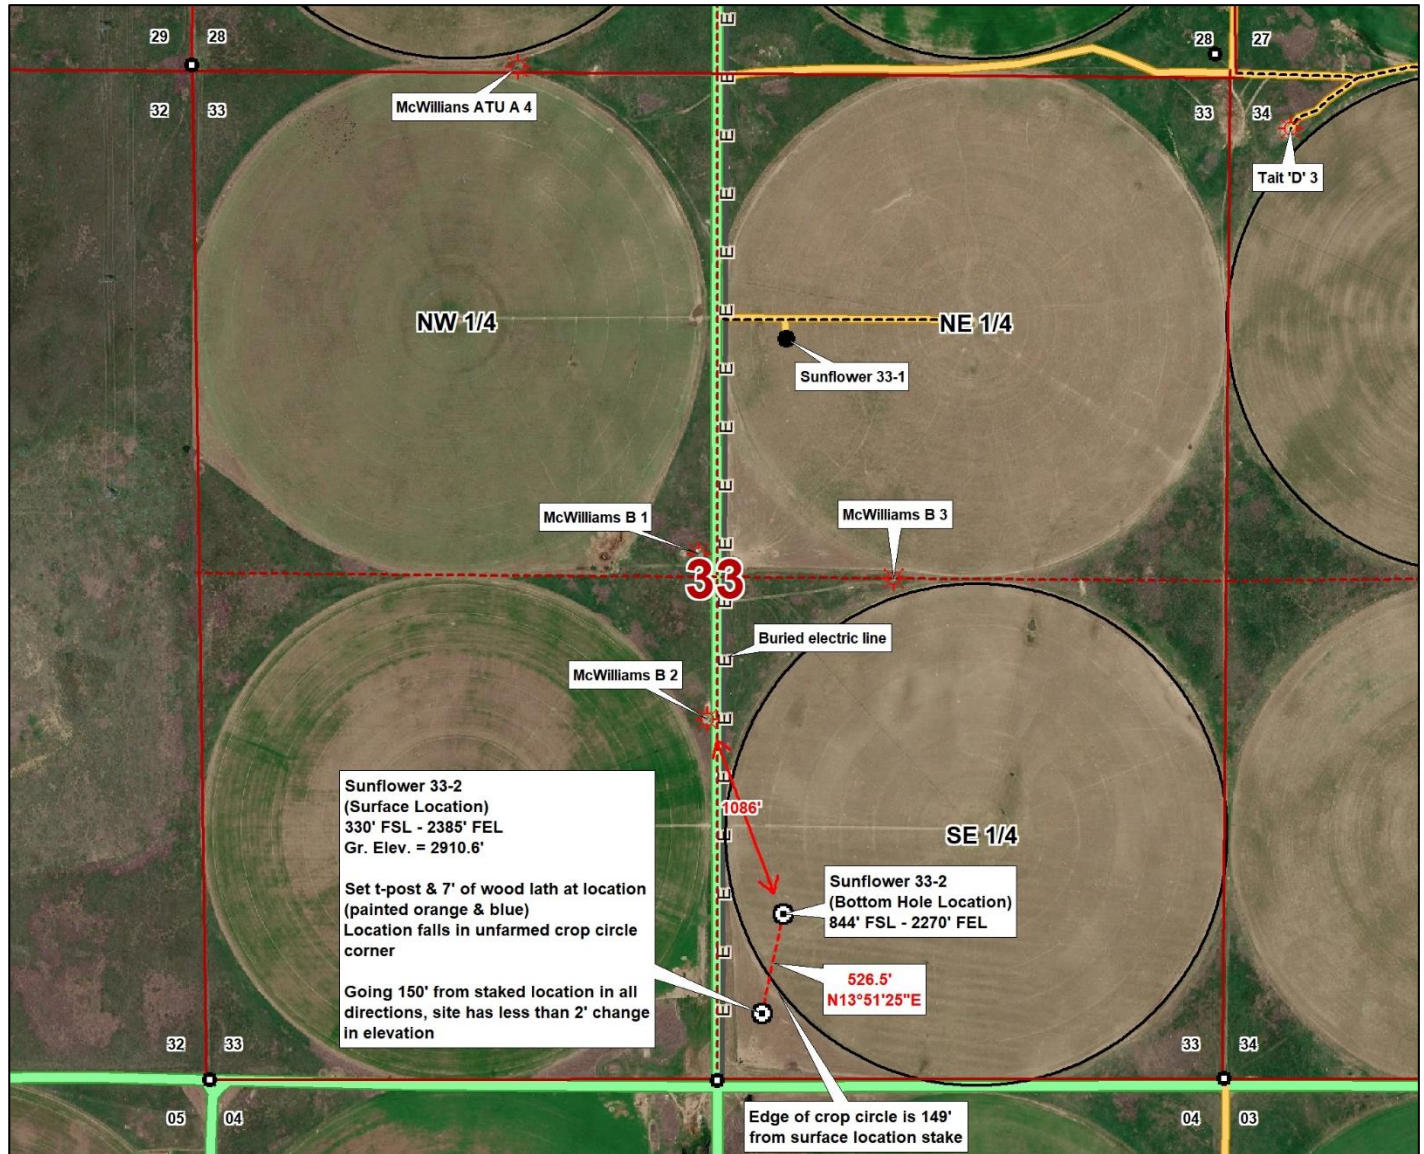

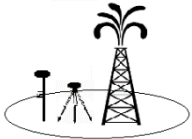

00-24s-33w-2022
CRD NO.

24s-33w
DMT NO.

PRO-STAKE LLC

Oil field & Construction Site Staking

20734
INVOICE NO.



Eiger Operating Company, LLC

OPERATOR

Sunflower 33-2

WELL NAME

Finney Co. KS

COUNTY

2910.6'

GR ELEVATION @ SURFACE LOCATION

P.O. Box 1575
Leoti, Ks. 67861
Jay Koehn: 620-874-0022
jay@prostakellc.com

SCALE: 1" = 1000'
DATE STAKED: Sept. 23, 2026
MEASURED BY: Jay K.
DRAWN BY: Jay K.
AUTHORIZED BY: Sean M.

LEGEND


- irr. well
- water hydrant
- tank battery
- staked loc.
- prod. well / aband. well
- house
- building
- gas line
- water line
- transmission powerline
- 3 phase powerline
- single phase powerline
- fence
- gravel / sand rd.
- gravel trail / lease rd.
- dirt rd.
- dirt trail / lease rd.
- Hwy / blacktop rd.


DIRECTIONS: Beginning at the intersection of Kansas Ave/Hwy 156 & Main St./Hwy 83 Bus. In Garden City, KS. - proceed SSW on Main St./Hwy 83 Bus. for 1.57 miles - turn right onto Sagebrush Rd and proceed westerly for 4 miles - turn left onto unnamed trail road and proceed south for 2.5 miles - from this point, the staked surface location is approximately 235' east in unfarmed crop circle corner

Final ingress must be verified with landowner or operator.

*This drawing does not constitute a monumented survey or a land survey plat.
This drawing is for construction purposes only.*

SURFACE LOCATION	TARGET BOTTOM HOLE
330' FSL - 2385' FEL Sec. 33-T24S-R33W	844' FSL - 2270' FEL Sec. 33-T24S-R33W
NAD 83 LAT: 37.917807° LONG: -100.946668°	NAD 83 LAT: 37.919219° LONG: -100.946277°
NAD 27 LAT: 37.917783° LONG: -100.946225°	NAD 27 LAT: 37.9191954978° LONG: -100.9458343407°
SPCS NAD 27 KS-S NORTHING/Y: 464806.03 EASTING/X: 1294409.19	SPCS NAD 27 KS-S NORTHING/Y: 465317.25 EASTING/X: 1294535.30

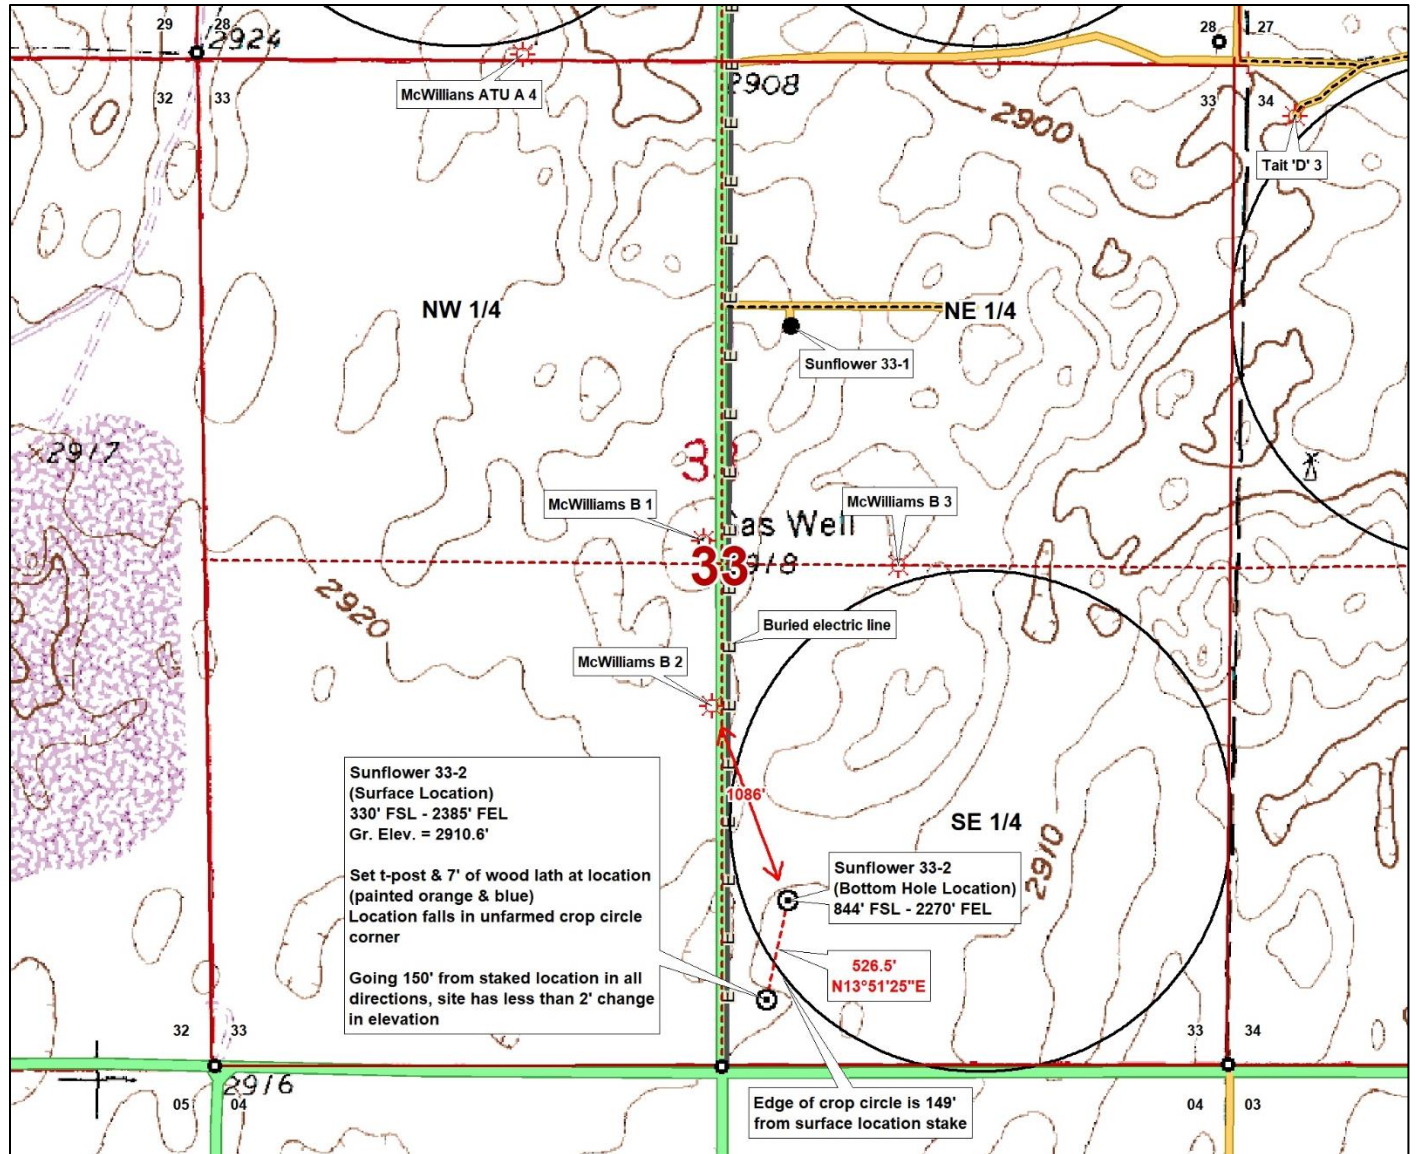

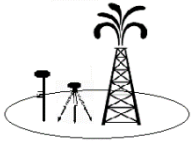

00-24s-33w-2022
CRD NO.

24s-33w
DMT NO.

PRO-STAKE LLC

Oil field & Construction Site Staking

20734
INVOICE NO.



Eiger Operating Company, LLC
OPERATOR

Sunflower 33-2
WELL NAME

Finney Co. KS
COUNTY

2910.6'
GR ELEVATION @ SURFACE LOCATION

P.O. Box 1575
Leoti, Ks. 67861
Jay Koehn: 620-874-0022
jay@prostakellc.com

SCALE: N/A
DATE STAKED: Sept. 23, 2026
MEASURED BY: Jay K.
DRAWN BY: Jay K.
AUTHORIZED BY: Sean M.

LEGEND


- irr. well
- water hydrant
- tank battery
- staked loc.
- prod. well/aband. well
- house
- building
- gas line
- water line
- transmission powerline
- 3 phase powerline
- single phase powerline
- fence
- gravel/sand rd.
- gravel trail/lease rd.
- dirt rd.
- dirt trail/lease rd.
- Hwy/blacktop rd.

DIRECTIONS: Beginning at the intersection of Kansas Ave/Hwy 156 & Main St./Hwy 83 Bus. In Garden City, KS. – proceed SSW on Main St./Hwy 83 Bus. for 1.57 miles – turn right onto Sagebrush Rd and proceed westerly for 4 miles – turn left onto unnamed trail road and proceed south for 2.5 miles – from this point, the staked surface location is approximately 235' east in unfarmed crop circle corner

Final ingress must be verified with landowner or operator.


*This drawing does not constitute a monumented survey or a land survey plat.
This drawing is for construction purposes only.*

SURFACE LOCATION	TARGET BOTTOM HOLE
330' FSL - 2385' FEL Sec. 33-T24S-R33W	844' FSL - 2270' FEL Sec. 33-T24S-R33W
NAD 83 LAT: 37.917807° LONG: -100.946668°	NAD 83 LAT: 37.919219° LONG: -100.946277°
NAD 27 LAT: 37.917783° LONG: -100.946225°	NAD 27 LAT: 37.9191954978° LONG: -100.9458343407°
SPCS NAD 27 KS-S NORTHING/Y: 464806.03 EASTING/X: 1294409.19	SPCS NAD 27 KS-S NORTHING/Y: 465317.25 EASTING/X: 1294535.30

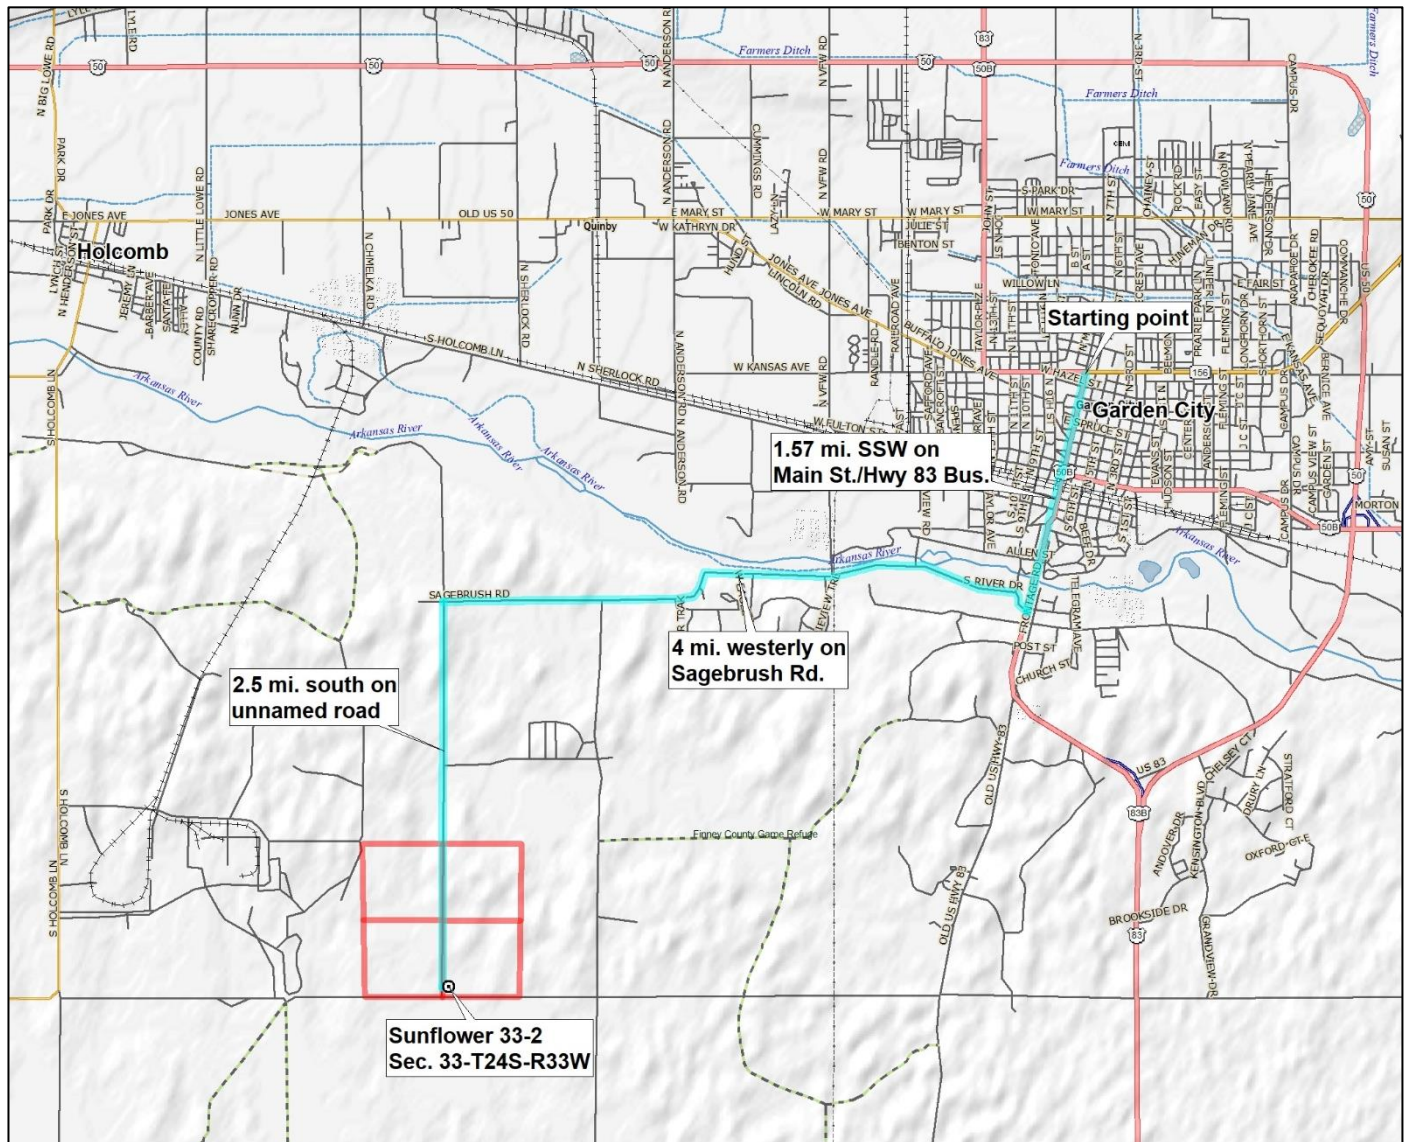

SE 1/4 SECTION 33 TOWNSHIP 24S RANGE 33W MAP NO. _____ DIAGRAM NO. _____
 COUNTY Finney JOB ORDER NO. _____ SHEET NO. _____
 STATE Kansas SYSTEM NAME _____ DISTRICT Garden City
 MEASURED BY Cody Kinnier DATE 9-28-26 FARM Sunflower 33-2

SIZE OF PIPE	___ INCH	___ INCH	___ INCH	___ INCH	___ INCH	___ INCH	___ INCH	___ INCH	___ INCH
LAST TOTAL					ABOVE GROUND				
LIFTED					EARTH				
BALANCE					PICK ROCK				
LAIID					SHOOT ROCK				
NEW TOTAL					CLEARING				

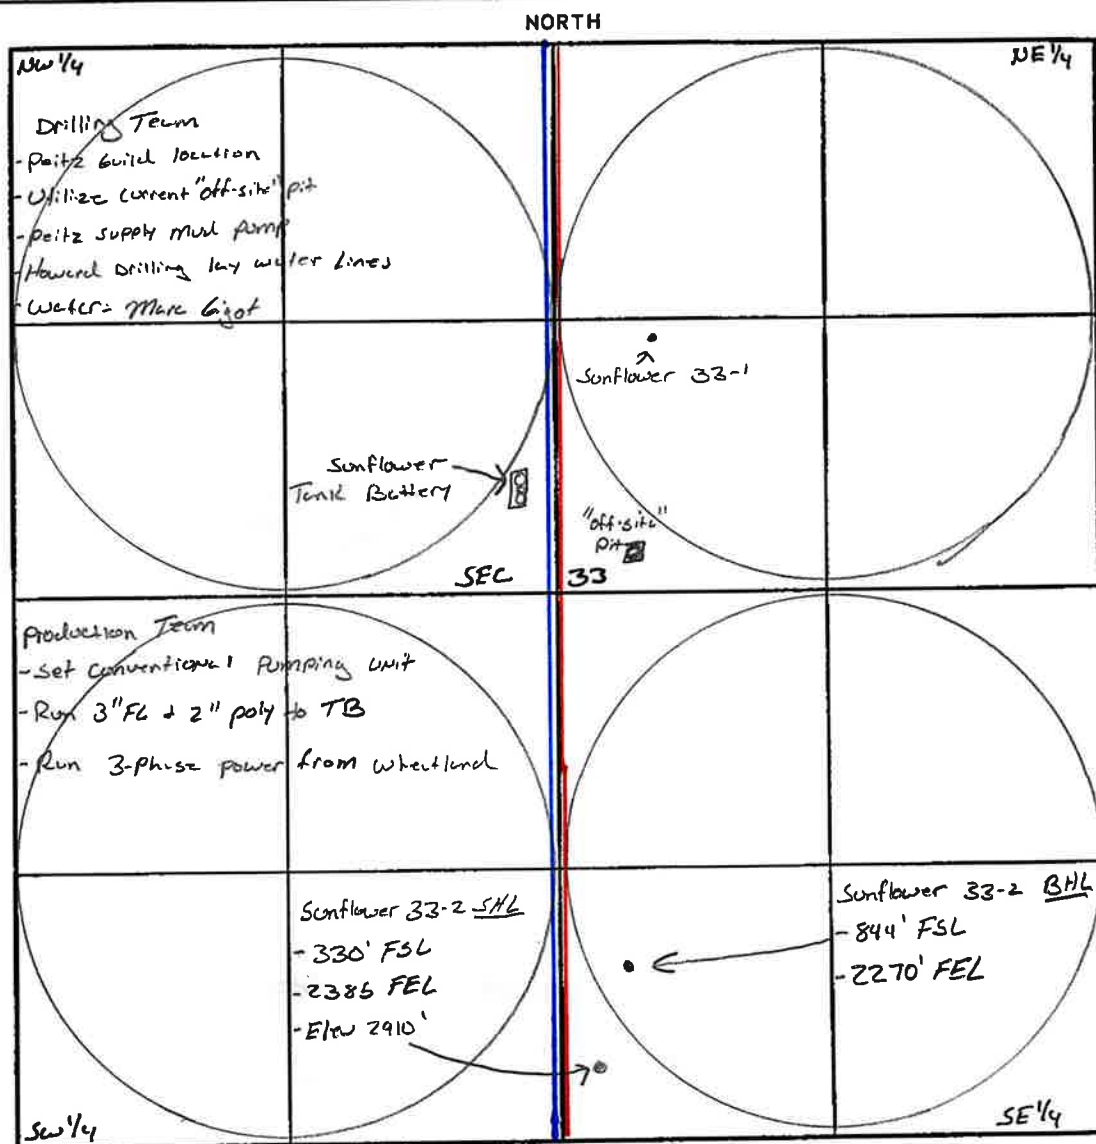

REMARKS From intersection of Business 83 + Sagebrush road. Proceed westerly for 1/4 miles. Turn left onto trail road + proceed south for 2 1/2 miles. From this point, the skid row surface location is approx 235' past.

NOTICE

Nearest Lease or Unit Boundary Line

K.A.R. 82-3-108 provides that all oil and gas well locations must comply with setback requirements, unless an exception has been granted by the Commission. Depending upon whether the subject well is an oil well or gas well, and also depending upon the county in which the well is located, the setback may be 330 feet or 165 feet from the nearest lease or unit boundary.

This Intent to Drill (“C-1”) form indicates that the distance between the well and the nearest lease or unit boundary will comply with the setback requirement. Accordingly, the C-1 has been approved. However, the C-1 also stated that the well location is very near a boundary line of a Section or a Quarter-Section. This notice is being sent as a courtesy reminder, in case an error was made on the C-1.

As the operator of the proposed well, you must independently verify that the proposed well location complies with the applicable regulatory setback. If at any time it should appear that a well does not comply with the regulatory setback, the well may be subject to being shut-in pending Commission approval of an application for a well location exception. In addition, if such an application is not granted by the Commission, you may be required to plug the well.

If the proposed well location will comply with the regulatory setback, this notice may be disregarded. Please contact the KCC Production Department with any questions or concerns.

Conservation Division
266 N. Main St., Ste. 220
Wichita, KS 67202-1513



Phone: 316-337-6200
Fax: 316-337-6211
<http://kcc.ks.gov/>

Andrew J. French, Chairperson
Dwight D. Keen, Commissioner
Annie Kuether, Commissioner

Laura Kelly, Governor

October 02, 2026

CASI RENFRO
Eiger Operating Company, LLC
3811 TURTLE CREEK BLVD SUITE 975
DALLAS, TX 75219-4784

Re: Drilling Pit Application
SUNFLOWER 33-2
SE/4 Sec.33-24S-33W
Finney County, Kansas

Dear CASI RENFRO:

District staff has inspected the above referenced location and has determined that an unsealed condition will present a pollution threat to water resources.

District staff has recommended that the reserve pit be lined with bentonite or native clay, constructed **without slots**, the bottom shall be flat and reasonably level and the free fluids must be removed. The fluids are to be removed from the reserve pit as soon as the Hutchinson Salt section has been drilled through and displacement of the fluids into the reserve pit has occurred. The fluids should be removed again within 96 hours after drilling operations have ceased.

If production casing is set all completion fluids shall be removed from the working pits daily. NO completion fluids or non-exempt wastes shall be placed in the reserve pit.

The fluids should be taken to an authorized disposal well. Please call the District Office at (620) 682-7933 when the fluids have been removed. Please file form CDP-5 (August 2008), Exploration and Production Waste Transfer, through KOLAR within 30 days of fluid removal.

A copy of this letter should be posted in the doghouse along with the approved Intent to Drill. If you have any questions or concerns please feel free to contact the District Office at (620) 682-7933.