

WATER WELL RECORD (WWC5.2)

Constructed

KOLAR DOC ID 1985427

WELL ID MW10

LOCATION OF WATER WELL

County	Butler	Section	7	Township	27	Range	3 ☒ E ☐ W	Fraction	NE ¼ NE ¼ NE ¼
Latitude	37.7225	Longitude	-97.135912	Datum	WGS84	Elevation	1343		

WATER WELL LOCATION☒ at owner's address

2035 N Andover Rd, Andover, KS

WATER WELL OWNER

Name	
Business	Presta Oil Co.
Address	31320 Hedge Lane
	Paola KS 66071

PERMIT & ID NUMBERS (AS REQUIRED)

DWR Application No.: _____

KDHE / EPA Project Code: U2-008-13088

Site Name: Presto #16

KDHE UIC Class V Form Completed: ☐ Yes ☐ No

County/Local Permit Required? ☐ Yes ☐ No

Permit Obtained? ☐ Yes ☐ No Permit ID: _____

Oil/Gas Lease Name & Well #: _____

CONSTRUCTION

Casing: Height above land surface: -4.08 in.

Is casing height less than 12 inches? ☒ Yes ☐ No

Blank Casing type: ThermalPlastic

1st interval: 0 ft. to 10 ft.; Diameter 2 in.

Casing Joint: : Threaded Weight: _____ lbs/ft

Wall thickness or gauge no.: 0.154

2nd interval: _____ ft. to _____ ft.; Diameter _____ in.

Casing Joint: : _____ Weight: _____ lbs/ft

Wall thickness or gauge no.: _____

3rd interval: _____ ft. to _____ ft.; Diameter _____ in.

Casing Joint: : _____ Weight: _____ lbs/ft

Wall thickness or gauge no.: _____

Screen / Perforation material: PVC

Specify if other: _____

Screen / Perforation openings: Mill slot

1st interval 10 ft. to 25 ft. Slot Size _____

2nd interval _____ ft. to _____ ft. Slot Size _____

3rd interval _____ ft. to _____ ft. Slot Size _____

WELL WATER USE

Environmental Remediation / Monitoring Monitoring

Additional info if required:

of Boreholes _____ # of Dewatering Wells _____

COMPLETION

Depth of completed well: 25 ft.

Depth(s) groundwater encountered: ☐ Dry Well

(1) _____ ft.; (2) _____ ft.; (3) _____ ft.;

Static water level in well: 13.68 ft.

Date measured: 08/13/2026

Measured from: ☒ Top of Casing or ☐ Ground SurfaceMeasured: ☐ Above or ☒ Below Land Surface

Estimated yield: _____ gpm

Pump Test Date: Water level was:

_____ ft. after _____ hours pumping _____ gpm

_____ ft. after _____ hours pumping _____ gpm

Pump Information:Pump Installed? ☐ Yes ☒ No Date: _____

Pump Type: _____ Horsepower: _____ Volts: _____

Drop Pipe Diameter: _____ in. Drop Pipe Length: _____ ft.

Water well disinfected? ☐ Yes ☐ No

Date disinfected (mm/dd/yy): _____

CONSTRUCTION**Borehole interval:**

from 0 to 25 ft.

from _____ to _____ ft.

from _____ to _____ ft..

Borehole diameter:

7.25 in.

_____ in.

_____ in.

Grout:

1st Interval: 0 ft. to 1 ft. Grout material: Cement


2nd Interval: 1 ft. to 8 ft. Grout material: Bentonite

3rd Interval: _____ ft. to _____ ft. Grout material: _____

Gravel pack:

Not Used

1st Interval: 8 ft. to 25 ft. Gravel Size: _____ ☐2nd Interval: _____ ft. to _____ ft. Gravel Size: _____ ☐3rd Interval: _____ ft. to _____ ft. Gravel Size: _____ ☐**DESIGNATED PERSON** Colin Groves**WELL COMPLETION DATE** 08/11/2026**CONTRACTOR BUSINESS NAME** Larsen And Associates

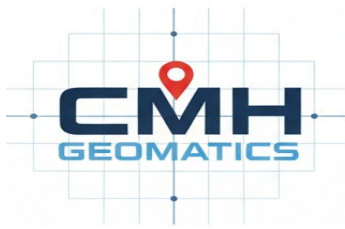

CMH Geomatics, LLC
1917 SW Medford Ave., Topeka, KS 66604
(785) 979-0372
chumphrey@cmhgeomatics.com

Jess Chapman
Larsen & Associates
1311 E. 25th Street, Suite B
Lawrence, Kansas 66046

September 23, 2026

Re: Project No. T26-001-LAA-021 Monitor Well Location and Elevation Survey, Presto #16 2035 N. Andover Rd., Andover, KS.
KDHE ID: U2-008-13088

Point	Location	Distance North of SE Cor.	Distance West of SE Cor.	Elev. Top of Rim	Elev. Top of Pipe	Latitude	Longitude
MW 10	NE1/4 NE1/4 NE1/4 SW1/4	5057.01	292.92	1342.99	1342.65	37.722500	-97.135912
MW 11	NE1/4 NE1/4 NE1/4 SW1/4	4933.98	153.08	1341.69	1341.43	37.722200	-97.135435
MW 12	NW1/4 NW1/4 NW1/4 SE1/4	4997.82	2.63	1341.23	1340.76	37.722300	-97.134912
Site Benchmark Elevation =		5267.48	200.78	1340.05			

Project Information:


All Measured distances taken from the Southwest Corner of Section 7, Township 27 South, Range 3 East of the 6th P.M.


Vertical measurements were taken in NAVD 88 and established from NGS monument PID HF0451 Designation U 39.

Site Benchmark – Set Chiseled Square at the Northeast corner of curb inlet located East of the concrete drive at the North entrance of Presto #16.


Set Notches on North side of Top Rim and on the North side of Pipe.

I found several issues with the previous survey. I found the NGS monument about 2 miles away from the site. The previous survey had assumed an elevation for the “Control Point”, said Control Point has been removed. I set a new site benchmark as described above. The assumed elevation of 100.00' = 1341.44'

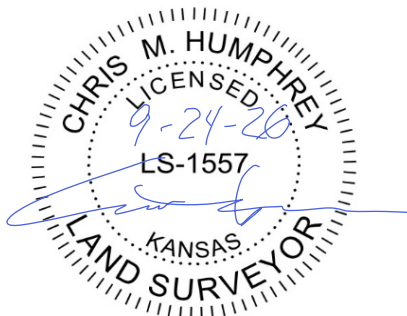

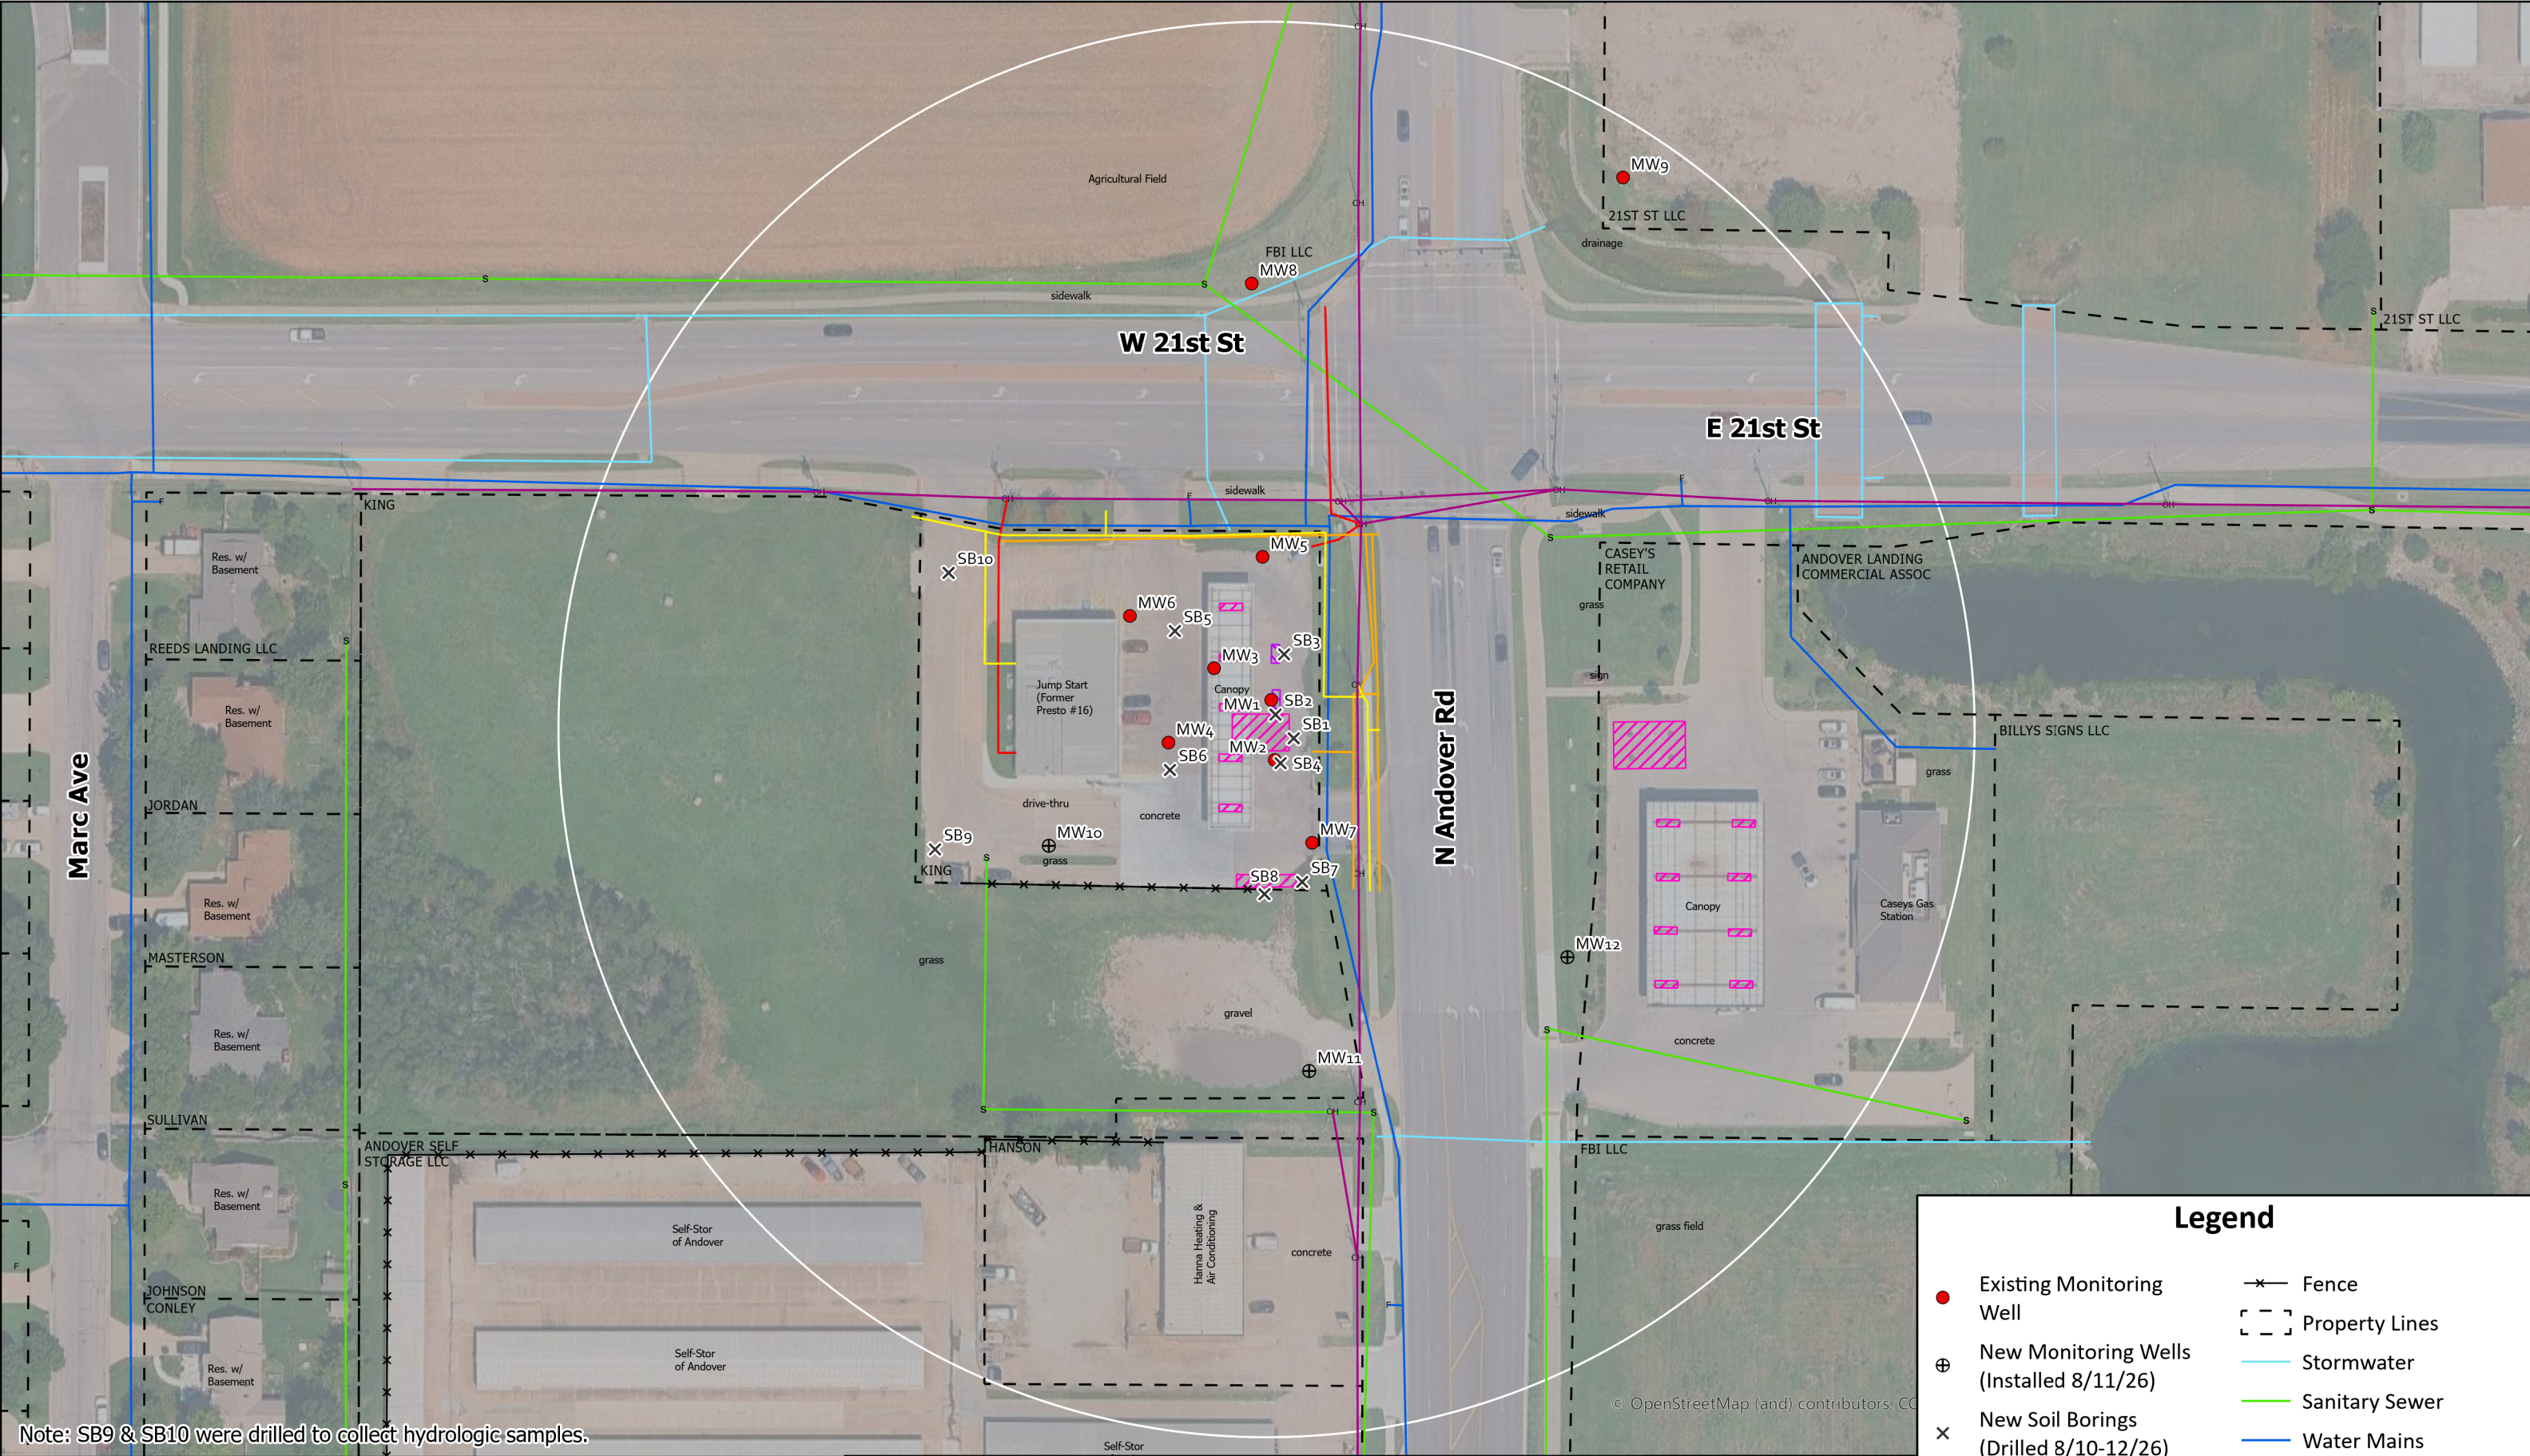

Note: SB9 & SB10 were drilled to collect hydrologic samples.

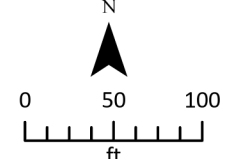 Environmental Services by Larsen & Associates, Inc. 1311 E 25th St., Ste B, Lawrence, KS 66046 Office: (785) 841-8707	Site Name: Presto #16 2035 N. Andover Rd., Andover KS KDHE ID: U2-008-13088	Fig ID: 2.2 Date: 8/12-13/26 Drawn By: PC	500 FT RADIUS AREA BASE MAP NOTE: All boundaries and locations are approximate.	 Estimated Groundwater Flow Direction	 0 50 100 ft	Legend - Existing Monitoring Well - New Monitoring Wells (Installed 8/11/26) - New Soil Borings (Drilled 8/10-12/26) - Active Pump Island and UST Basin - Former Pump Islands - Fence - Property Lines - Stormwater - Sanitary Sewer - Water Mains - Overhead Power Lines - Gas - Telecom - Electric