

Morton


FORM 51

KANSAS

Section 36 Township 33 Range 43W

Well No. #1 USA-Boice

Company Amerada Pet.

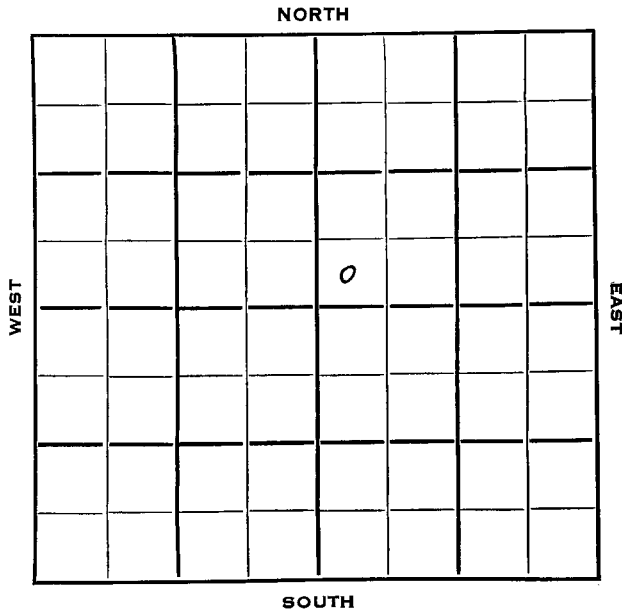

SEC.	TWP.	R.
36	33	43W ✓

WELL NO.

#1 USA-Boice

FARM

COMPANY

Amerada Petroleum

CONTRACTOR

Peel Drlg.

Greenwood Gas Pool

NORTH

Ft. from N. Line


330

Ft. from S. Line

Ft. from E. Line

330

Ft. from W. Line

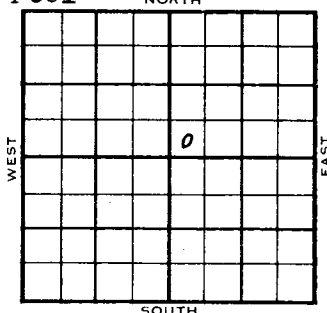

SW SW NE

ELEVATION

REPORT

1954

3587'

2/3

Spud 1-30-54
8" @ 603'
WOC.

2/10

Pipe Stuck @ 1565'

2/17

Drlg 1790'

2/24

Anhy 1355', Top 2873' Lans 3138'
RTD 3320'
5" @ 3299'

3/3

CO 3250
24/ 3238-44 48/ 3210-22 2000 A
B/ 10 bswph 4 hrs. sq. PB 3195'
48/ 3146-58 1000 A S/ 3 bswph
/ 163,000' gas,
PB 3084'

/17

Spud 1-30-54 Gas well TD 3320
8" @ 603 Anhy 1355 Top 2873
Lans. 3138 TD 3320 5" @ 3299
CO to 3252 24/3238-44 48/3210-22
2000 A B/10 BSWPH 4 hr. SP 3195
48/3146-58 1000 A S/3 BSWPH
163,000 gas. PB 3084 232/3014-72
5000 A 1,492,000 gas SP 3000
Perf 2895-2982 2950-58 2942-50
6000 A 5,736,000 gas 2000 A
CO to 3082 6,581,000 gas 15,000 A
Comp. shut in gas well 6,448,000 gas.

County **Morton** State **Kansas**

Sec. **36** (Blk. Twp.) **33** (Sur. Rge.) **43W** Map No.

Operator **Amerada Petroleum**

Well No. **1** Farm **USA-Boice**

Elev.	Location	SW	S	W	NE
-------	----------	----	---	---	----

FIRST REPORT

330 Ft. From **S** Line **NE**

330 Ft. From W Line Quarter

1st. Report FEB 3 1954

Completion

Remarks

Peel Drlg. - Contr.

Spudding Date **1-30-54**

Orig. Data **Greenwood Gas Pool**

8" 603 WOC

























J. G. McGEHEE