

1st 24 hrs. Nat.
1st 24 hrs. after shot
Gas cu. ft.
Dry Hole
Abandoned

Map No. KANSAS Sec. 6 Twp. 33 R. 39^W
 Well No. 1- Morgan Farm
Argus Gas Company


 Ft. from N. Line

1320 Ft. from S. Line

1320 Ft. from E. Line

1320 Ft. from W. Line

1930

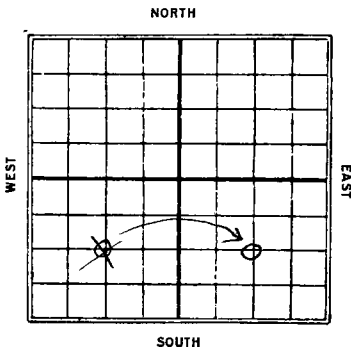

Date	REPORT
2/21	Loc.
2/28	—
2/4	—
2/11	—
2/18	Bldg. up
2/25	Argus up
2/2	hrlg. 1660'
2/9	" 2475'
2/16	just 2475'
2/23	hrlg. 2478'
2/30	show gas.
	band 2478-2750
	TD 2750
	2 M. Gas
	Corp.

Map No. KANSAS Sec. 8 Twp. 33 R. 39^w

Well No. 1- Morgan Farm

Argus Gas Company

NORTH

WEST

EAST

SOUTH

1320 Ft. from N. Line

_____ Ft. from S. Line

_____ Ft. from E. Line

1320 Ft. from W. Line

1930

Date

REPORT

5/4

Loc.

5/14

5/21

Abandoned
(bad title)

Map No. KANSAS Sec. 5 Twp. 25 R. 39W

Well No. 107, Regan

Regan, Yac Company

Contractor


SECTION PLAT

1320 Ft. from N. Line

..... Ft. from S. Line

..... Ft. from E. Line

1340 Ft. from W. Line

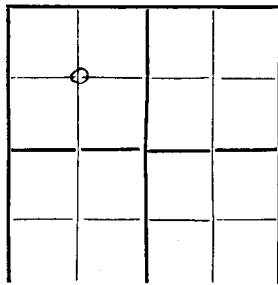

Location.....

Rig up.....

Drilling and Remarks:

RECORD

Cased.....in.,ft.

Sand.....

Gas.....

Oil.....

Total Depth.....

PRODUCTION

1st 24 hrs. Nat.....

1st 24 hrs. after shot.....

Gas.....Cu. Ft.

Dry Hole.....

Abandoned.....

Date

MAY 7 1930

192

J. J. LEWIS Scout


Map No. KANSAS Sec. 5 Twp. 33 R. 39W

Well No. 1-1-12-9-11

Argus Gas Company

Argus Gas Contractor

SECTION PLAT

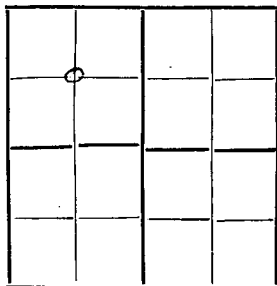

1820 Ft. from N. Line

..... Ft. from S. Line

..... Ft. from E. Line

1320 Ft. from W. Line

ABANDONED



Drilling and Remarks:

Bar. 11.78

RECORD

Cased.....in.,ft.

Sand.....

Gas.....

Oil.....

Total Depth.....

PRODUCTION

1st 24 hrs. Nat.....

1st 24 hrs. after shot.....

Gas.....Cu. Ft.

Dry Hole.....

Abandoned.....

Date

MAY 21 1912 Scout