


Section 14 Township 33 Range 41W

Well No. #1 Lackey

Company Panhandle Eastern

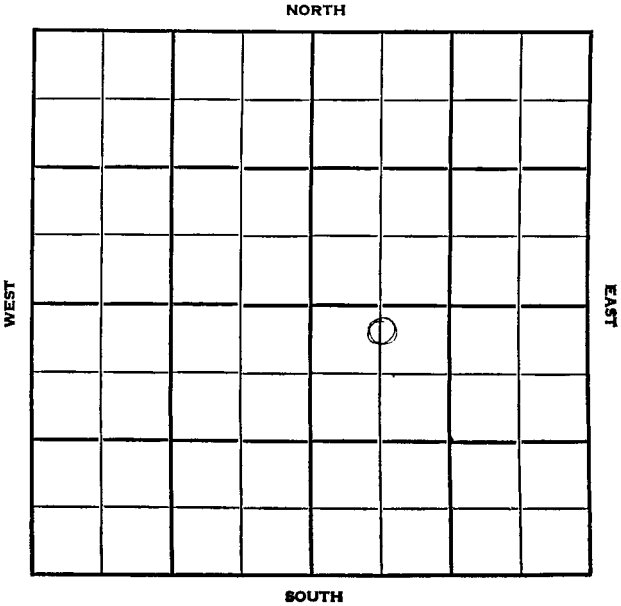

Morton

KANSAS

SEC.	TWP.	R.
14	33	41W

WELL NO.

#1 Lackey

FAR

COMPANY

Panhandle Eastern

CONTRACTOR

Garvey


Hugoton

330 FT. FROM N. LINE

FT. FROM S. LINE

FT. FROM E. LINE

530 FT. FROM W. LINE

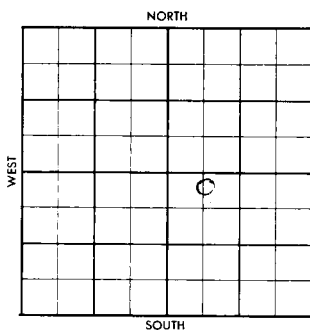C N $\frac{1}{2}$ NW SE

	ELEVATION	REPORT
1956	3377'	
6-6	Comm. 5-28-56 7" @ 441 w/125 4" @ 2348 TD 2360'	
8-29	18/2268-71 Lost Gun CO 2331 24/2265-71; 20/2252-57; Ga 496 MCF; 12/2234-37; 24/2220-26 12/2213-16; 16/2206-10; 40/2191-2201 P B 2248; ga 915 MCF; ga 1.136 MCF; CO 2331; ga 392 MCF Deliv. 715 MCFGPD; SIP 399.9 Kri! 2190'; Wfd. 2251'; TD 2360'	

COMPLETED

County Morton Elev. _____
 Sec. 14 Twp. 33 Rge. W1W
 Company Amhandle Eastern
 Farm Name Lackey No. 1

TOPS	DEPTH	LOG	DATUM	Loc. in Sec.
Anb.				<u>Q N 1/4 NW SE</u>
Tr.				<u>330' NL</u>
H.				<u>530' WL</u>
Tr.				
Dg.				
Bl.				
L.				Geol. _____
K.C.				Contr. _____
RXC.				<u>Garvey</u>
Ce.				Pool _____
C.				<u>Hageton</u>
M.				
M.				
K.				
Mz.				
Ma.				
V.				
S.				
S.				
A.				
R.				
Pe.				
G.				
TD.				

FIRST REPORT

JUN 6 '56

Date Comm. 5-28-567" @ W11/125 TD 2360 4" @ 2348

301 I I WIL

10-34

354

FORM 512 SUNRAY

County MortonElev. 3577Sec. 14Twp. 33Rge. 41WCompany Penhandle EasternFarm Name LackeyNo. 1

TOPS	DEPTH	LOG	DATUM	Loc. in Sec.
Asht				
Top <u>RPI</u>	<u>2190</u>			<u>C N¹ NW SE</u>
H. <u>WPI</u>	<u>2251</u>			<u>330' NL</u>
Tf.				<u>530' WL</u>
Dp.				
Bl.				
L.				
K.C.				
B.K.C.				
Ce.				
C.				
M.				
M.				
K.				
Me.				
Me.				
V.				
S.				
A.				
R.				
Pe.				
G.				
TD	<u>2360</u>			

Geol.

Contr.

Garvey

Pool

Huron

COMPLETE

Date Comm. 5-28-56

AUG 29 1956

7" @ 141/125

TD 2360

4" @ 2348

JUN 13 '56

WACT

JUN 20 '56

JUN 27 '56

JUL 3 '56

WOC

JUL 11 '56

JUL 18 '56

JUL 25 '56

18/2268-71

Lost Gun Co 2331

24/2265-71

20/2252-57

556

90

496

MCF 12/2234-37

24/2220-26

556 12/2213-16

16/2208-10

40/2191-2201

SEA TSTM

RB

2248

90

915

MCF

MCF Co 2331

18

90

392

MCF

FORM 512-1 SUNRAY

AUG 1 '56

AUG 8 '56

A

AUG 15 '56

AUG 22 '56

AUG 29 '56

DELIV. 715 MCF 6 PP

SIP 399.9

25-41

CHIL. HILL E