


Morton

KANSAS

SECTION 13 TOWNSHIP 33 RANGE 41W

WELL NO. #1 Sante Fe Land

COMPANY Parhandle Eastern

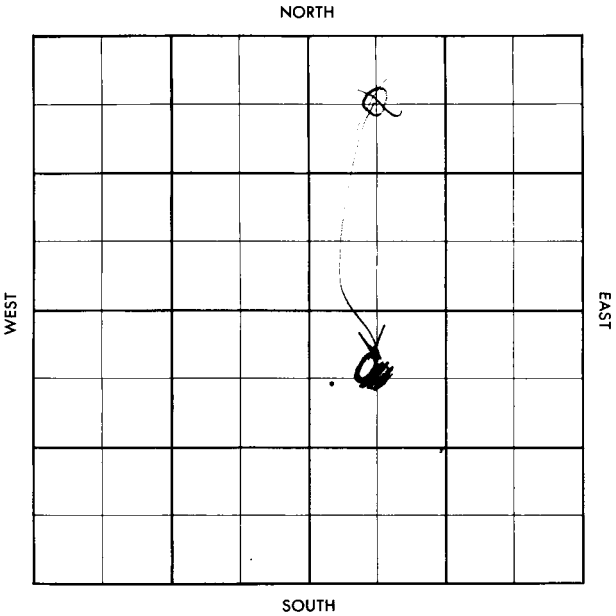

SEC.	TWP.	R.
13	33	41W

WELL NO. _____

#1 Santa Fe Land

FARM

COMPANY

Pahhandle Eastern

CONTRACTOR

Graham-Michaelis

Hugoton

Ft. from N. Line


Ft. from S. Line

Ft. from E. Line

Ft. from W. Line

C NW ~~NE~~

SE

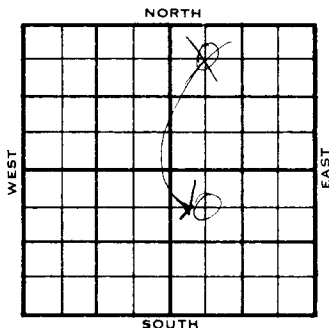

1956	ELEVATION	REPORT
5-16	3310	Comm. 5-10-56 7" @ 449 w/250 Drlg. 750
6-27		4 $\frac{1}{2}$ " @ 2352/100 CO 8/2283-85, 14/2265-76, ga 455 MCF ga 2.65 MCF, ga 3.771 MCF, PB 2258 48/2233-41, 24/2221-25, 30/2212-17 24/2203-07, tst SSG 8000 A G 4,870 MCF, 7,000 A WOT Del 1,719 MCF, AP 378 A WO tst ~~Deliv~~ tst 1,719 MCFG, 387 R.P. H. Kri. 2202; Tr. WFd 2263; Toos Log: H. Kri. 2202; Tr. WFd 2263 TD: 2360
		COMPLETED

DX-78

COMPLETED

County Monahan Elev. _____
 Sec. 13 Twp. 33 Rge. 41W
 Company Embroidle Eastern
 Farm Name Santa Fe Land No. 1

TOPS	DEPTH	LOG	DATUM
Anh			
Tr.			
H.			
Tr.			
Dg.			
Bl.			
L.			
K.C.			
B.K.C.			
Ce.			
C.			
M.			
M.			
K.			
Mz.			
Mo.			
V.			
S.			
S.			
A.			
R.			
Pe.			
G.			
TD			

Loc. in Sec. G NW NE
 Geol. _____
 Cont. Graham-Michael
 Pool Hageton

MAY 15 58
 FIRST REPORT

Date Comm. 5-10-56
7" @ 440/250 drlg. 750

YAM
 10 19

CORRECTION

FORM 513 SUNRAY

County Morton Elev. 110
 Sec. 13 Twp. 33 Rge. 41W
 Company Panhandle Eastern
 Farm Name Sante Fe Land No. 1

TOPS	DEPTH	LOG	DATUM	Loc in Sec.
Asht				C NW NE SE
TP				
H. <u>R/L</u>	<u>2202</u>	<u>2202</u>		
Tr. <u>WEd</u>	<u>2363</u>	<u>2263</u>		
Dg.				
Bl.				
L.				Geol.
K.C.				Contr.
B.K.C.				<u>Graham-Michaeli</u>
Ce.				Pool
C.				<u>Hugoton</u>
M.				
M.				
K.				
Mz.				
Ma.				
V.				
S.				
S.				
A.				
R.				
Pe.				
G.				
TD	<u>2360</u>			

Date Comm. 5-10-56 JUN 27 '56

7" @ 140/250 drl. 750 MAY 23 '56 4 1/2 @
 2352/100 MAY 29 '56 Co. 8 / 2283-85
 44/2265-76 ga 455 MCF Δ
 ga 2.65 MCF / 3 ga 3.771
 MCF PB 2258 48/2233-41
 24/2221-25 30/2212-17 24/
 2203-07 1st 556 Δ 556
 13 JUN 6 '56 8000 A G 4,870 MCF
 7000 A NOT JUN 13 '56 Do 1,719 MCF
 RD 378.12

FORM 513-1 SUNRAY

13-33-4W

CNW SE

JUN 27 '58

WO tst

JUN 27 '58

deliv. tst

1.719 MCF

~~RB~~ 387

RP.